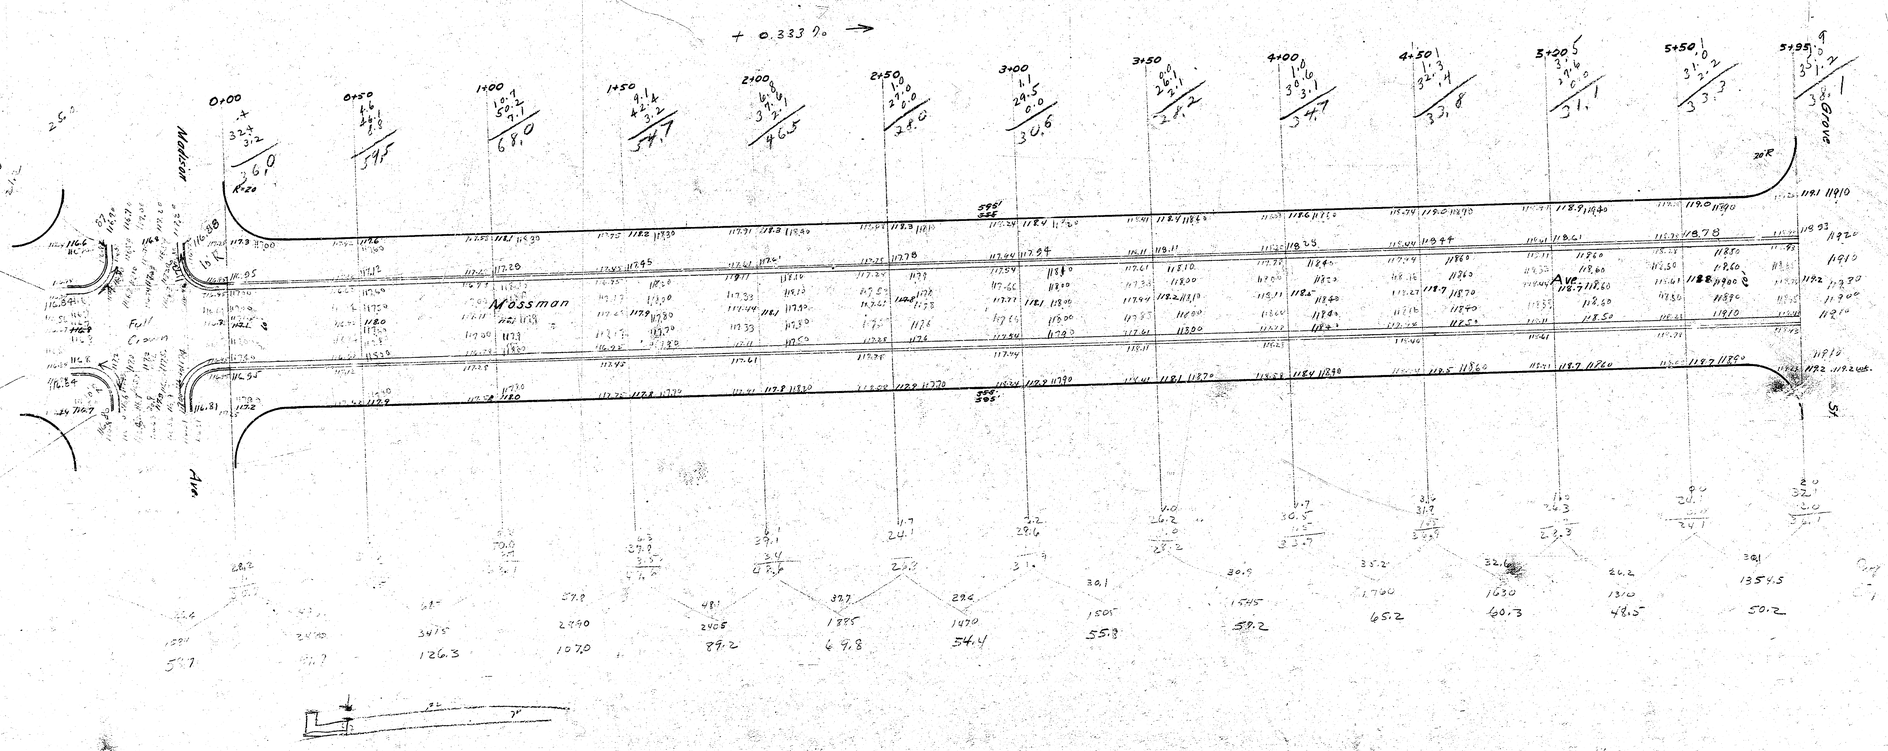MOSSMAN W.L. GROVE TO W.L. MADISON Curb & Gutter 2" Asphalt on 5" Conc Base.
B.M. 115.31 "B" in Bolt back of Wk. N. N.W. Cor. Platte & 91st