



B.M. 159.16 RR Spike in north face of power pole at White Oak Drive and 6' South of south line of Cedar Lakes Village 4th Addition.

Scale : 1" = 20'

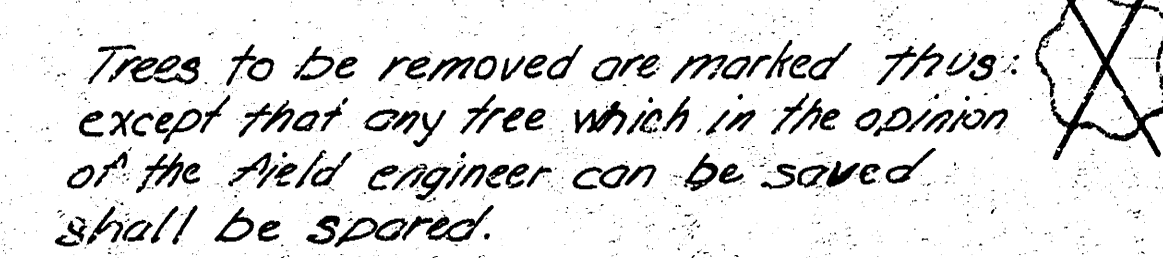


N.L.MT.Vernon to and including Cul-de-Sac
(For lots 65-75, Block 3, Cedar Lakes Village 4th Addit

DAKS 574132

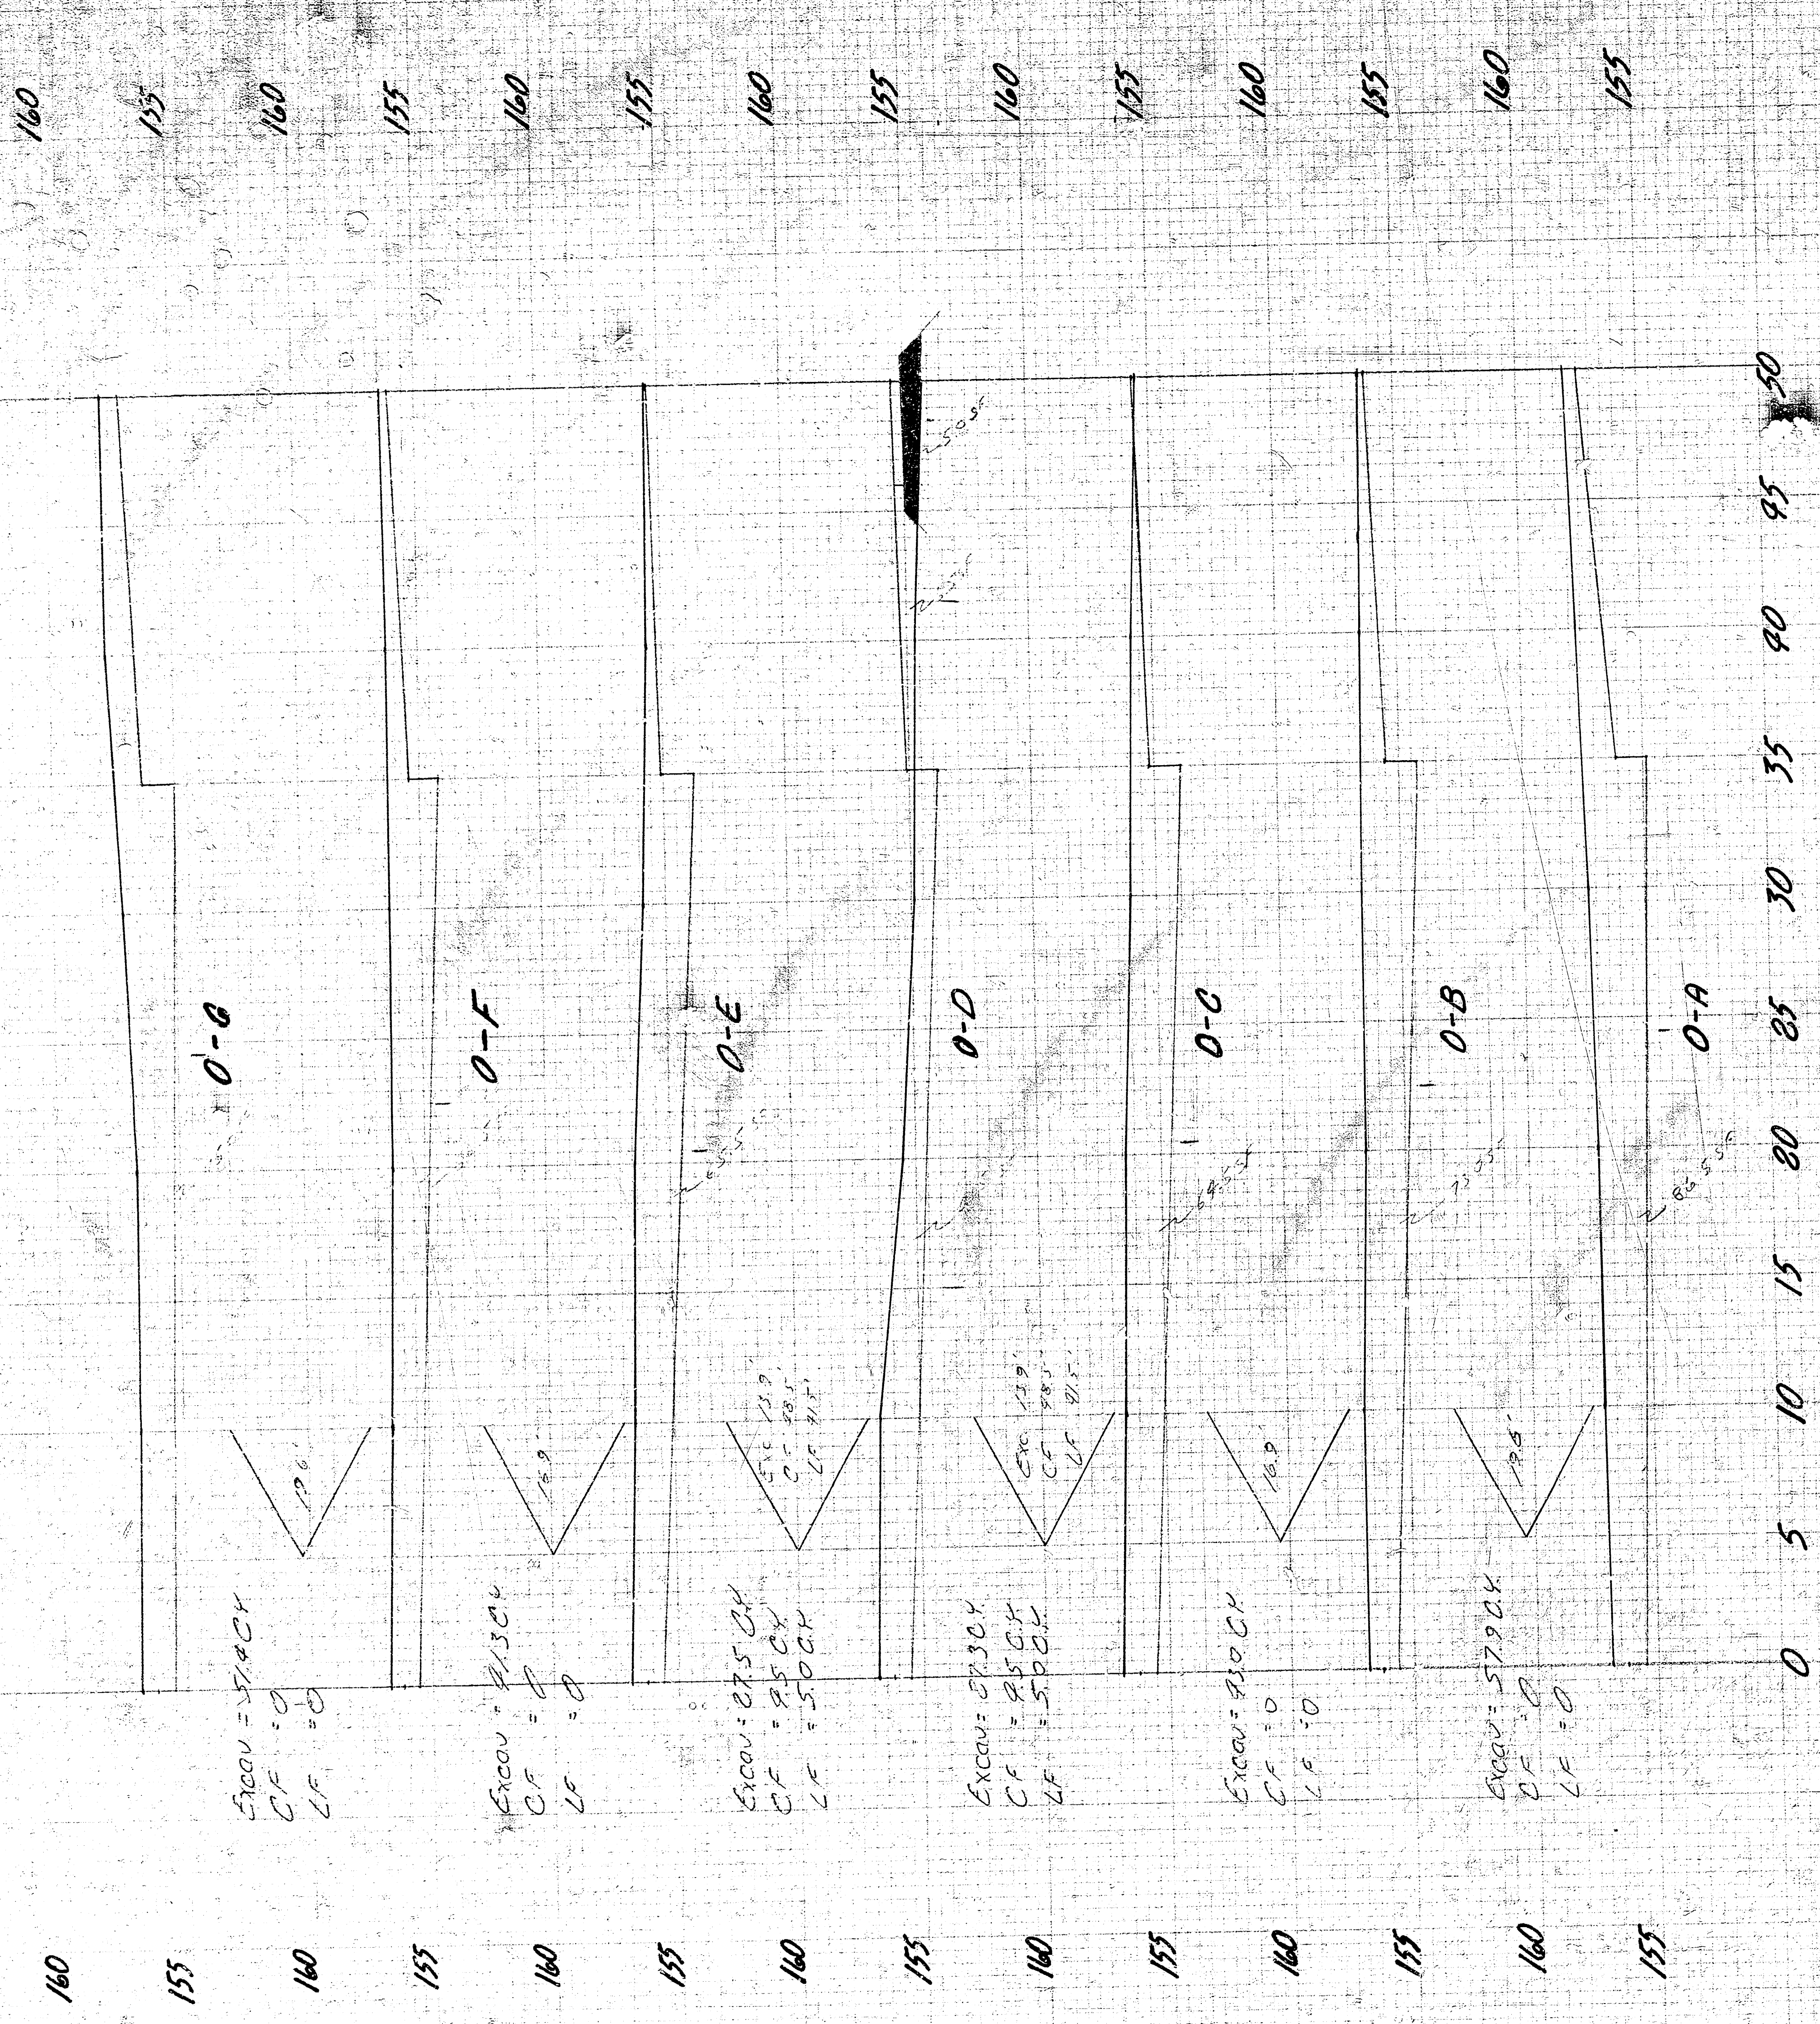


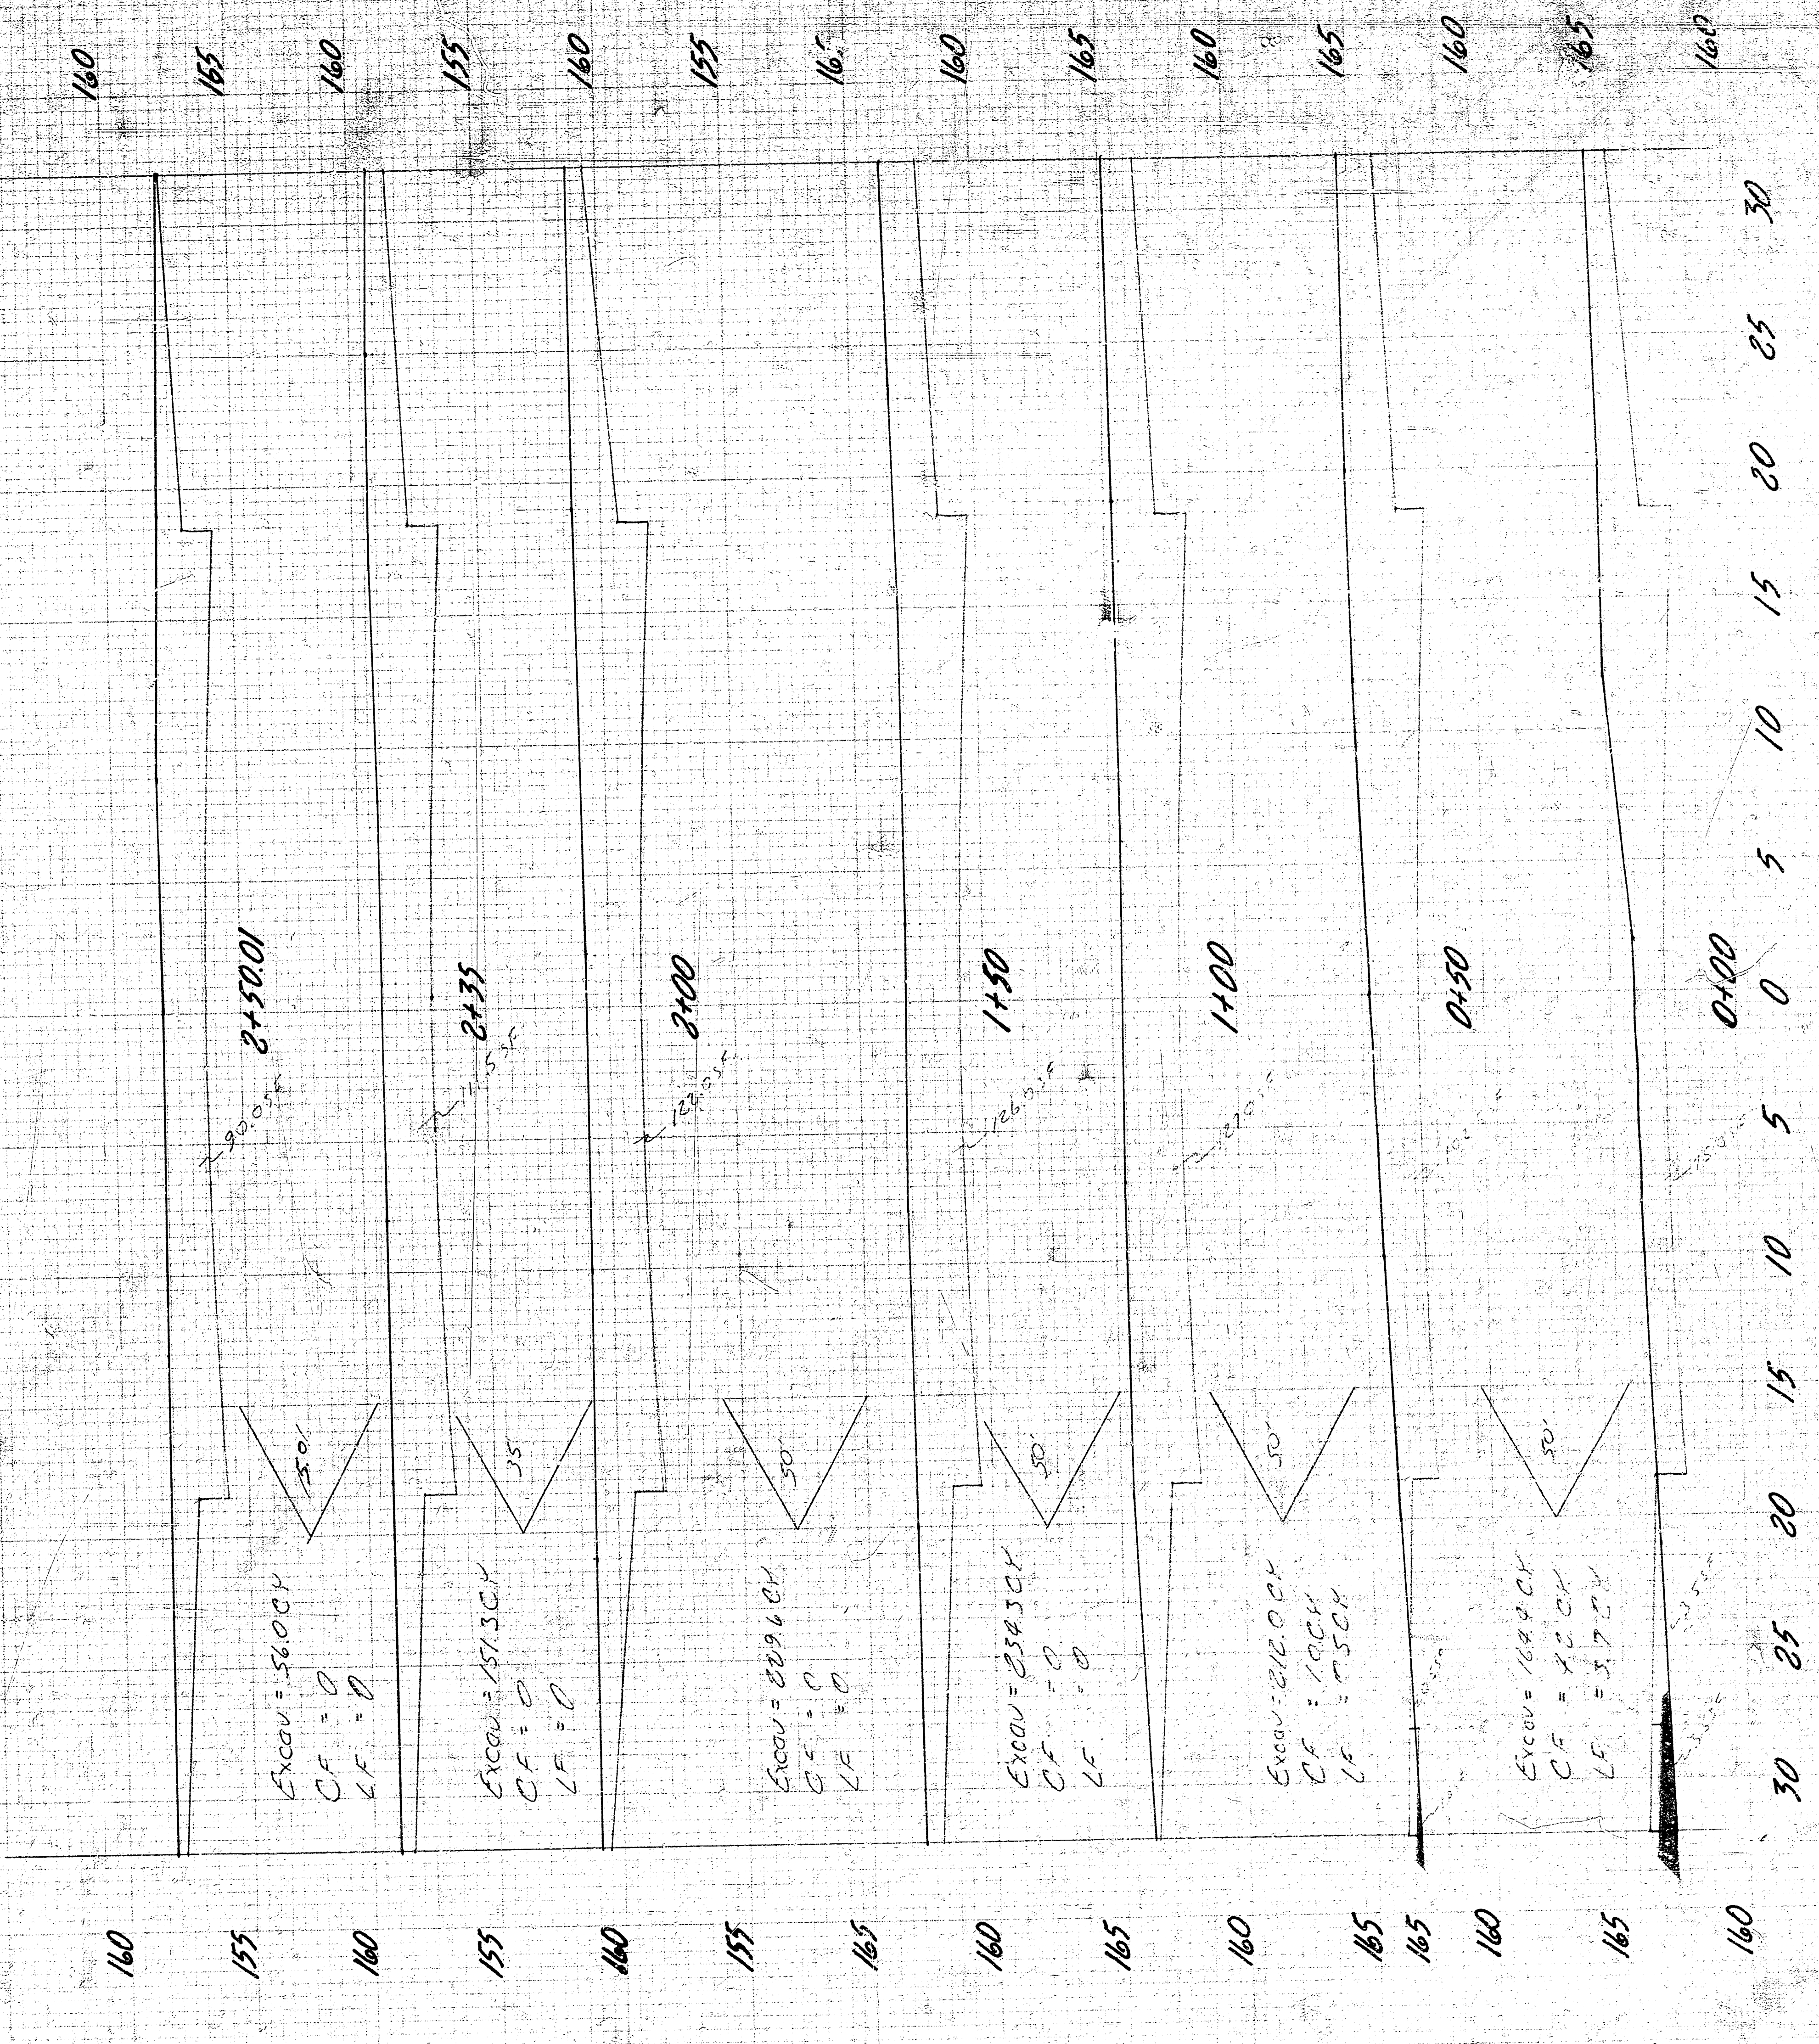

 Property City
 Mt. Vernon Dist