


B.M. 106.45 Iron in thimble @ Glen & Munnell

Notes: E. of Munnell West is 2.57' South of E. Munnell East

Remove Valley Gutter & Return, Install to new grade using 10' Radius

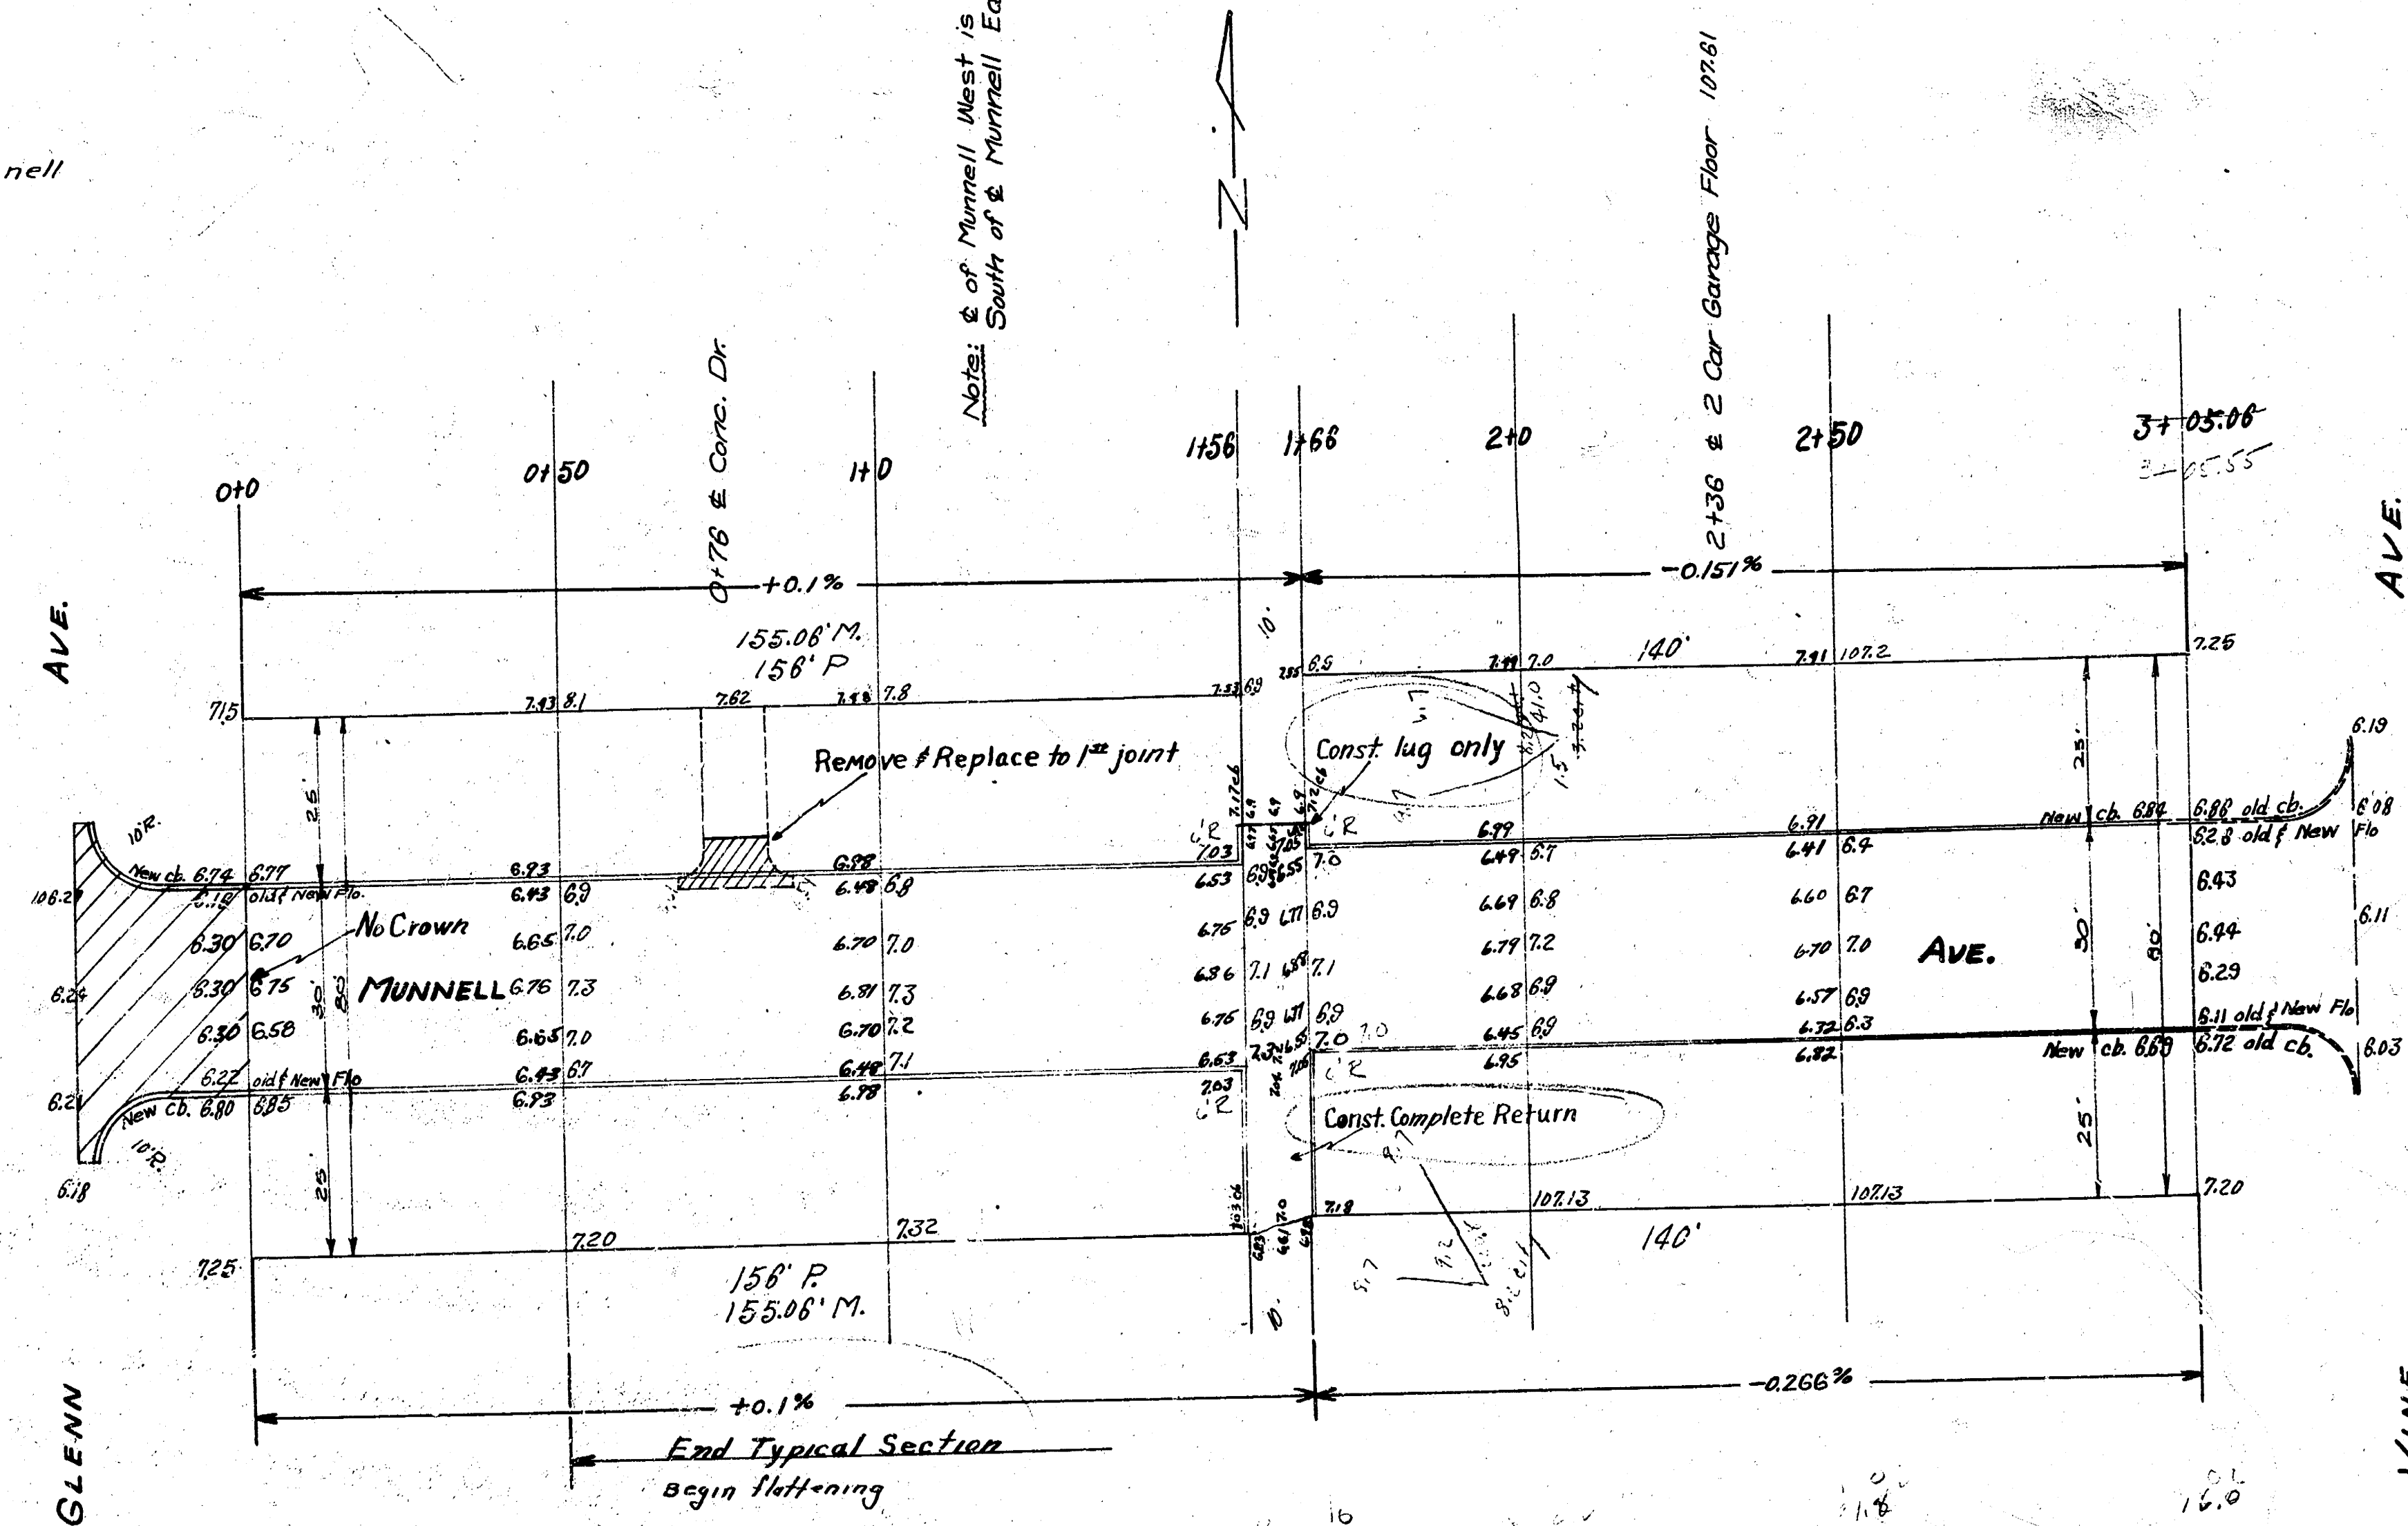

P.O.P.

58.3
64.7
33.2
43.0
34.2

304.3
110.7

22.2 + 24.4 = 46.6

E.T.Y.

5.2
9.2
7.0

20.4

110.80

22.9 + 24.4 = 47.3

TOTAL

336.9

354.3 + 24.4 = 378.7

MUNNELL AVE.
E.L. GLENN & W.L. VINE
30' CONC. & CB.
CITY OF WICHITA, KANSAS
L. K. WHITE CITY ENGINEER
MAY 1949 PROJ. NO. C19-77