NEVADA STREET
N. L. Douglas Ave. to & incl. Cul-de-sac
Proj. No. DAKS 575127

TYPICAL SECTIONS OF 30' CONCRETE PAVEMENT

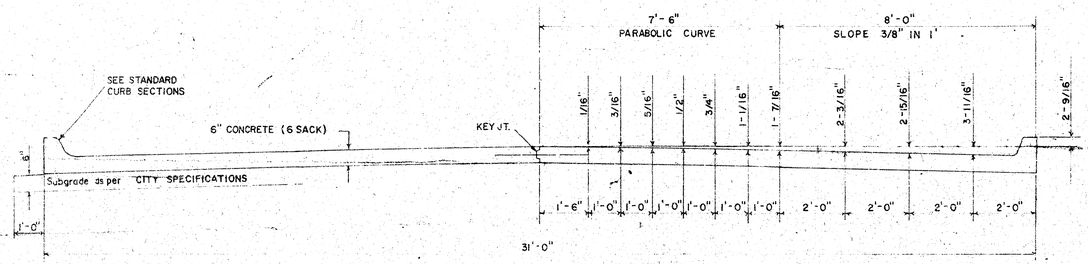

TYPICAL SECTION WITH STANDARD CROWN

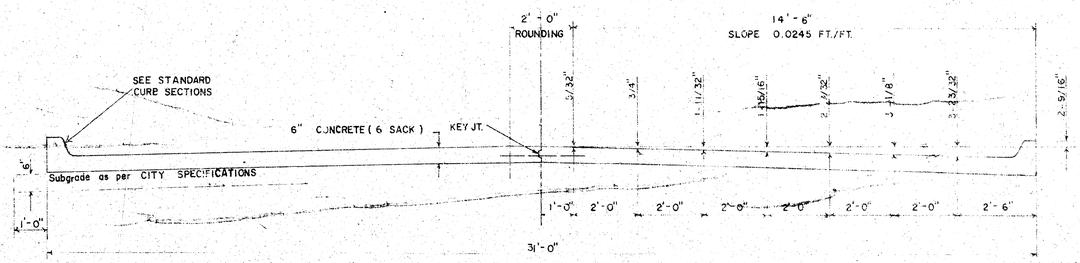

TYPICAL SECTION WITH ALTERNATE CROWN

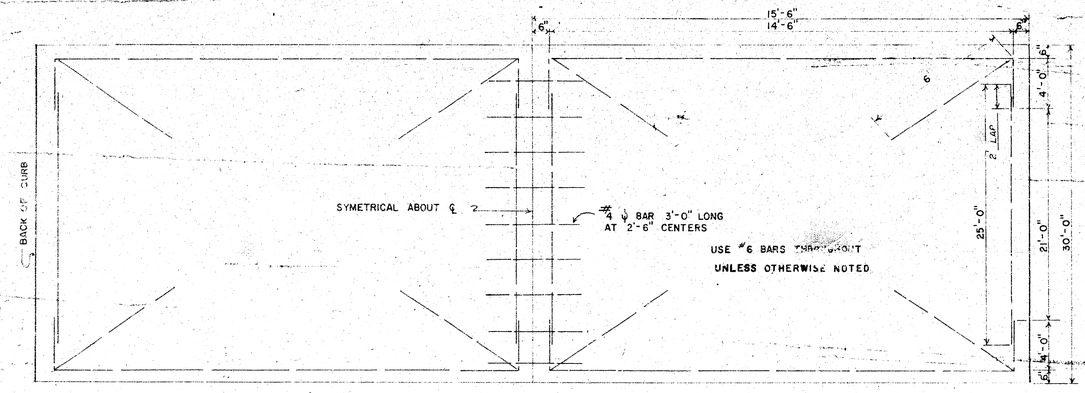

STEEL PATTERN

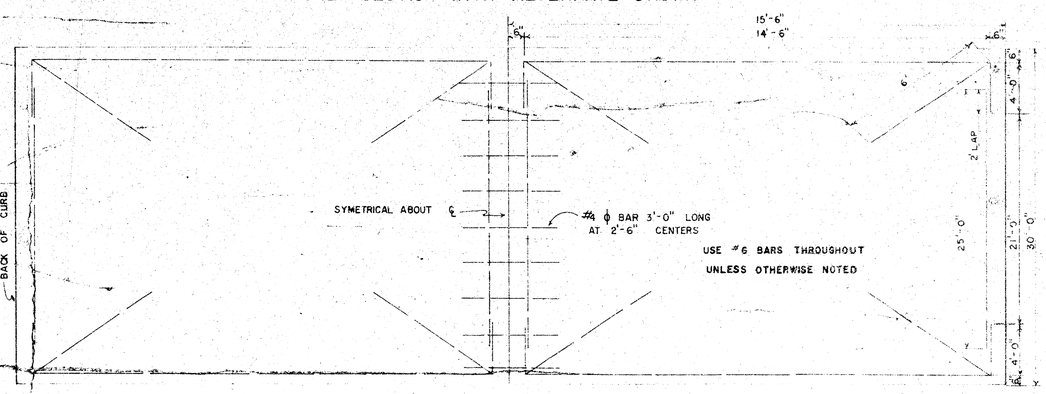

STEEL PATTERN

STANDARD SECTIONS OF

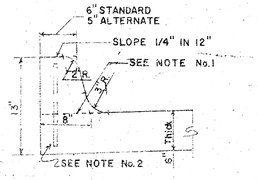

INTEGRAL CURB

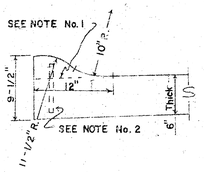

ROLL—TYPE

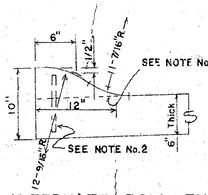

ALTERNATE ROLL—TYPE

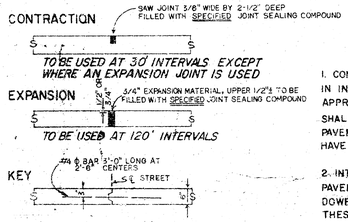

JOINT DETAILS

GENERAL NOTES

1. CONTRACTION JOINTS MAY BE CONSTRUCTED IN INTEGRAL CURB BY SAWING WITH AN APPROVED CONCRETE SAW. THE SAW CUT SHALL EXTEND THROUGH THE CURB TO THE PAVEMENT. SAWED CONTRACTION JOINTS SHALL HAVE A MAXIMUM SPACING OF 10'.

2. INTEGRAL CURB SHALL BE TIED TO THE PAVEMENT BASE WITH SHORT DEFORMED DOWEL BARS SPACED AT 2'-6" INTERVALS. THESE DOWEL BARS SHALL NOT BE LESS THAN 1/2" OR MORE THAN 3/4" IN DIAMETER.

CITY OF WICHITA, KANSAS (1/6)
Department of Public Works — Engineering Division
R.W. Linn — City Engineer
Date: — Project No. DAKS575127

1/4

FILMED FROM THE BEST AVAILABLE COPY.....

B.M. = 117.94 R.R. Spk. N. Side P. Pole @ S. Side Douglas, Approx. 100' E. of Nevada
Baseline is E. L. Nevada

NORTH
Scale: 1" = 20'

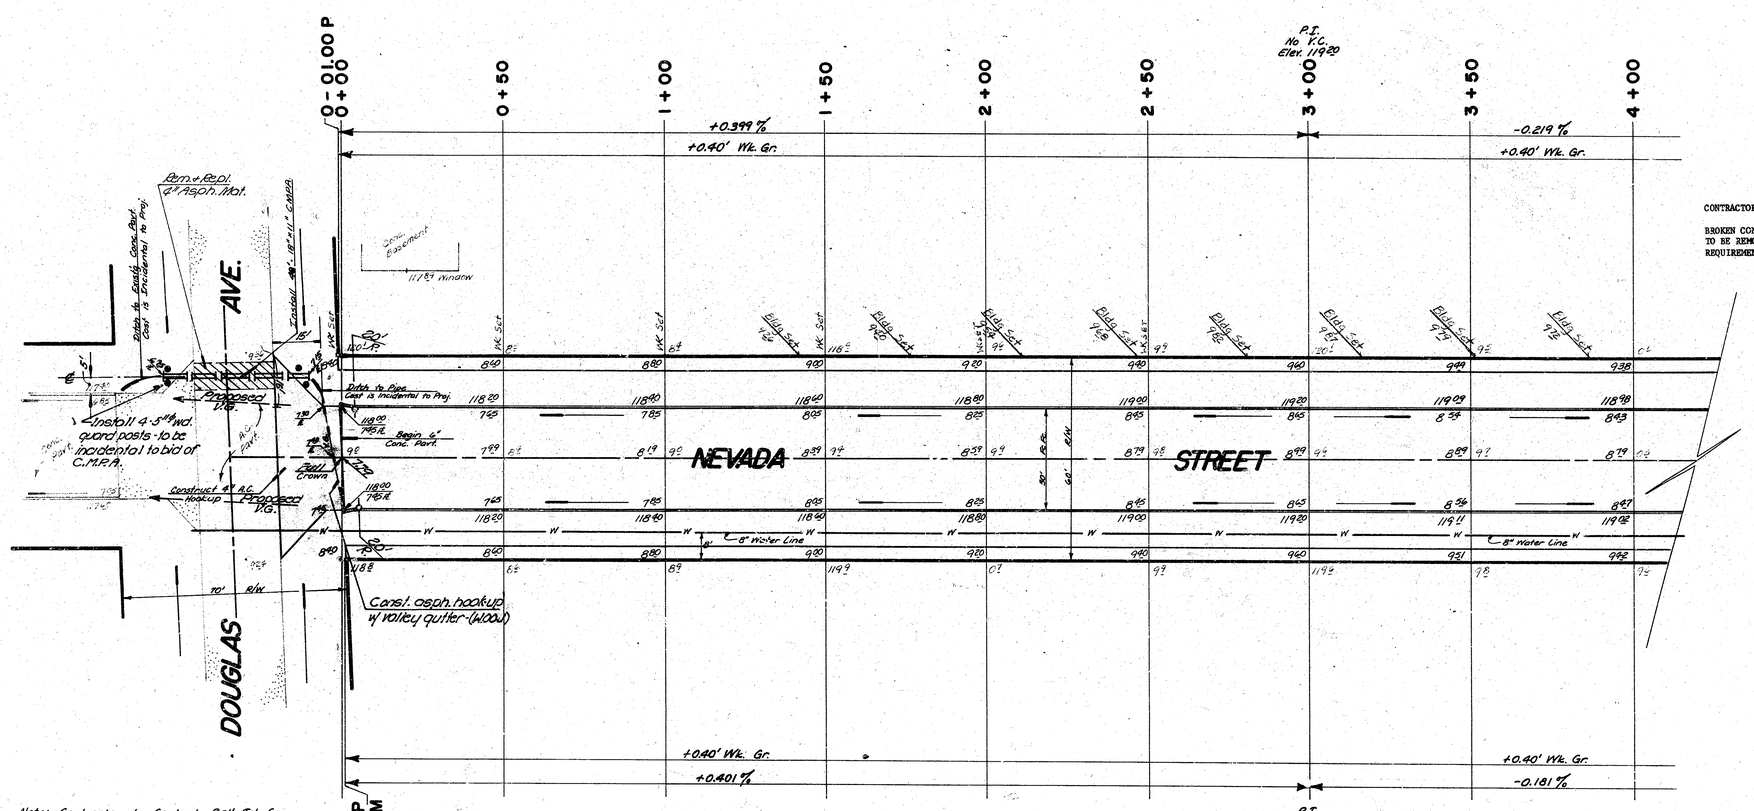

Survey Gantz
Plan Henry
Exc Henry
Checked

Note: Contractor to Contact Bell Tel. Co. Regarding Location of Underground Utilities on North Side of Douglas.

Note: Only 8 drives are included in this Project.

CONTRACTOR NOTE -

BROKEN CONCRETE STOCK PILED IN CITY RIGHT-OF-WAY TO BE REMOVED BY OWNER AS SET FORTH IN PLATTING REQUIREMENTS.

EARTHWORK	Prop.	City
Excavation	1554.2 C.Y.	57.7 C.Y.
+10%	155.4 C.Y.	5.8 C.Y.
Total	1709.6 C.Y.	63.5 C.Y.
Compacted Fill	5.9 C.Y.	———
+10 %	0.6 C.Y.	———
Total	6.5 C.Y.	———
Manipulation = 2506.3 S.Y.		

SUB-GRADE

TYPE OF SUB-GRADE TREATMENT SHALL BE DETERMINED BY THE FIELD ENGINEER. SUB-GRADE TREATMENT MAY CONSIST OF LIME TREATMENT, CEMENT TREATMENT, SUB-GRADE MODIFICATION, OR ANY COMBINATION OF THESE.

NOTE TO FIELD ENGINEER & CONTRACTOR
Grade parking and clear right-of-way for proposed sidewalk. Compact fill in sidewalk area. TO BE CONSTRUCTED BY "OTHERS".

2/6

NEVADA STREET

N.L. Douglas to & Incl. Cul-De-Sac

(30' Fc-Fc, 6" Conc. Pavt. w/ Integral Curb.)

CITY of WICHITA, KANSAS

R.W. Linn ——— City Engineer

Proj. No. DAKS575127

Date _____

3/4

FILMED FROM THE BEST AVAILABLE COPY

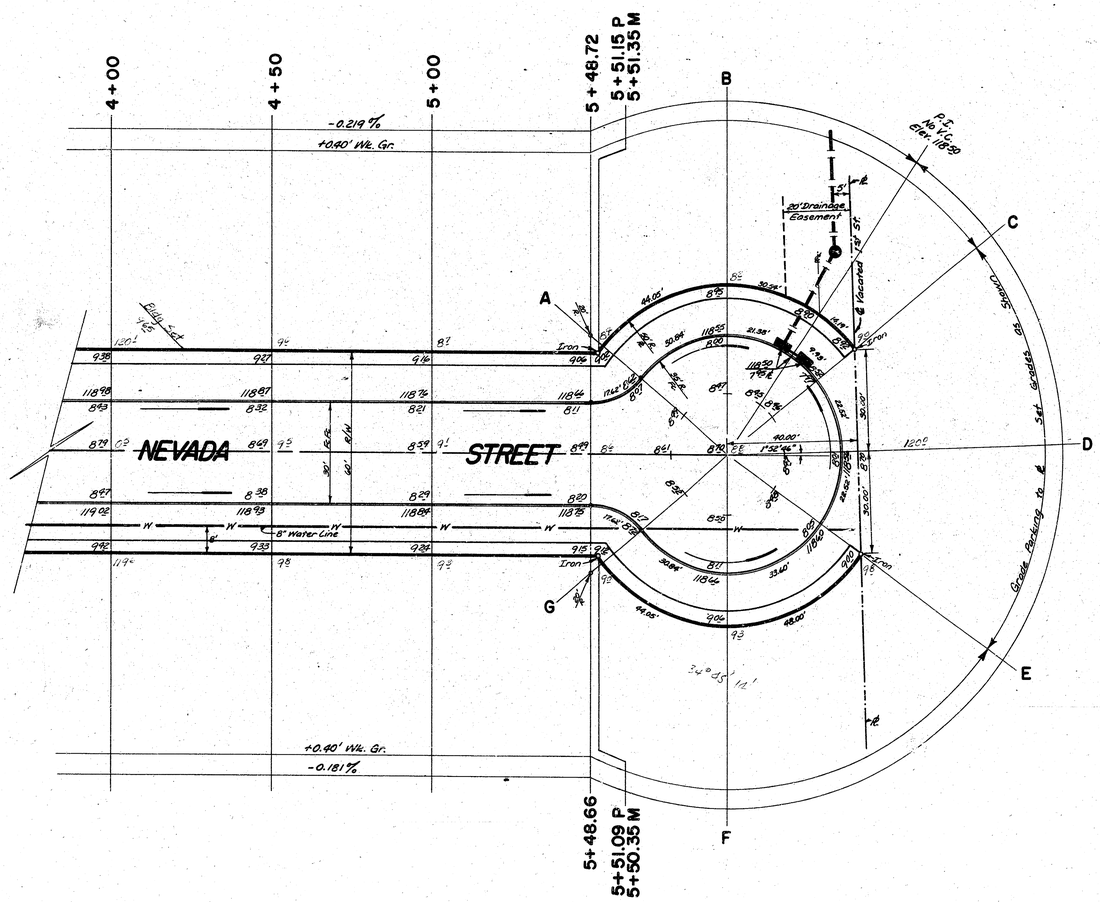

FILMED FROM THE BEST AVAILABLE COPY

B.M. = 117.94 R.R. Spk. N.S. P.P. S. Side Douglas, Approx. 100' E. of Nevada

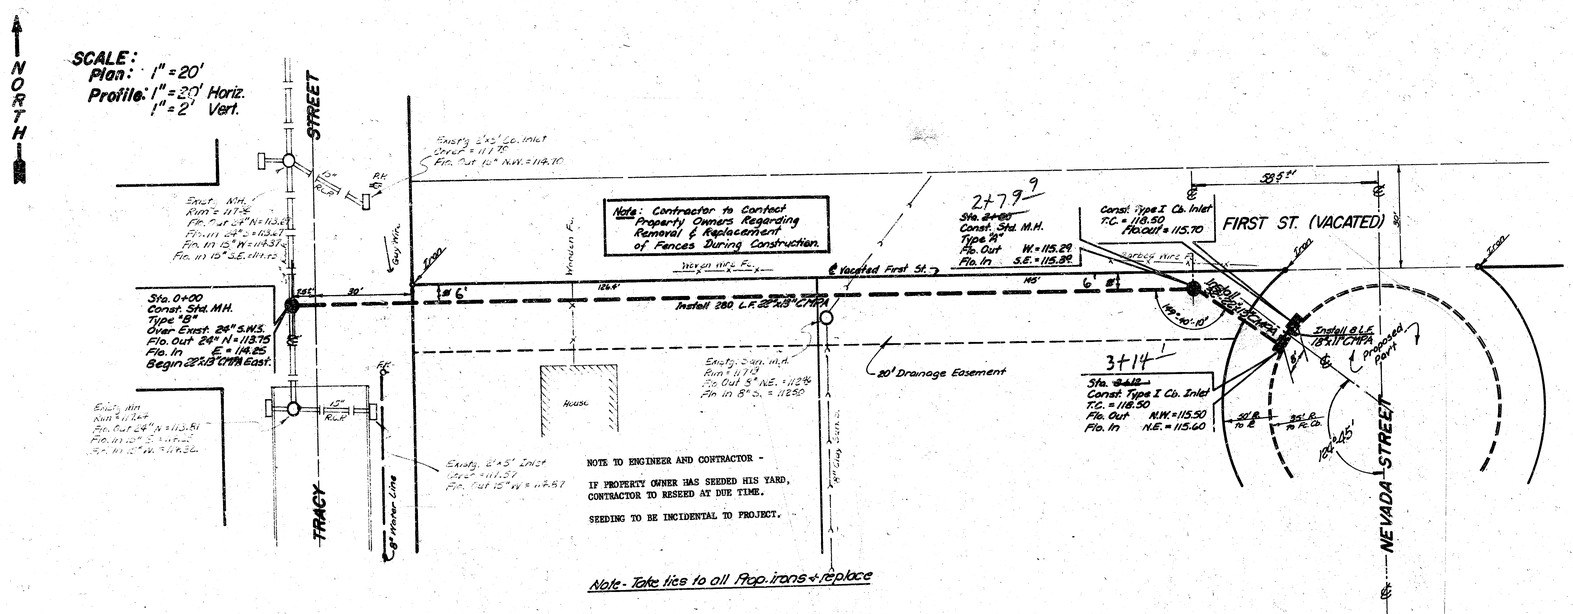

DRAINAGE in CONNECTION with
NEVADA STREET
N. L. Douglas to & incl. Cul-de-sac

CITY OF WICHITA, KANSAS
R.W. Linn — City Engineer
Proj. No. DAKD575127
Date _____

6/6

PLATE 1 SINGLE PLAN AND PROFILE

FILMED FROM THE BEST AVAILABLE COPY