
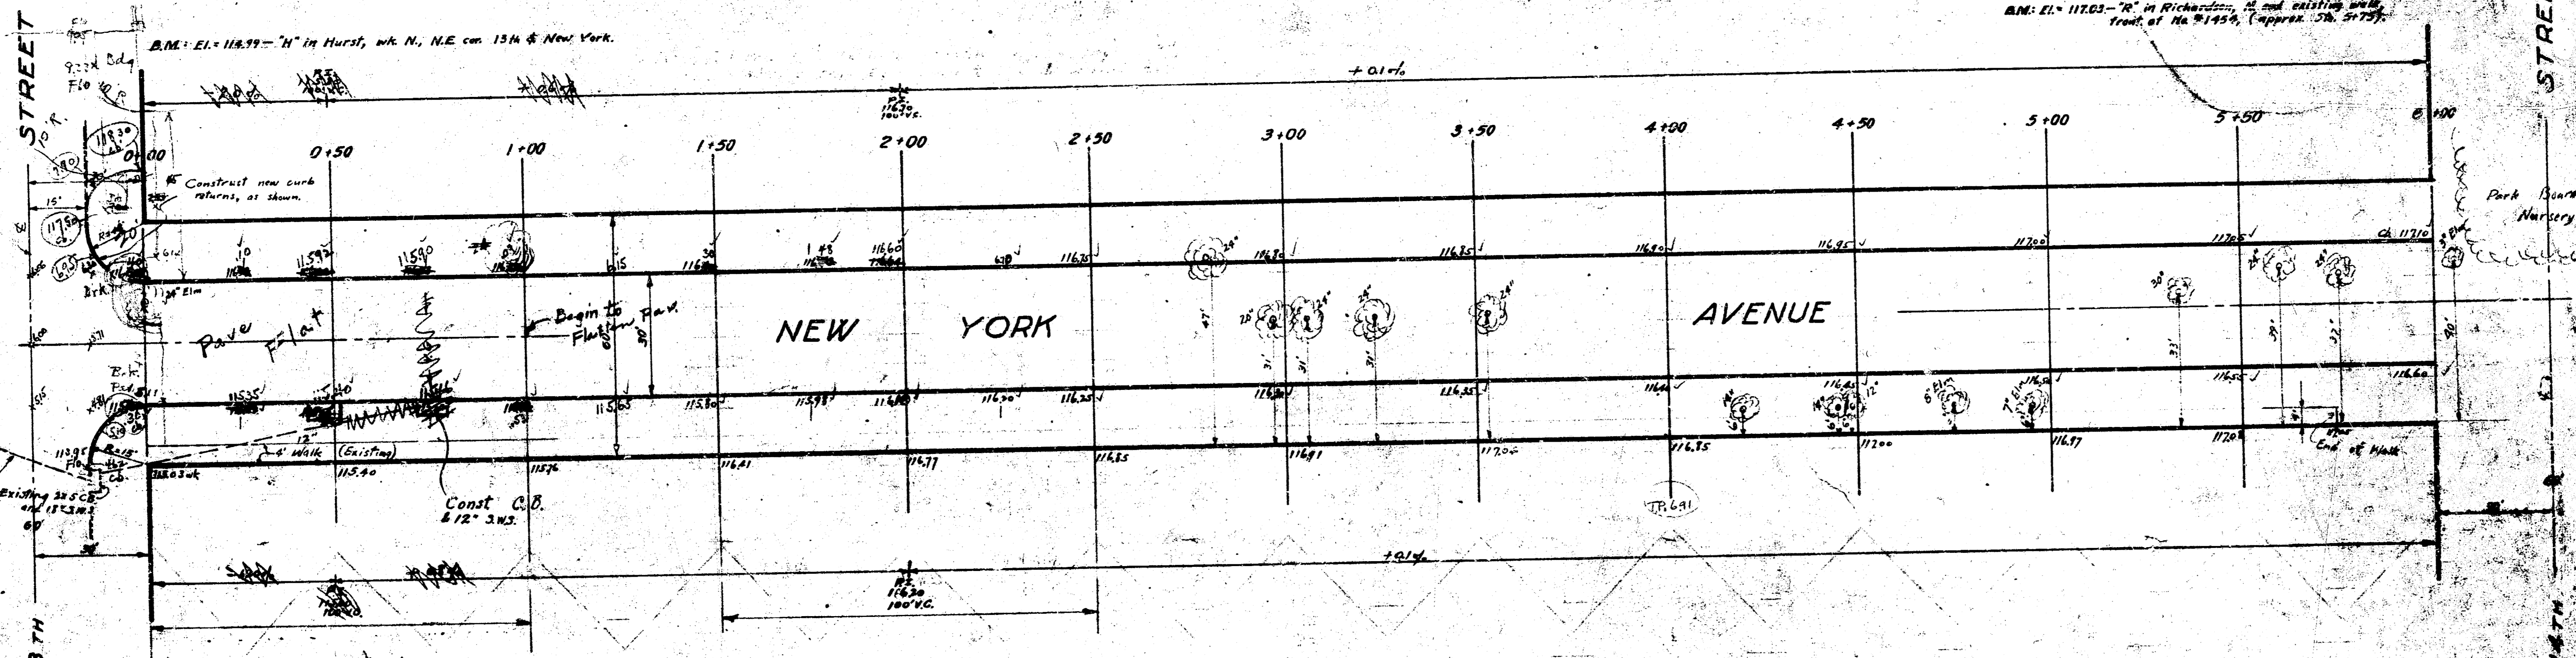


Blue Top
10-26-45
A.H.M.

PAVING PLAN-----1945 NEW YORK AVENUE N.L. 13TH CONCRETE 30' & INTEGRAL CURB S.L. 14TH

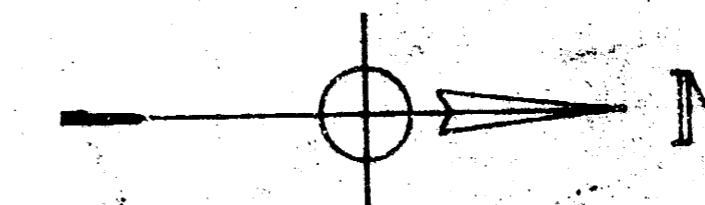

Note:
Revise Grades
0+0 to 2+50
Book 53 P. 20
C.H.M.

NO REVISIONS

EXCAVATION	
Property	571.2 cu yds.
City	57.1 --
Total Excav. Property	
1142.3 Cu. Yds.	
On Cross Section Sheet.	



NEW YORK AVE
N.L. 13TH S.L. 14TH

DATE: 9-18-1945
DR. E. M. WITTE
PUBLIC SERVICE DEPARTMENT
L. K. WHITE, CITY ENGINEER