

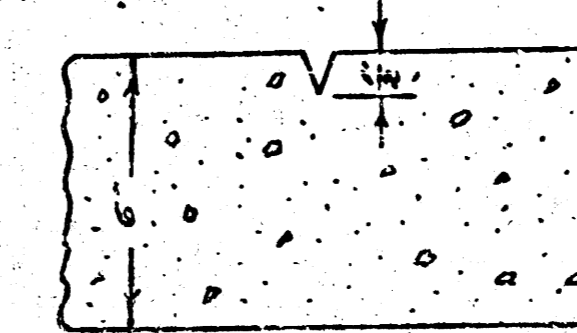
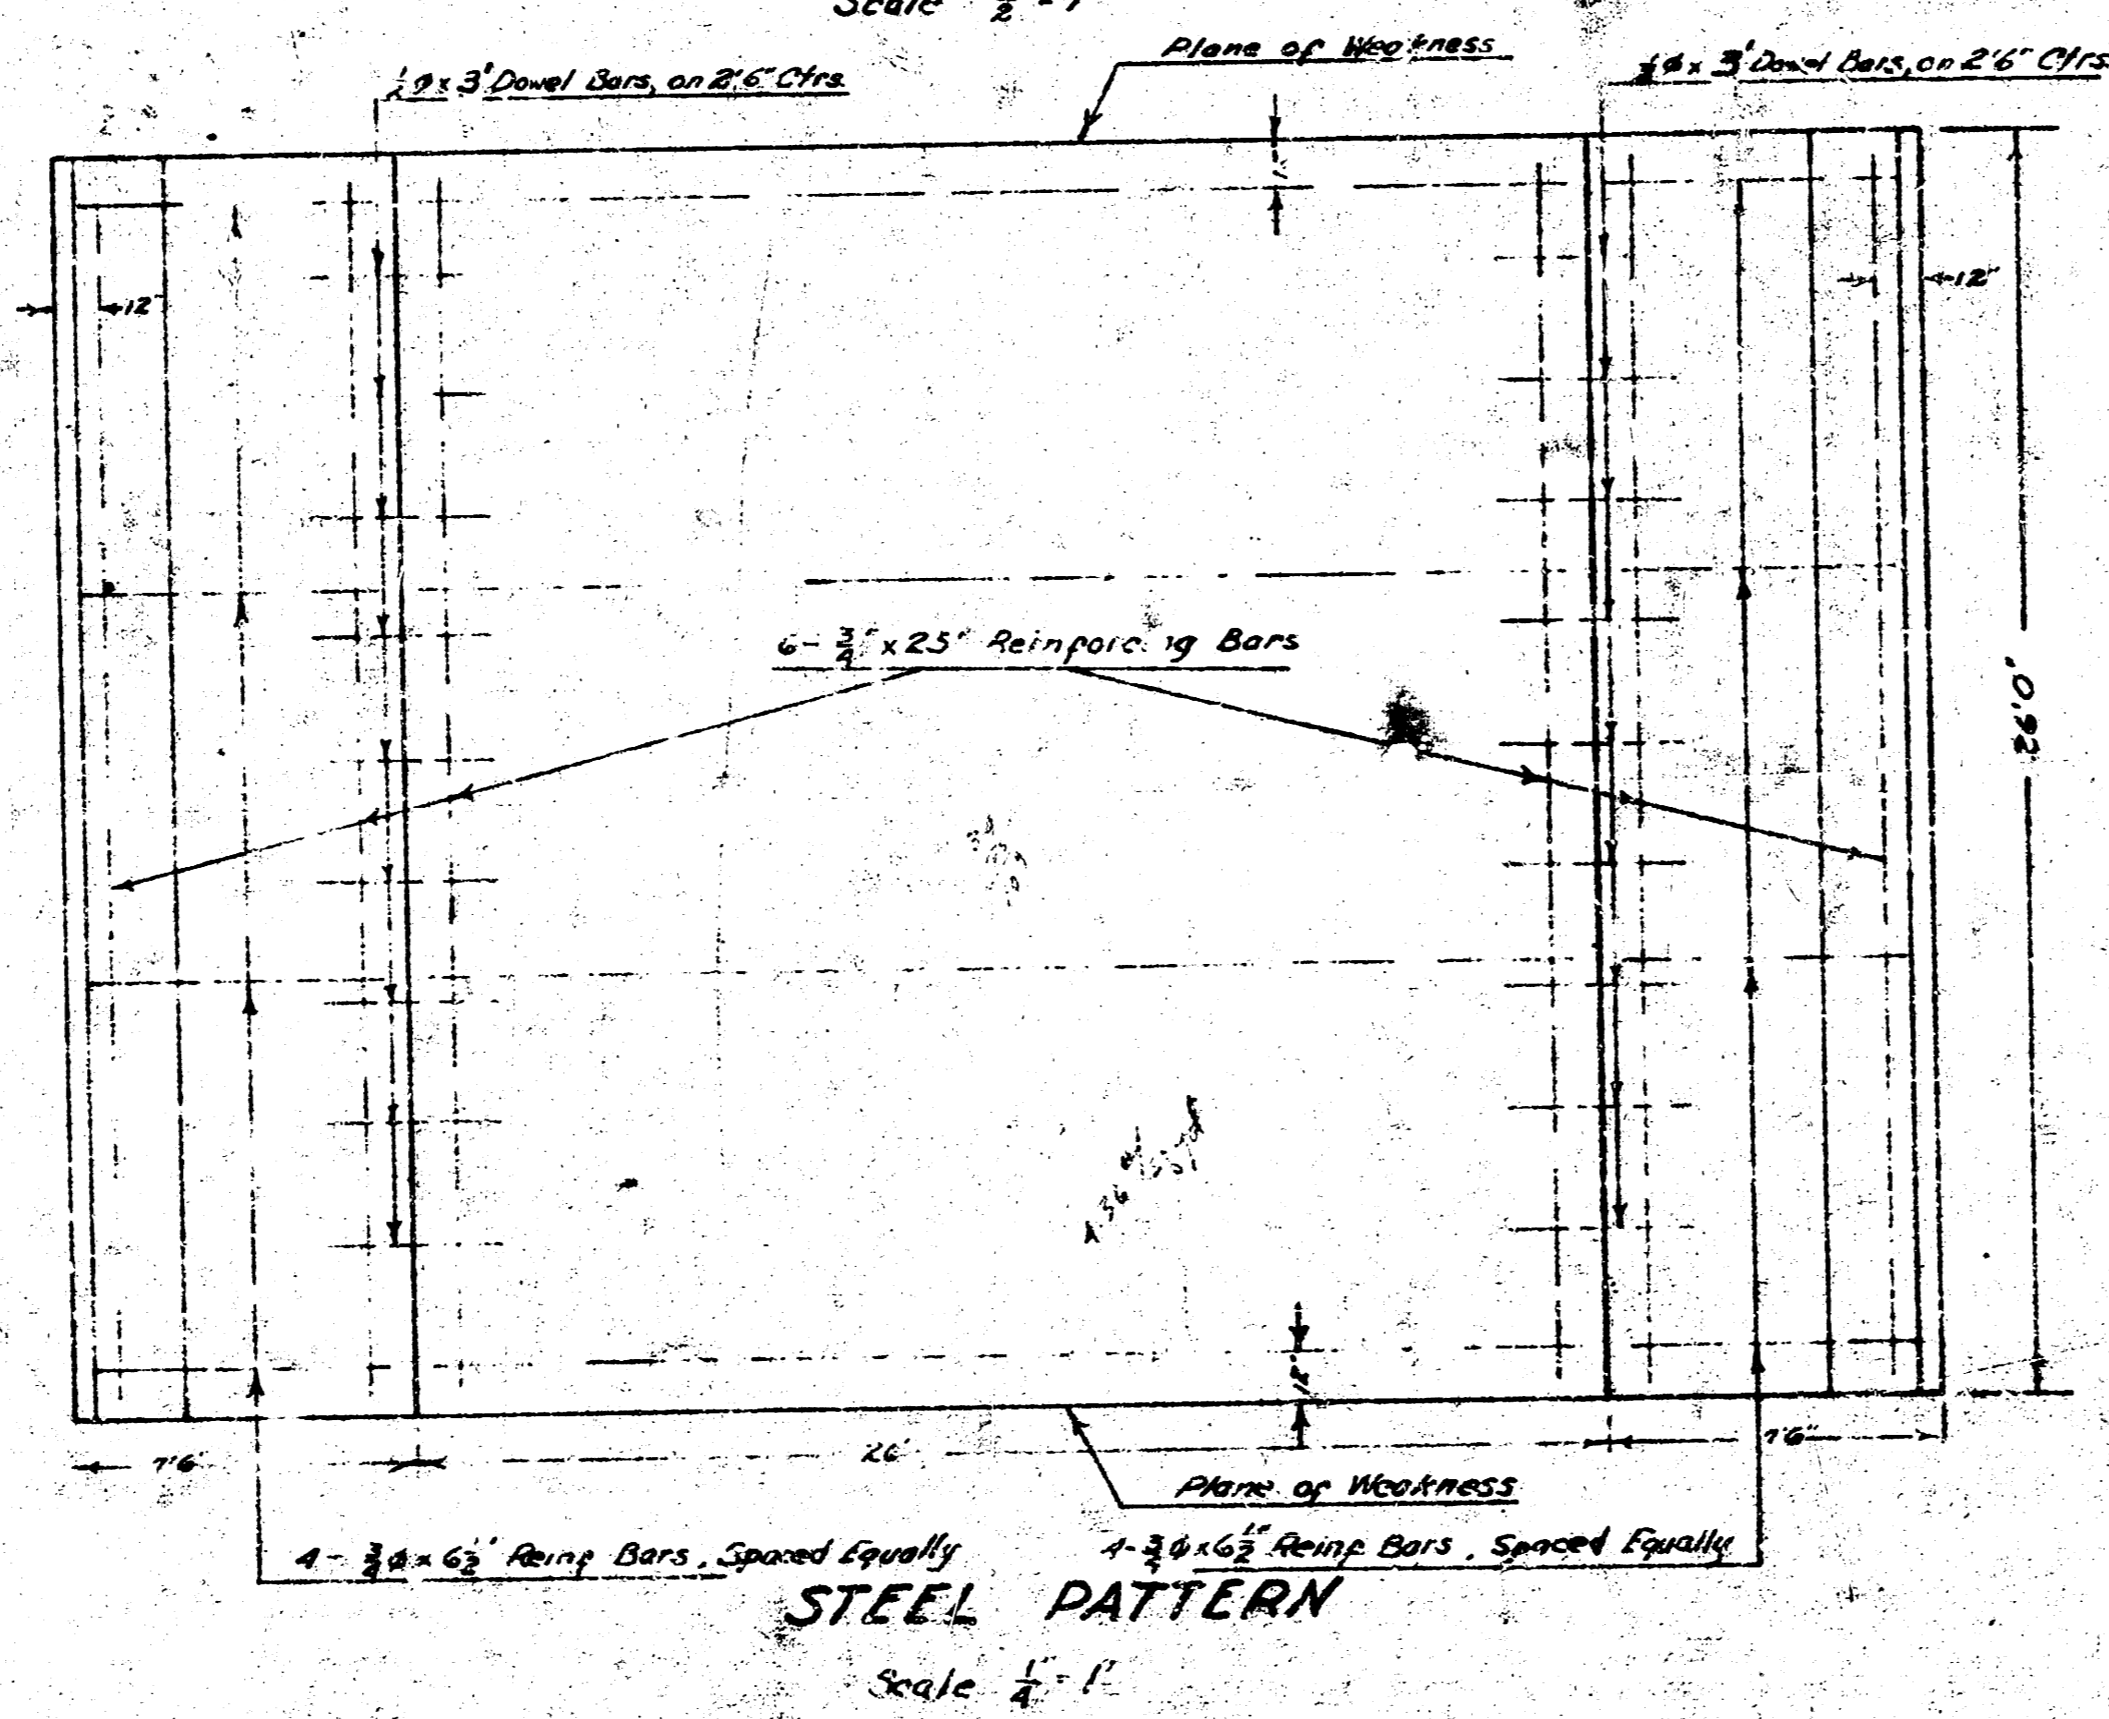


TYPICAL SECTION

Scale 1/2" = 1'

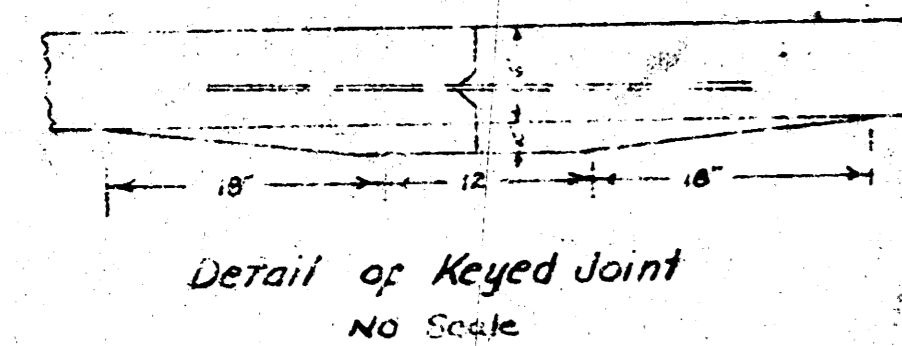



Plane of Weakness to Be Cut with Double-Fine Groove to Depth As Shown in a Straight Line from Curb to Curb - 24" Ctr. to Ctr.

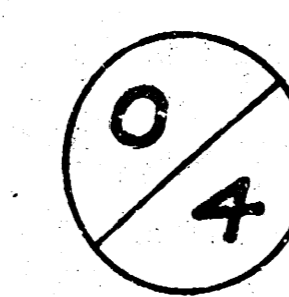



**NORTHERN**  
 ELHYDRAULIC TO WL MADISON  
 36-2-40 A.C.  
 6" Conc. Base  
**CITY OF WICHITA KANSAS**  
 LK WHITE CITY ENGINEER  



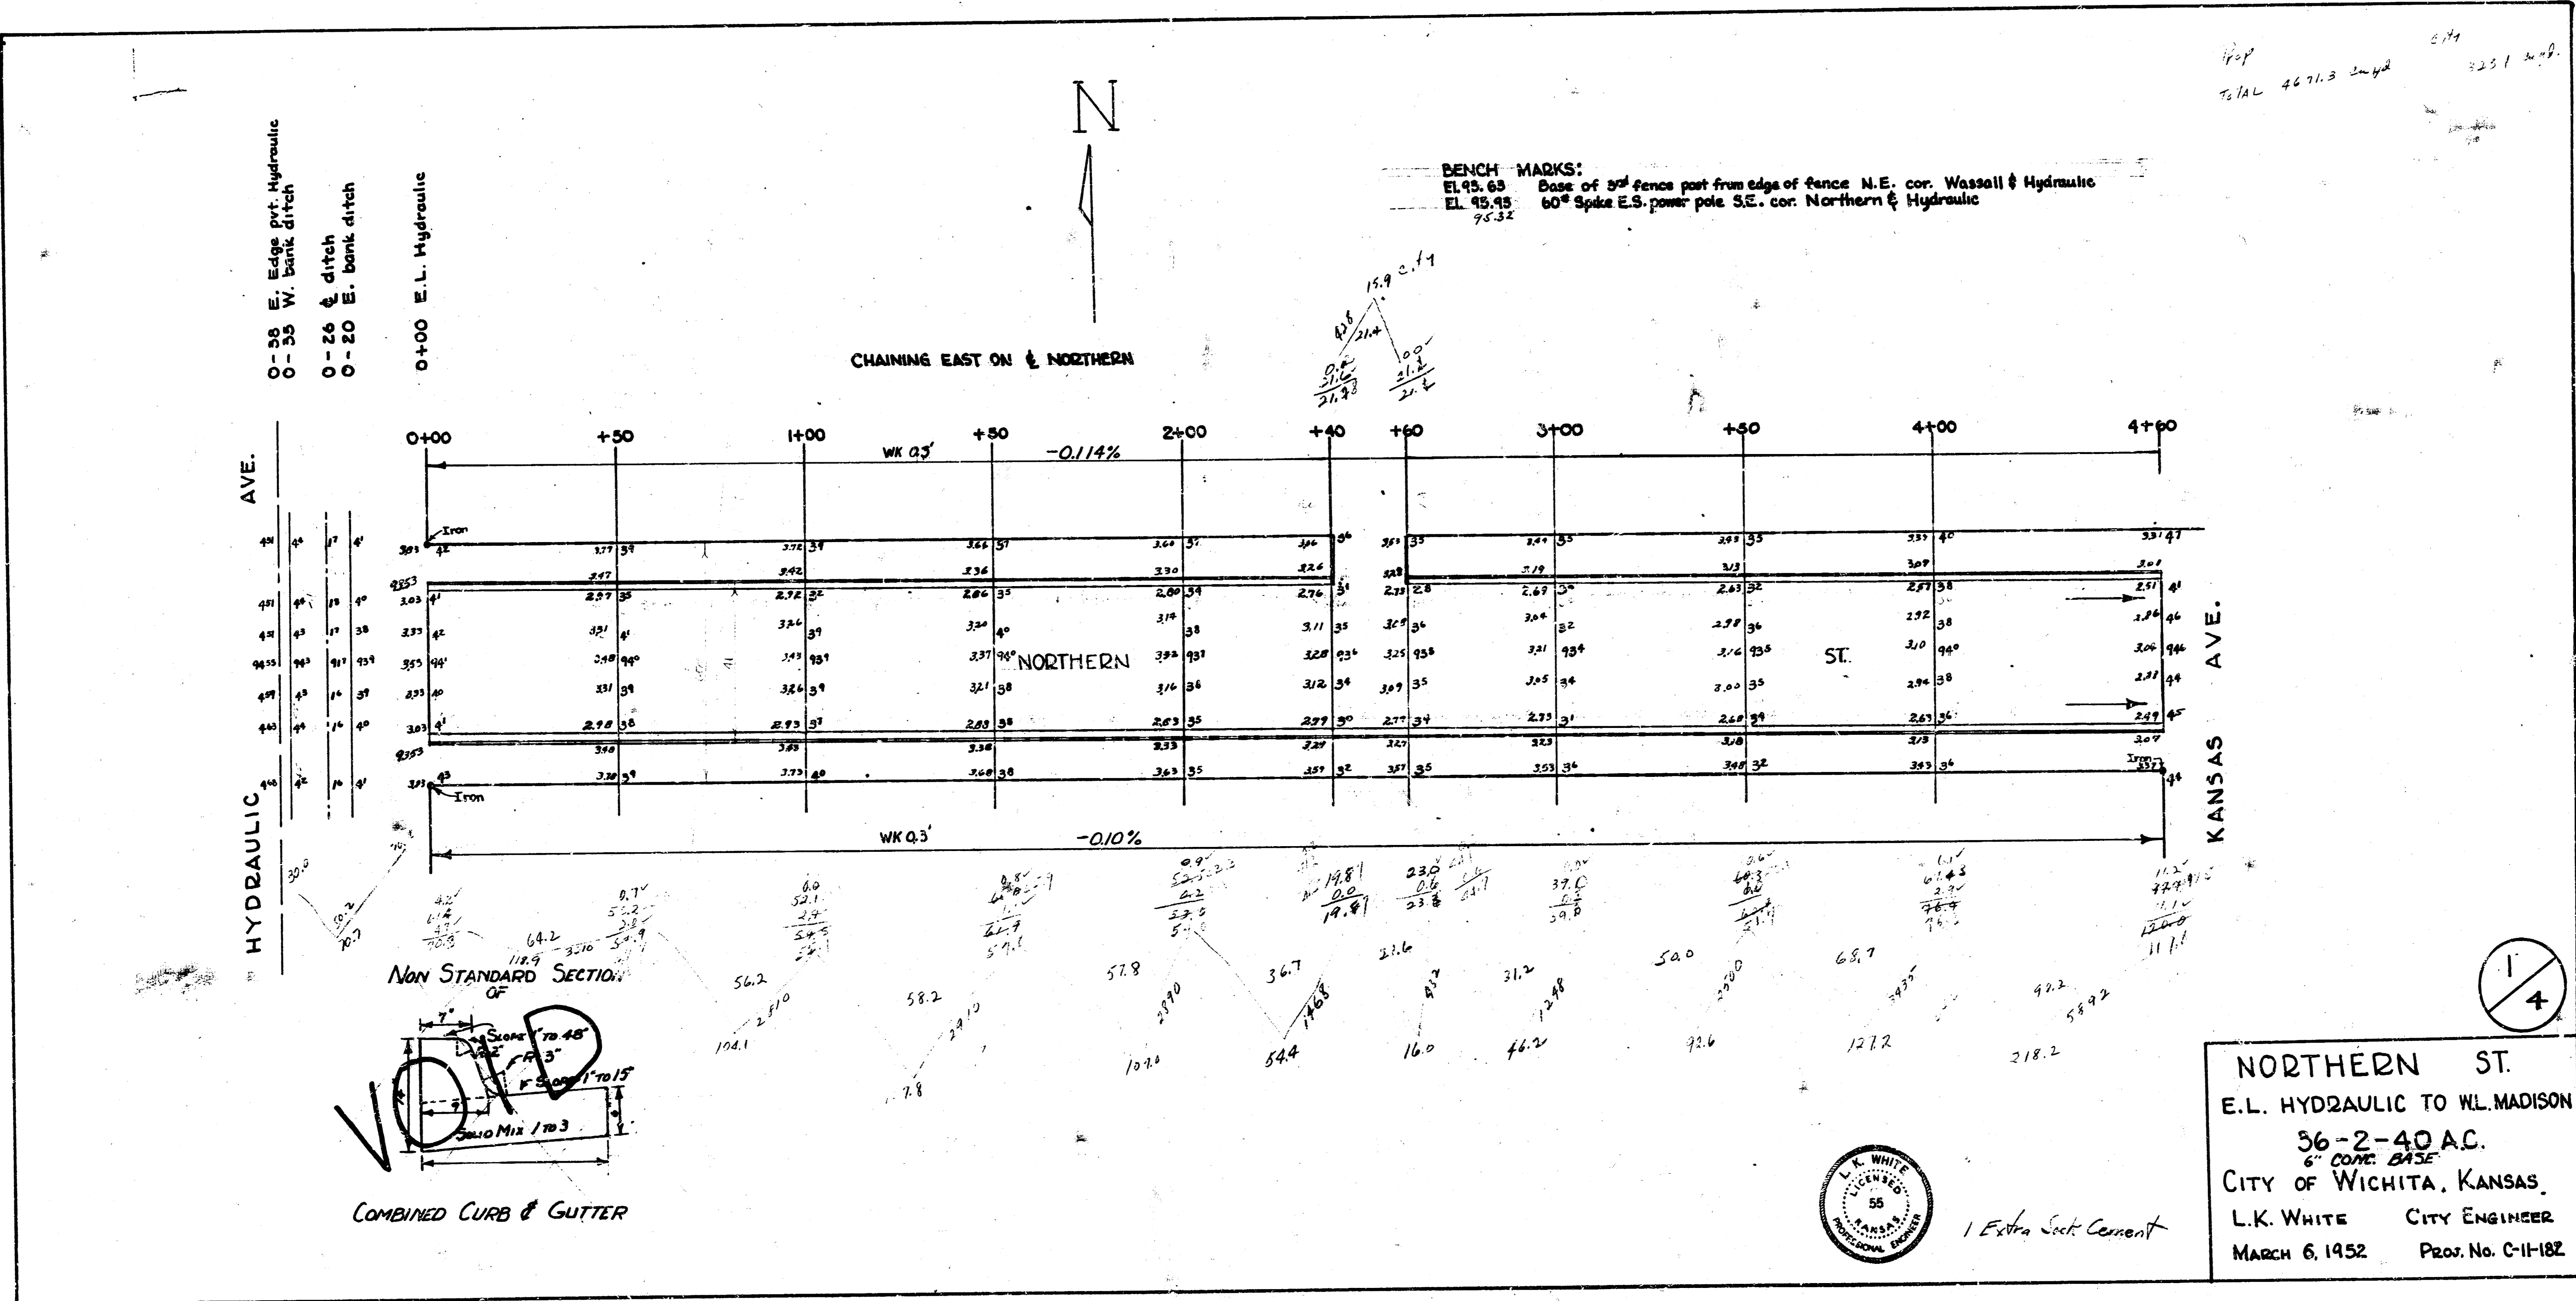




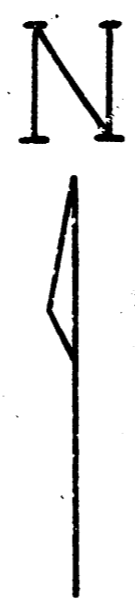



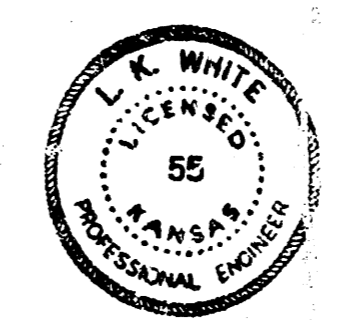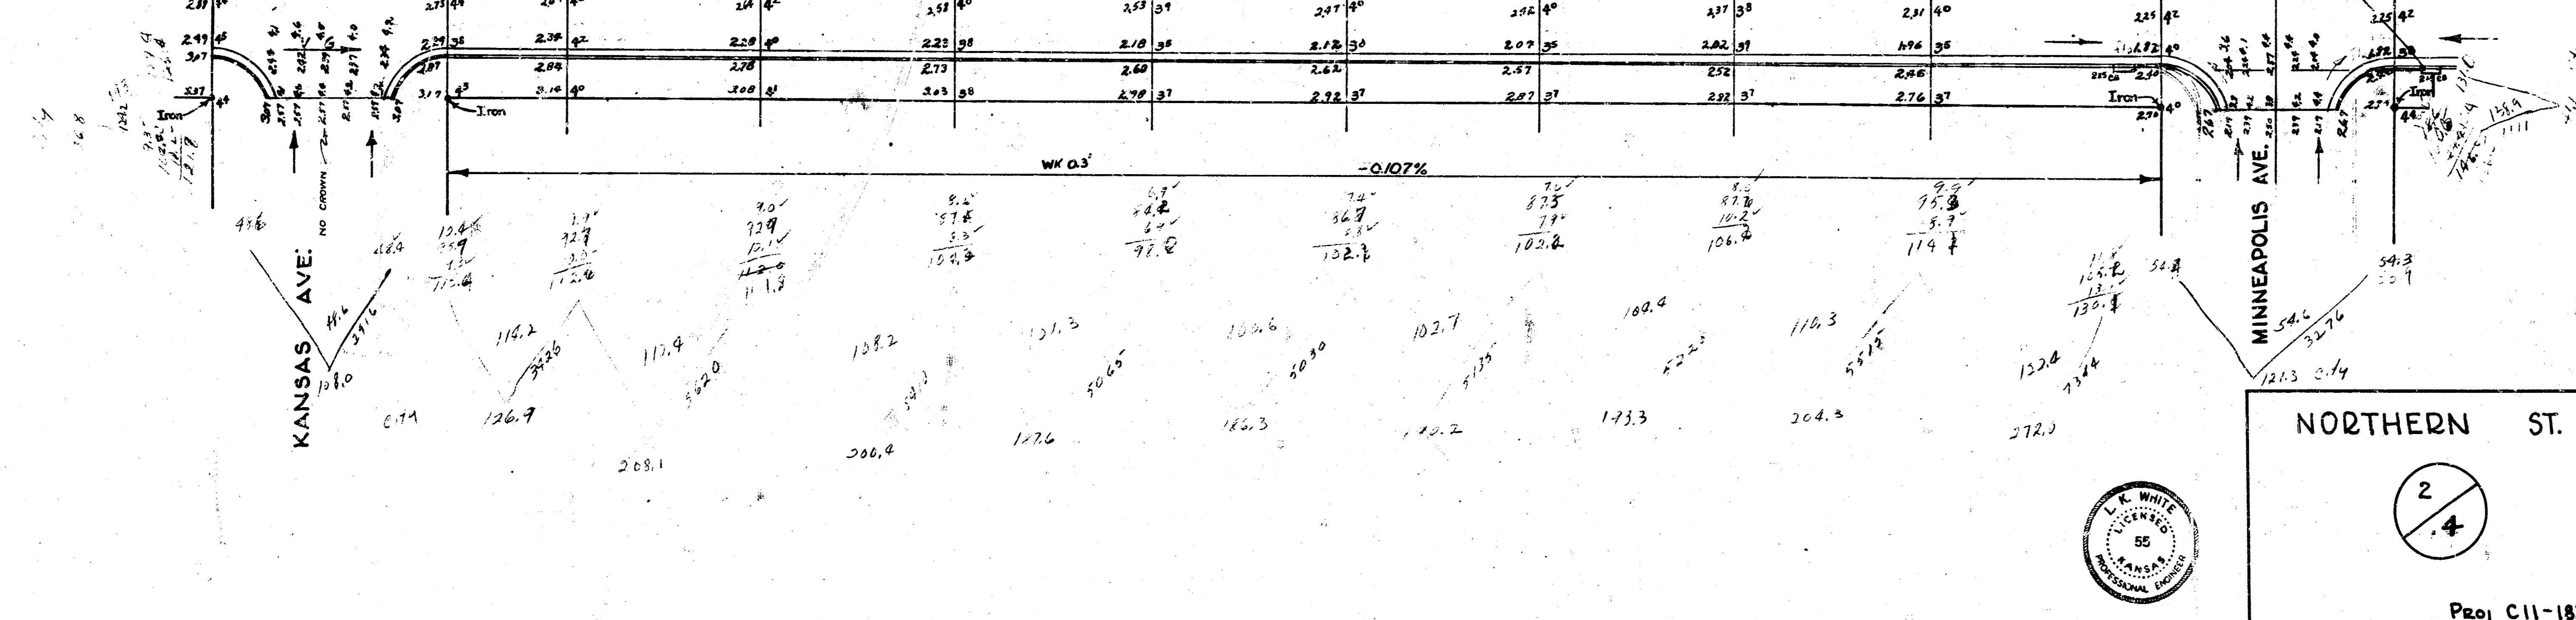

NORTHERN ST.

Proj C11-182

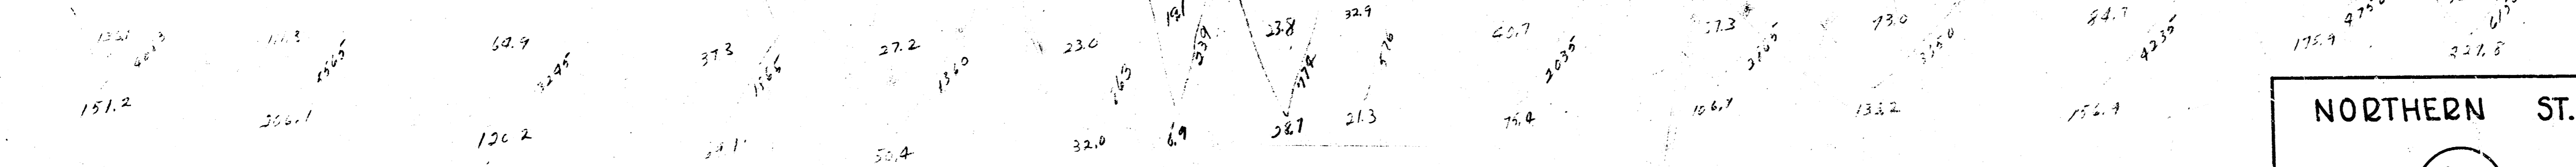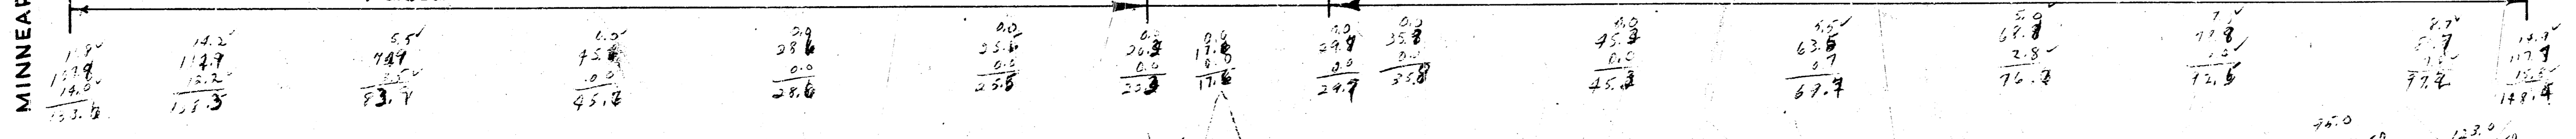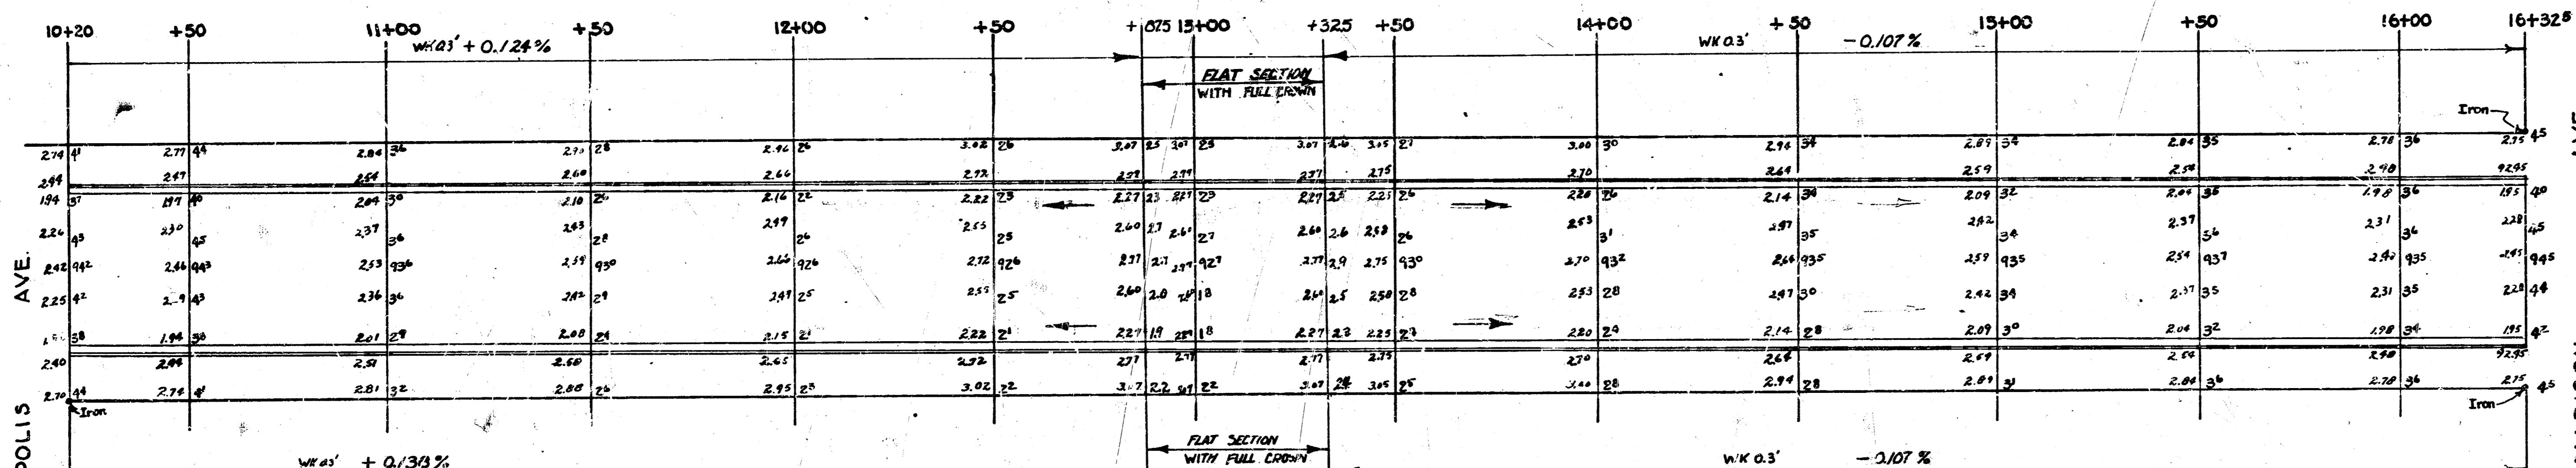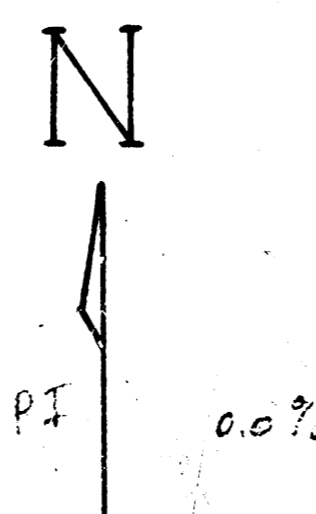

NORTHERN ST.

Proj. No. C11-182