
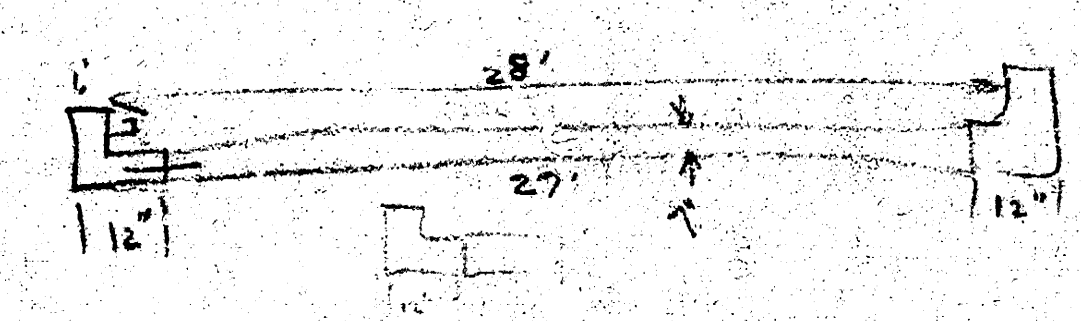


OHIO AVE. SL. MURDOCK to SL. FRISCO R.W. 7" CONCRETE.

Box 35 P.C.
84M.
Rail ELEV

Note Contact Chart
before setting & determine
S13 & Location of Facility
on Blotter

27' Slab
1' Gravel base
11.15' Top, 11.15' St. Frisco & Ohio.

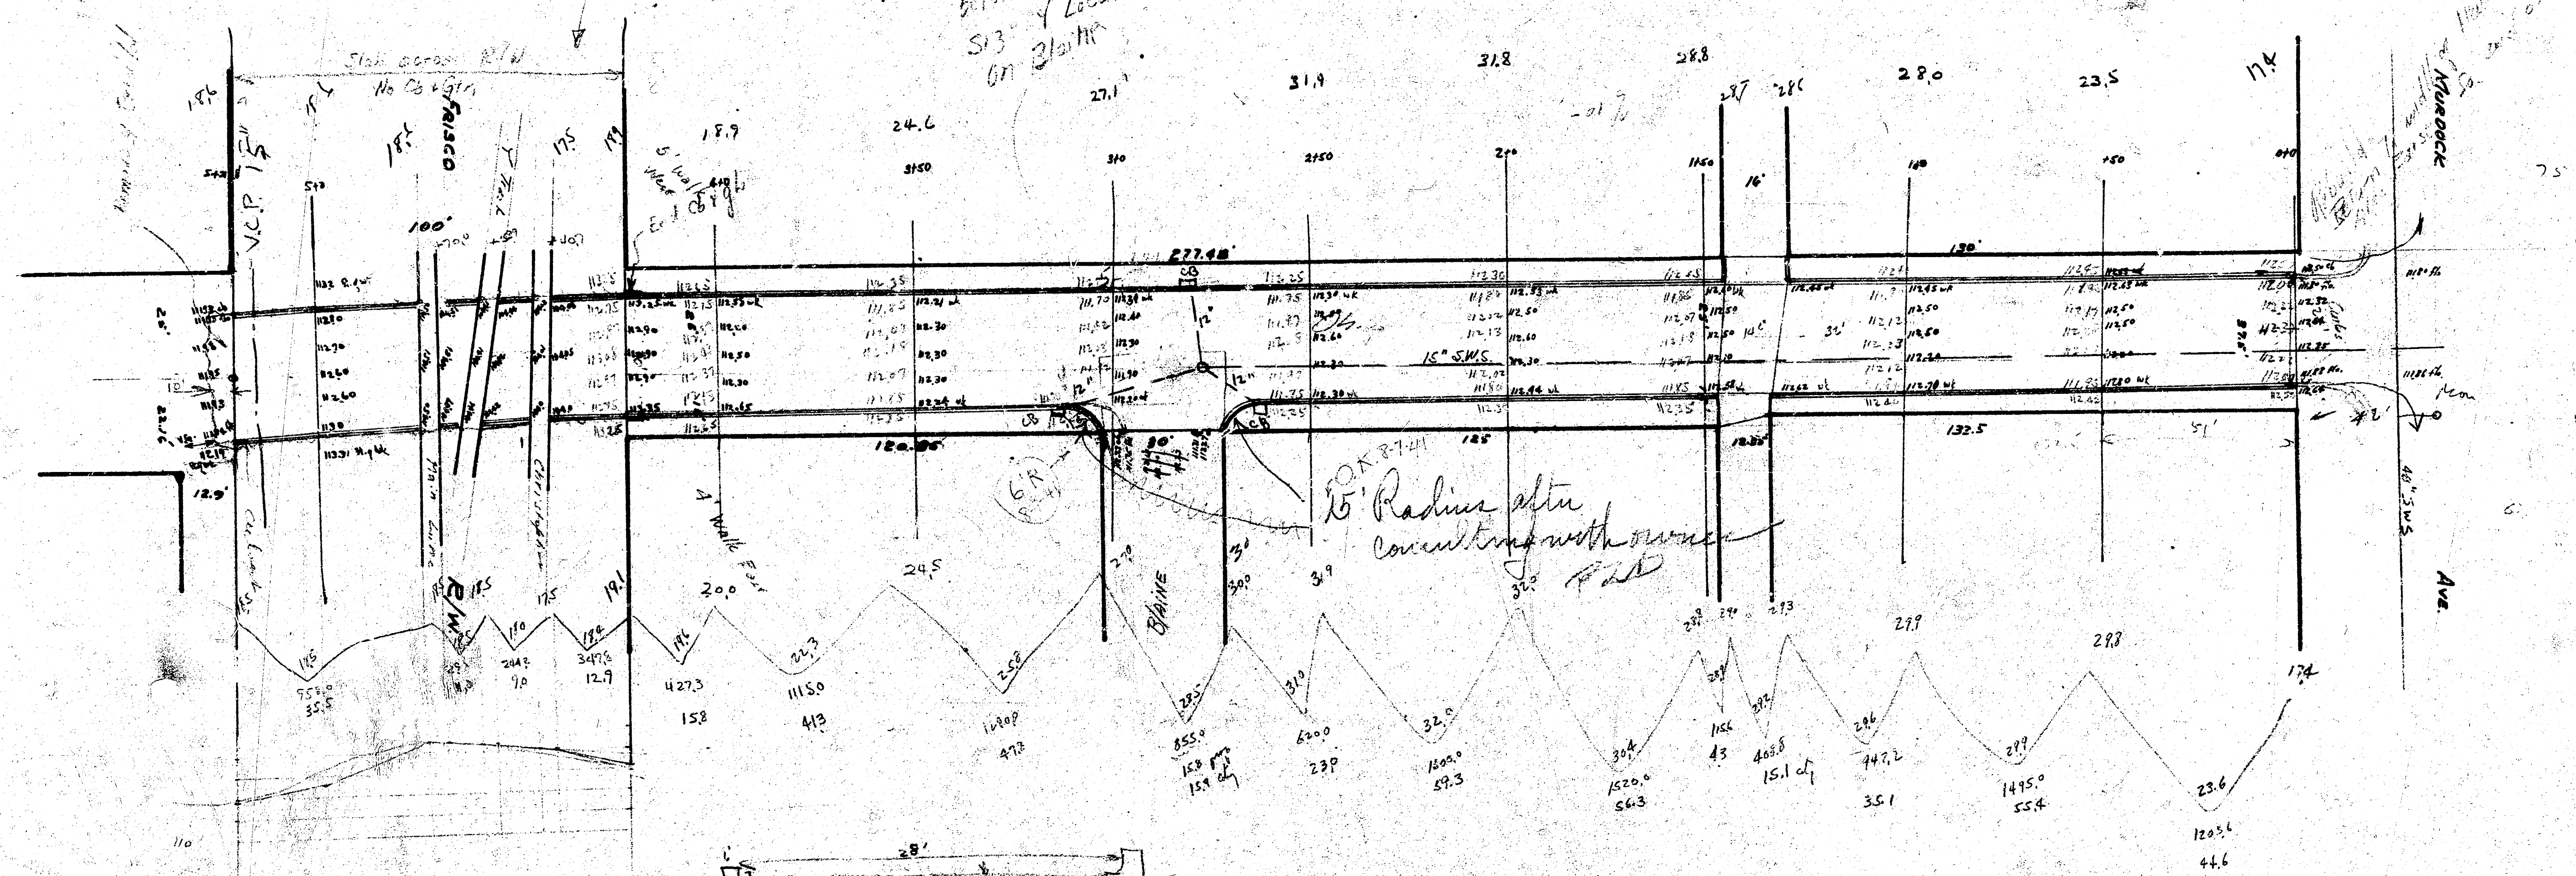

467.1
467.7
513.8' orig

31.0
31.1' orig