



B.M. 13133 RR SPIKE, SE. LT. POLE BET. PINECREST & OLD MANOR 60' N of NL KINNAID
B.M. 149556 S. END N. ROAD ES. COR. ISLAND SW. COR. OLIVER & MT. VERNON
B.M. 14176 NW. COR. WALK S. SL. MT. VERNON, RL. ELEV.



PROP.	CITY
3815.1	264.2
+10%	+10%
4195.6 at 425.	400.6 at 425.

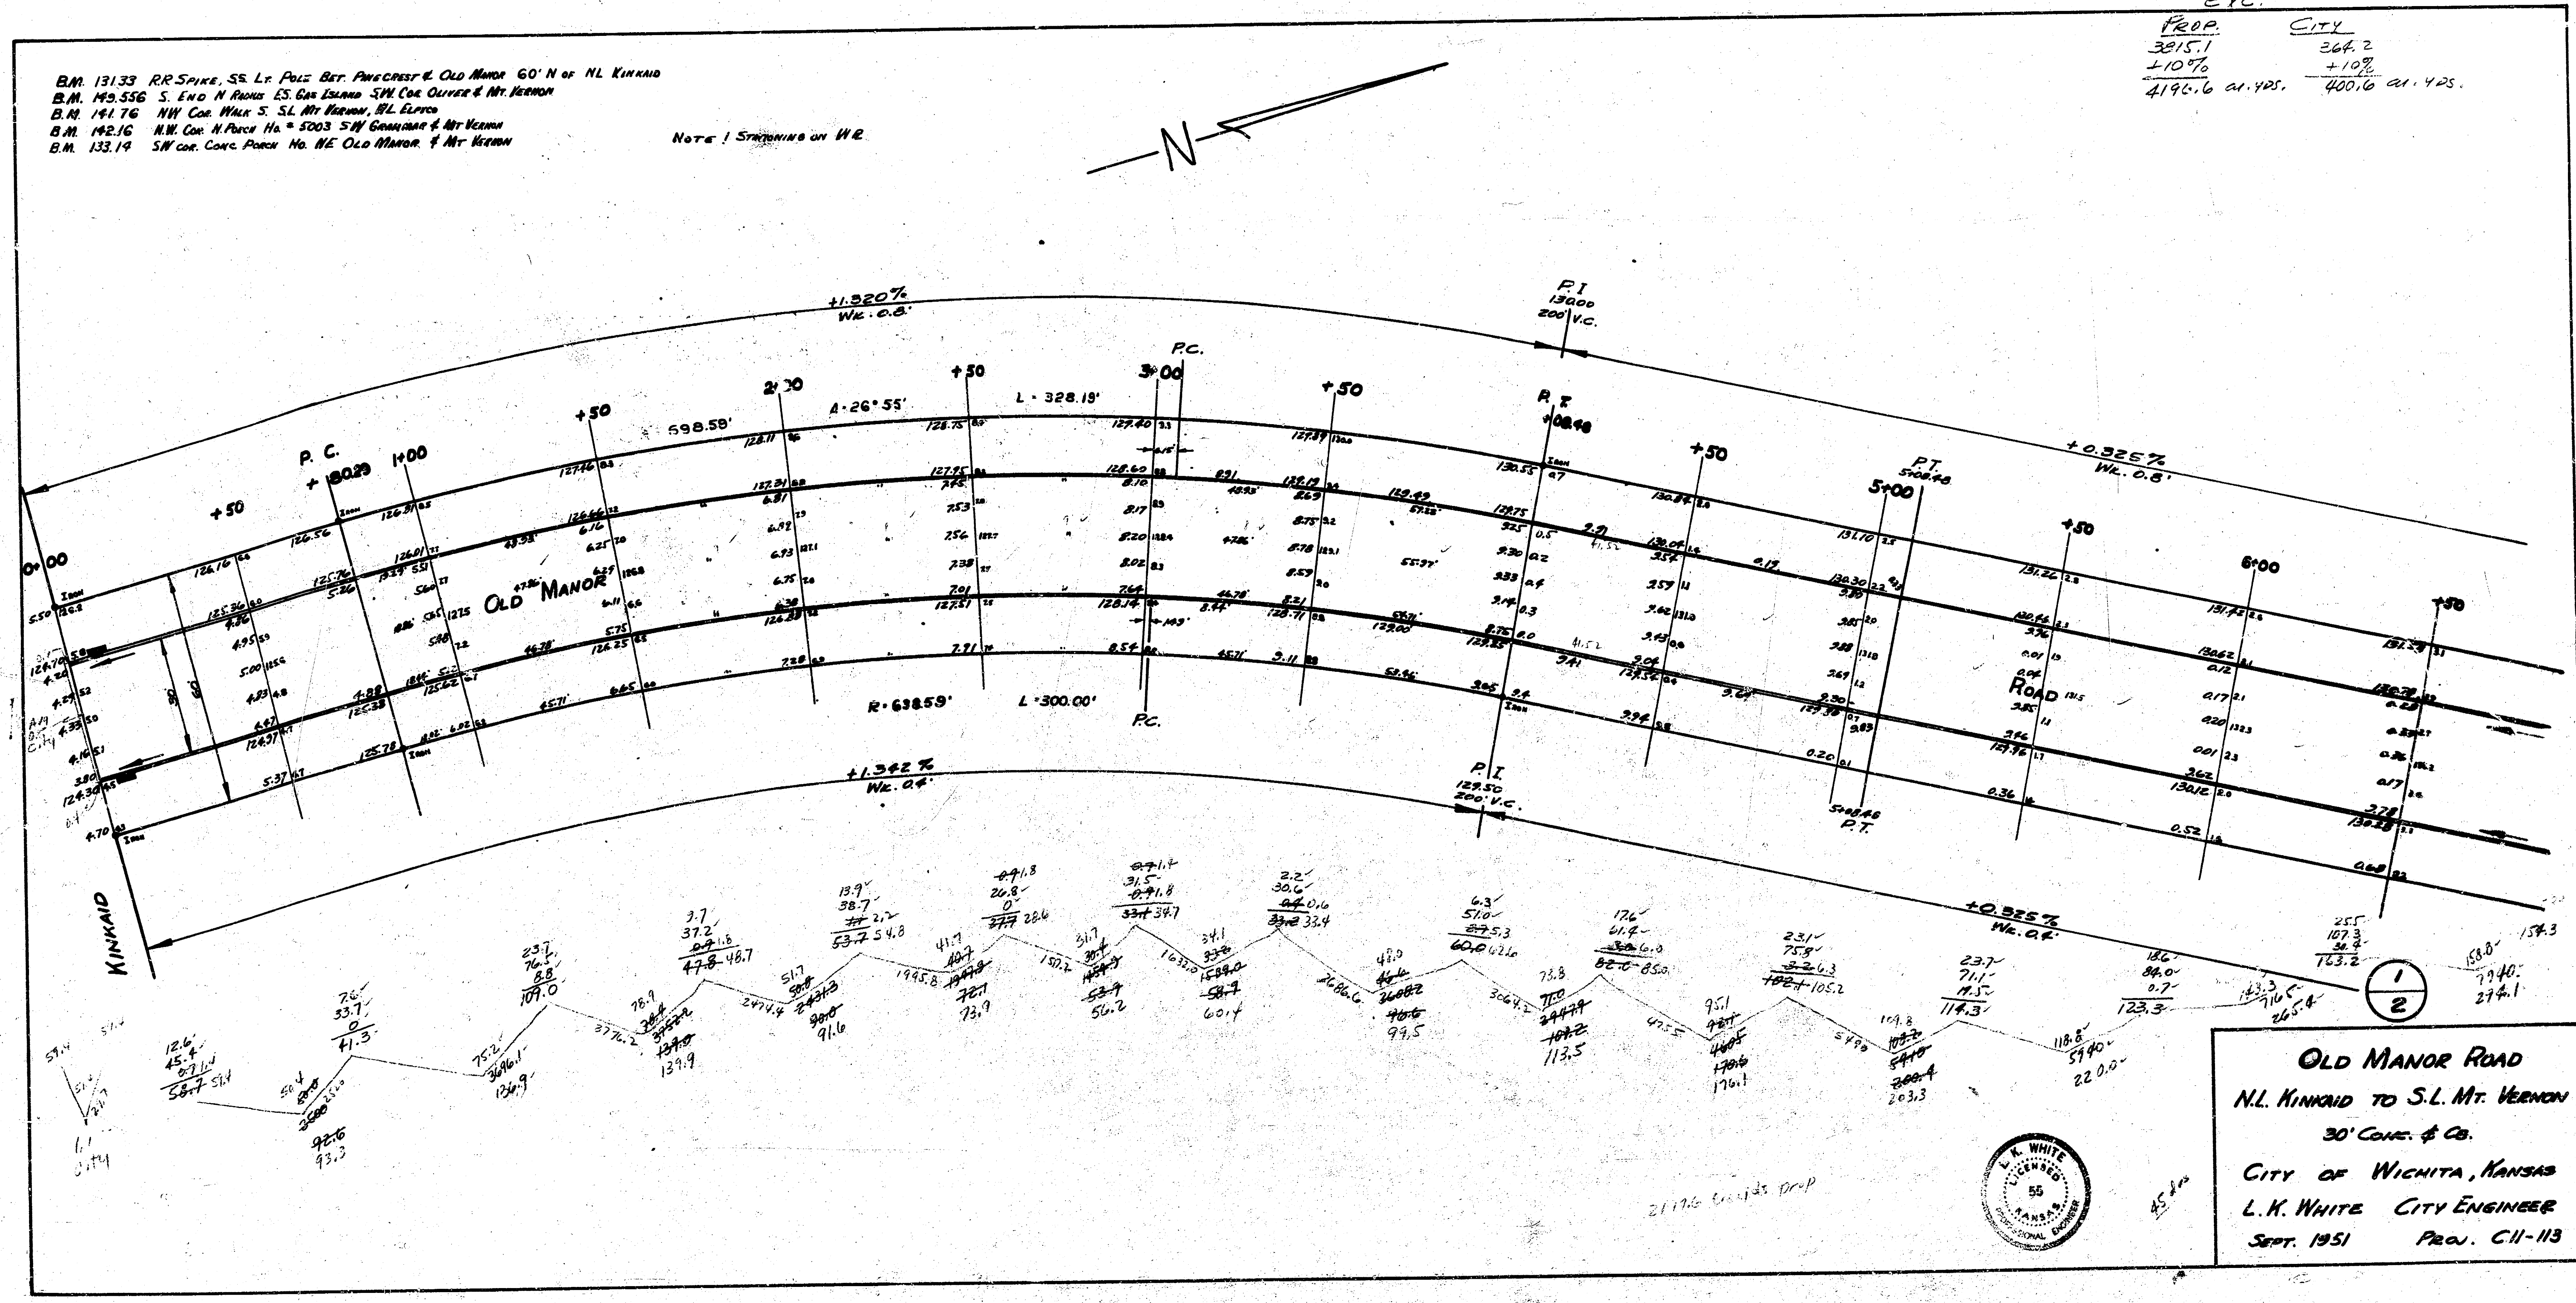


OLD MANOR ROAD
NL. KINNAID TO S.L. MT. VERNON
30' CONC. & CO.
CITY OF WICHITA, KANSAS
L.K. WHITE CITY ENGINEER
SEPT. 1951 PROJ. C11-113

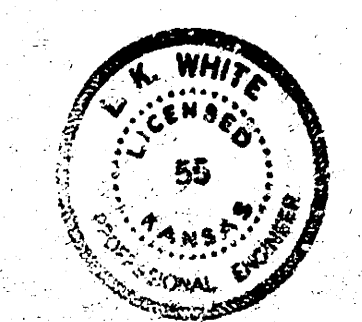

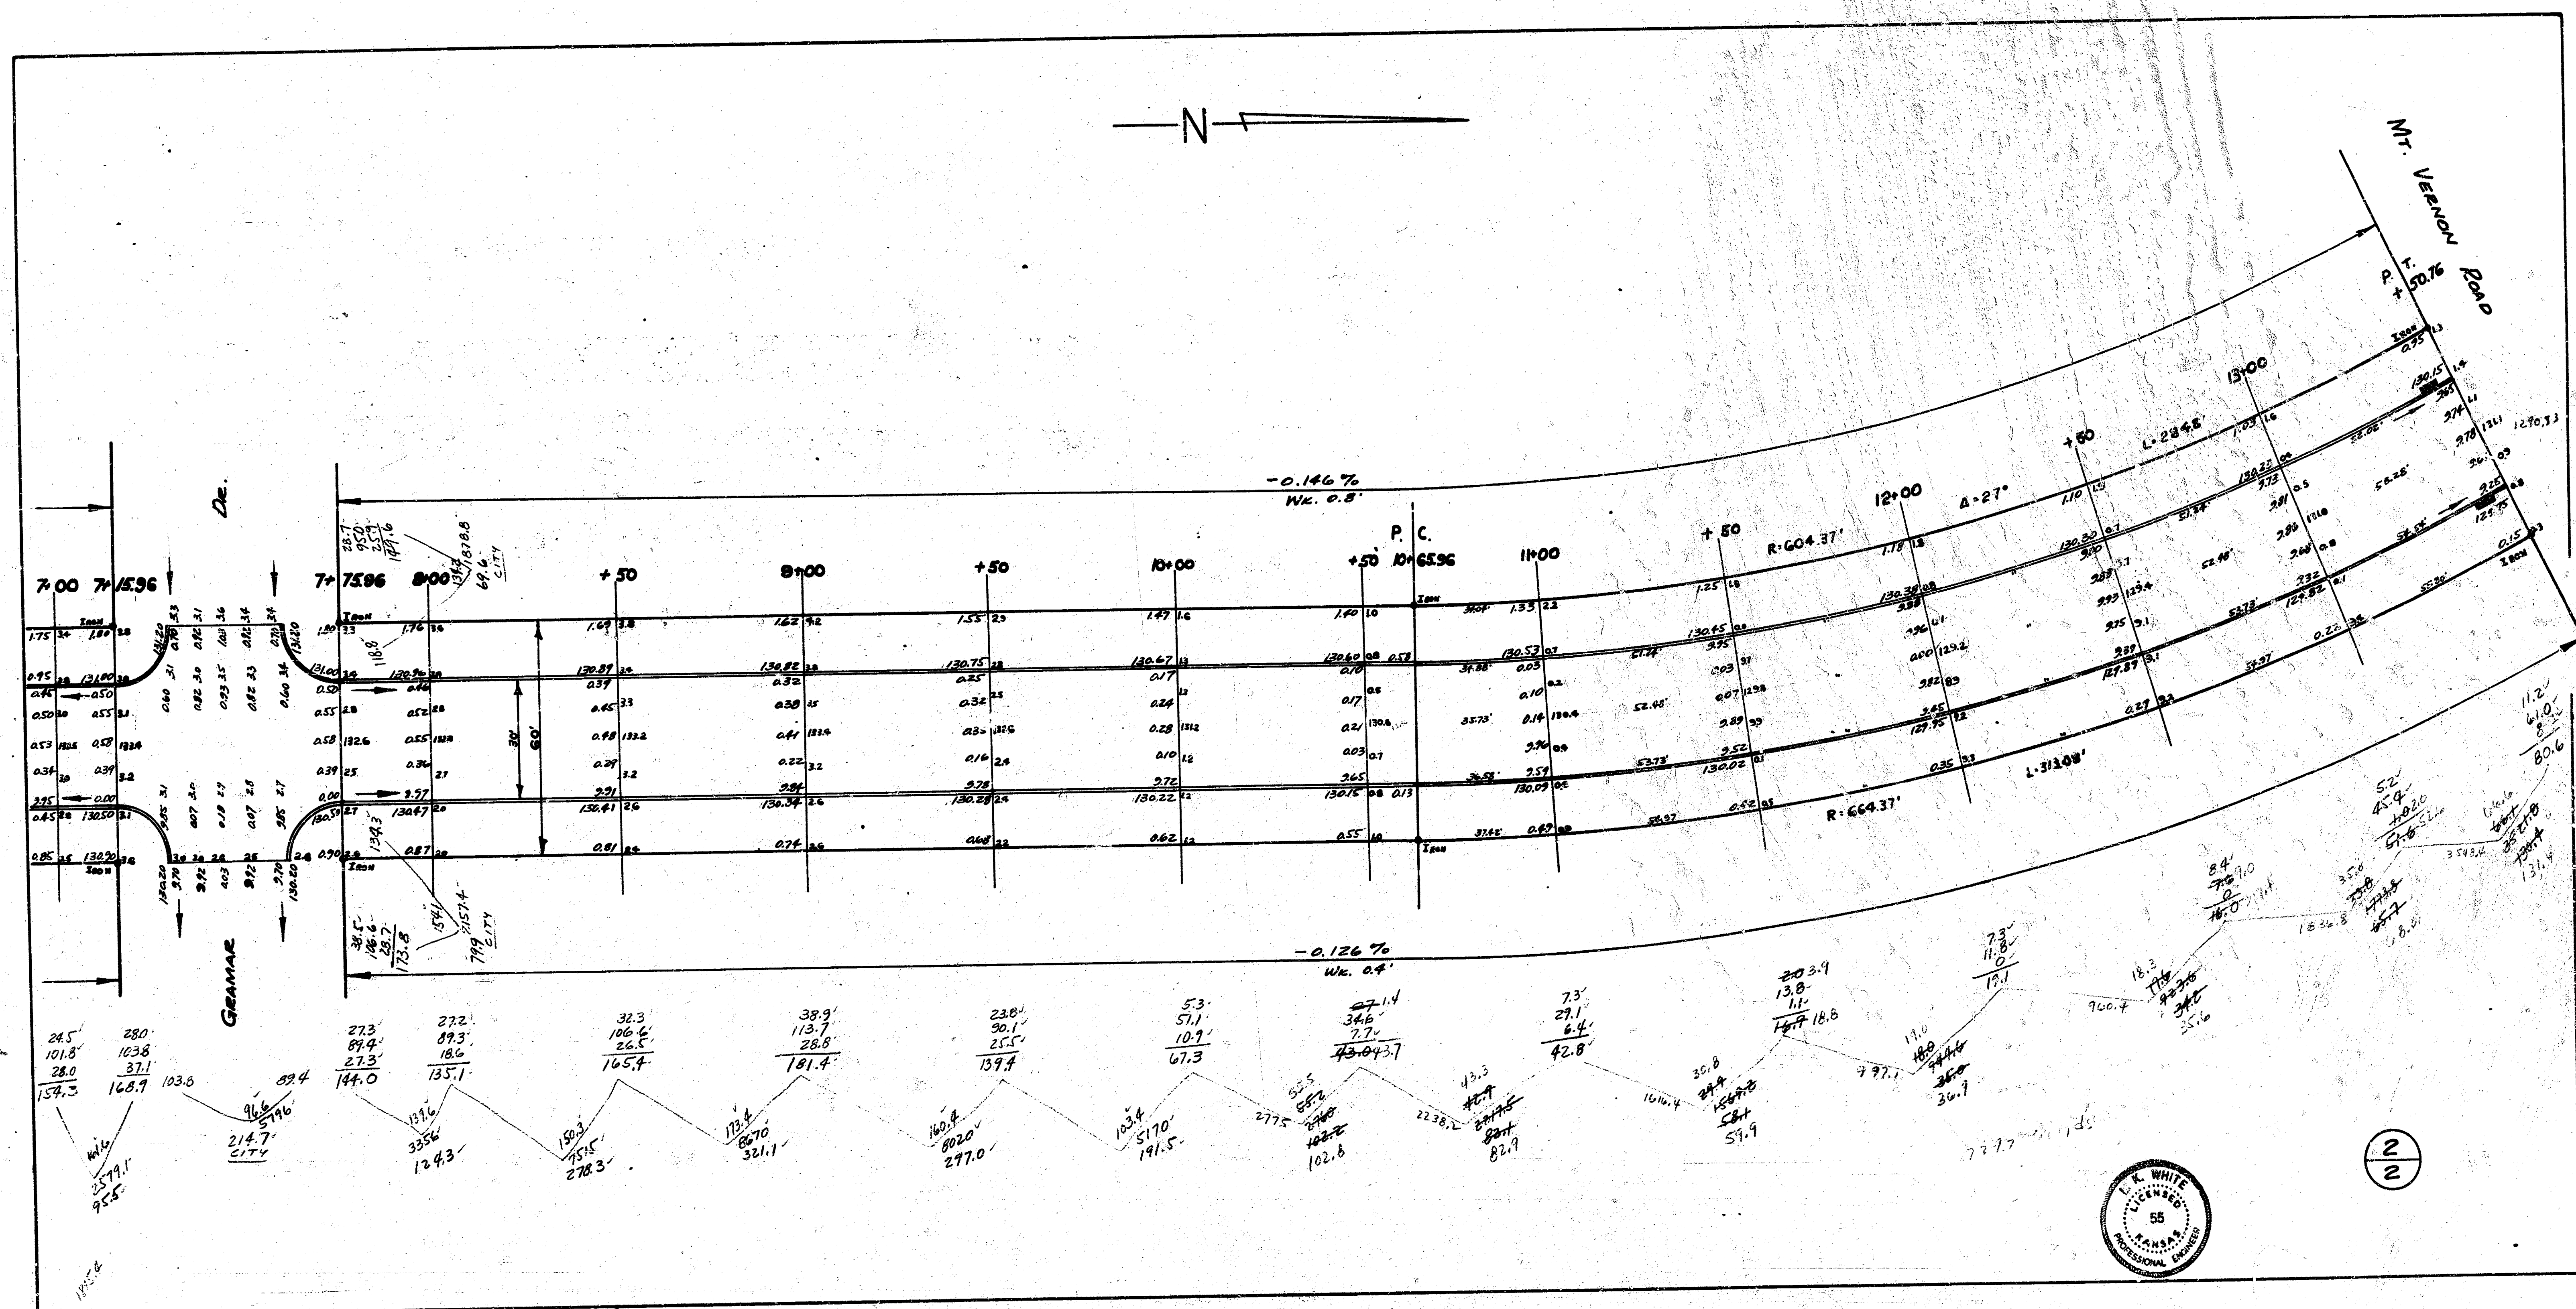

H-1

B.M. 130.61 'B' in Builders F.W.K. N.E. Cor. Mt. Vernon & Old Manor
B.M. 139.87 Standard N.W. Cor. Mt. Vernon & Edgemoor

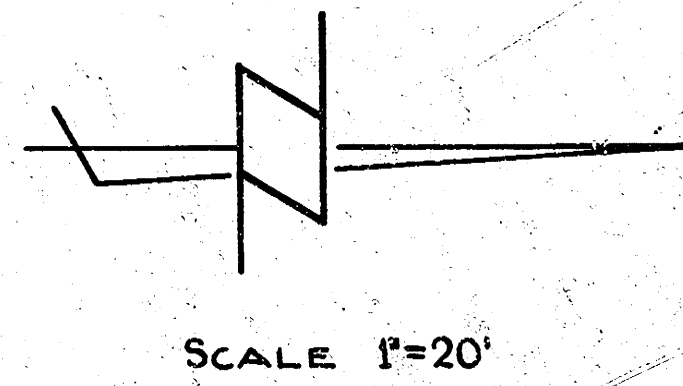

Property



Fill

106.0 x 1/2 = 53.0 cu. yds. 50' x 2

2.4 x 1/2 = 1.2 cu. yds. 47.7 tons

106.0 cu. yds. Fill

MT. VERNON ROAD

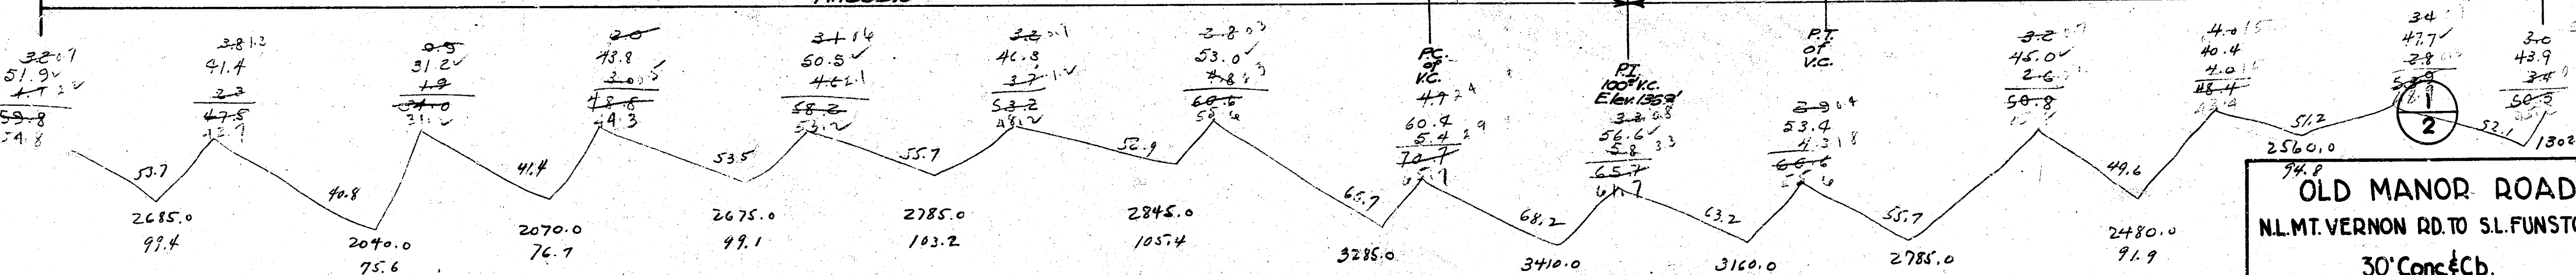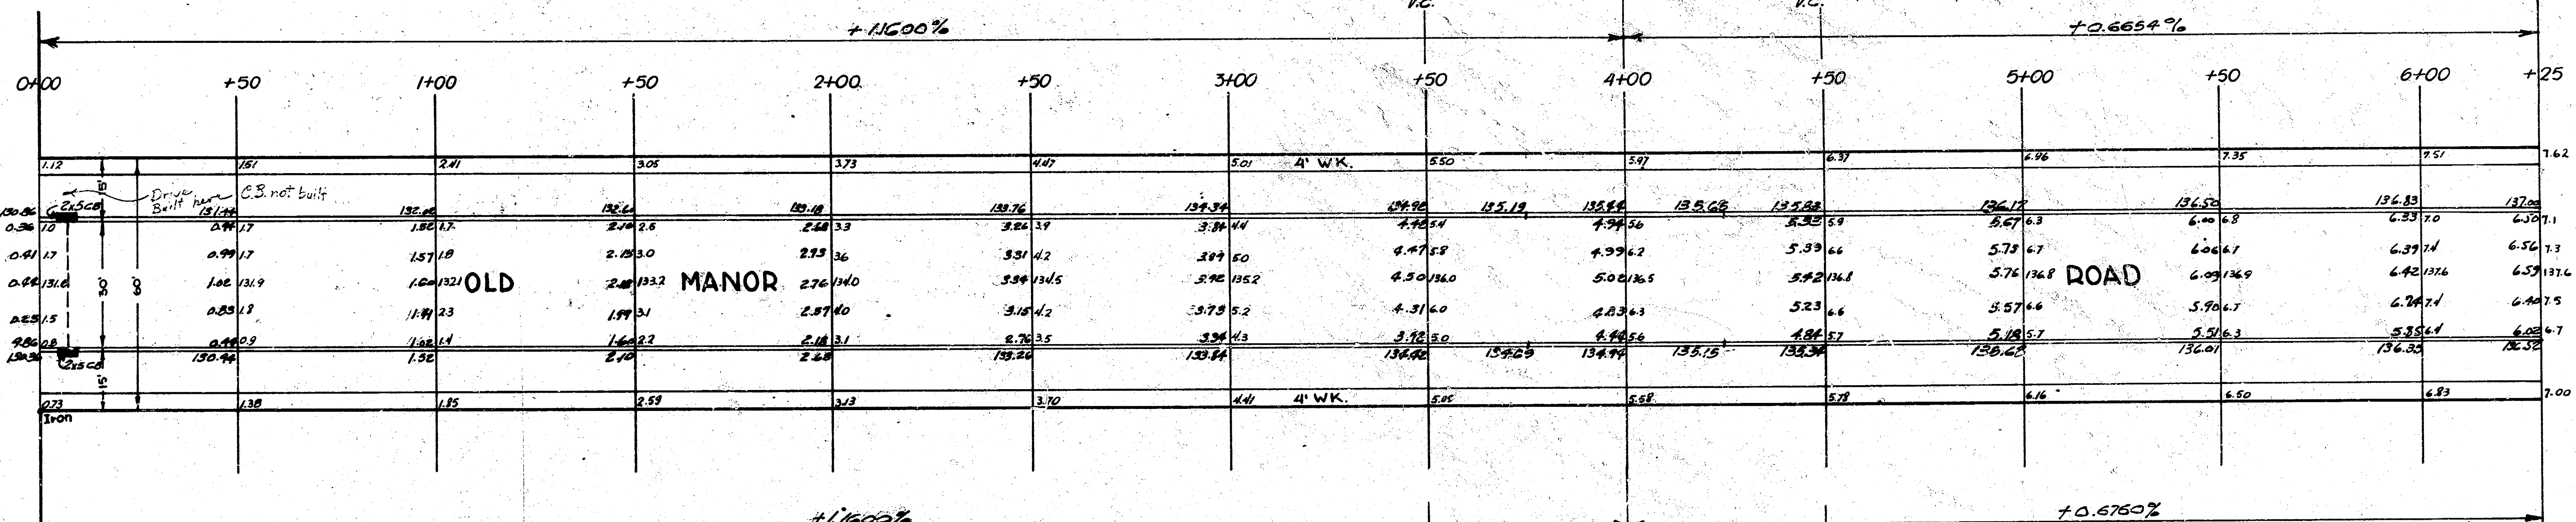

OLD MANOR ROAD
N.L. MT. VERNON RD. TO S.L. FUNSTON AVE
30' Conc. & Cb.
CITY OF WICHITA, KANSAS
L.K. WHITE CITY ENGINEER
SEPT. 1981 PROJ. NO. 111-123



H-1

