








Title Block:

Old Manor Road
 N.E. Countryside — S.L. Harry
 30' Conc. & Cb.
 City of Wichita, Kansas
 L.H. White City Engineer
 June 1949 Project C19-107

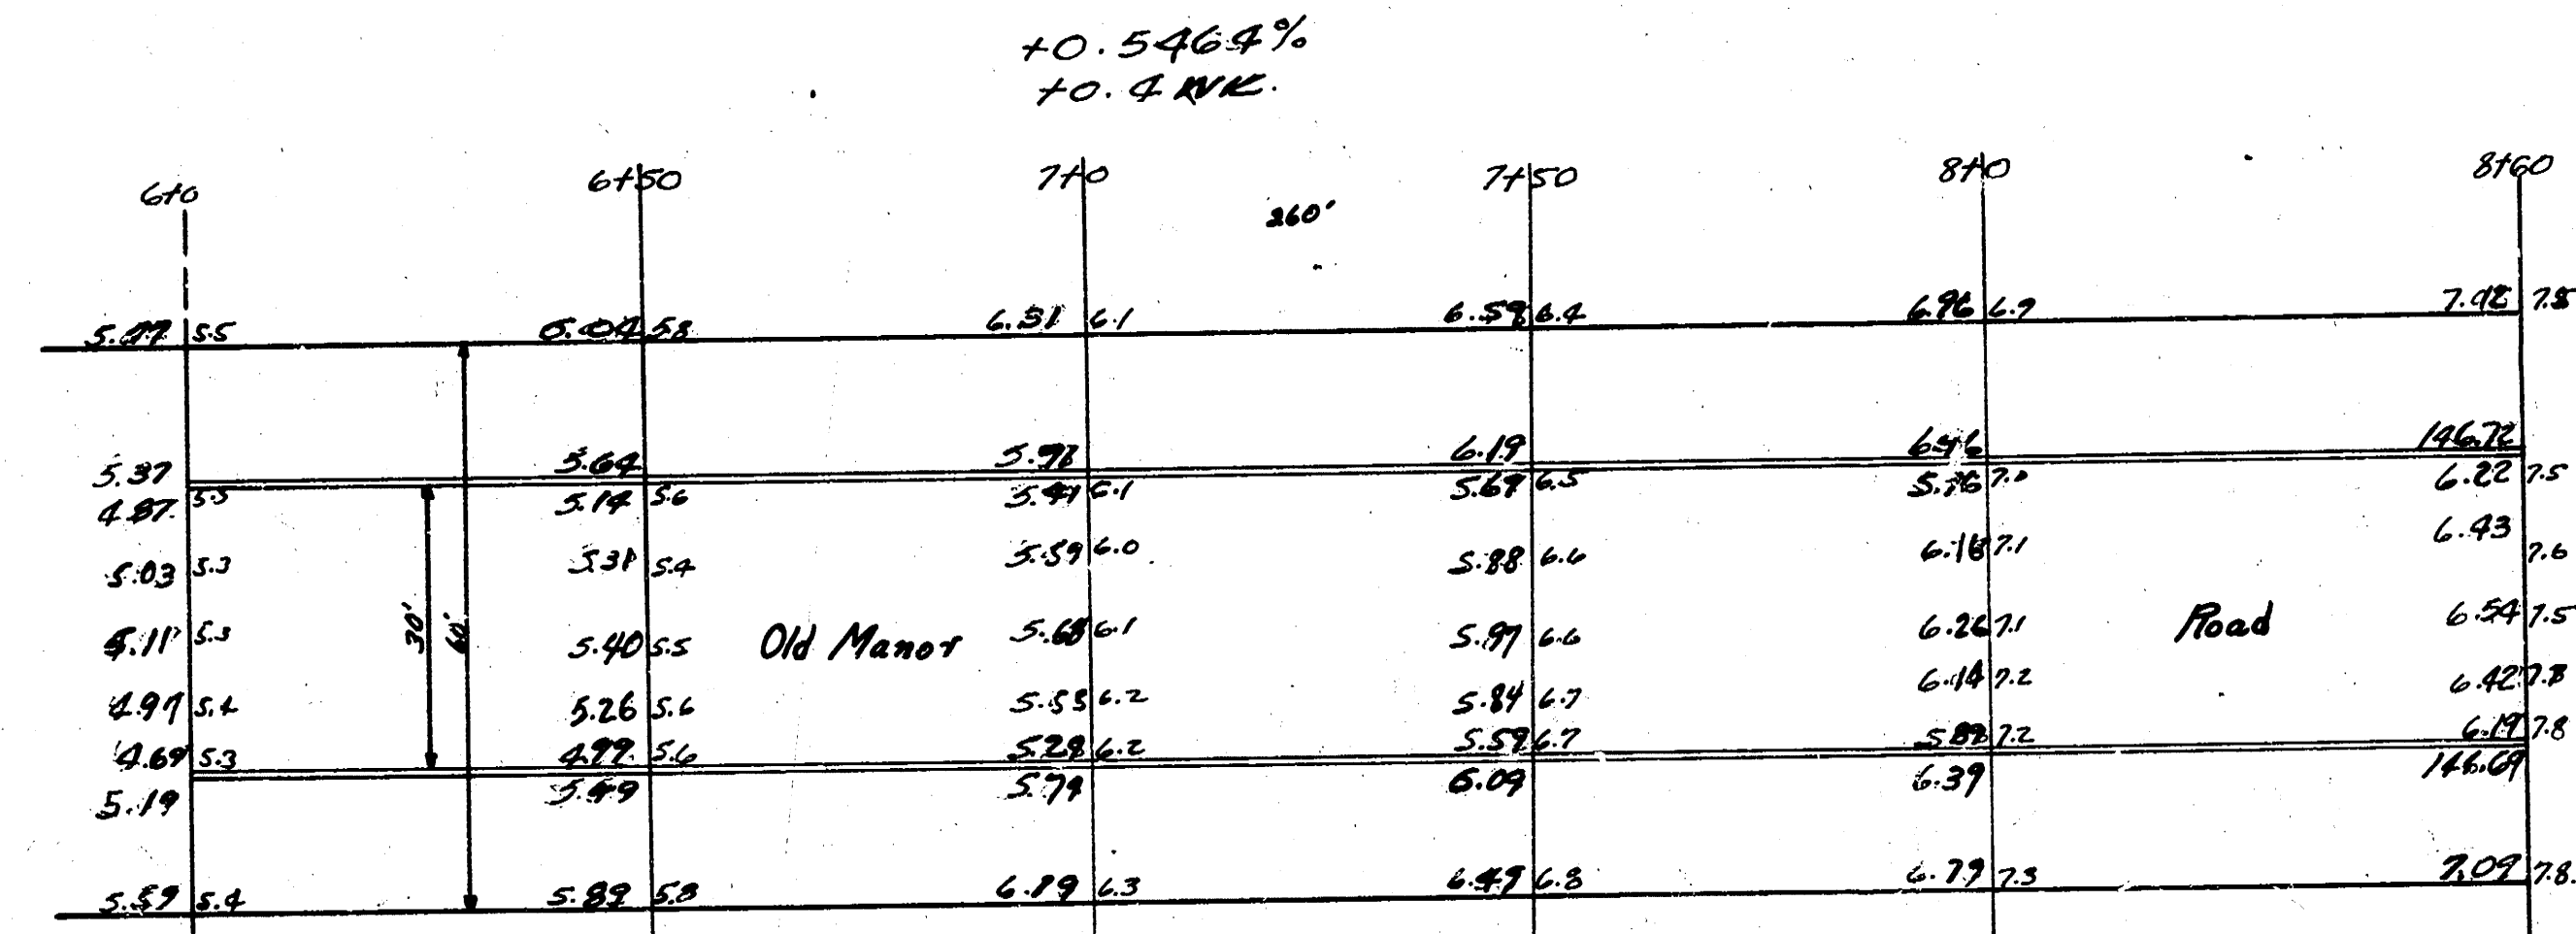

Install CRP.
 Fill ditch & make
 connection with
 Black Top or
 with Black Base
 7/6/6

Property
 123.5
 102.9
 82.6
 59.8
 51.3
 420.1 cu. yds

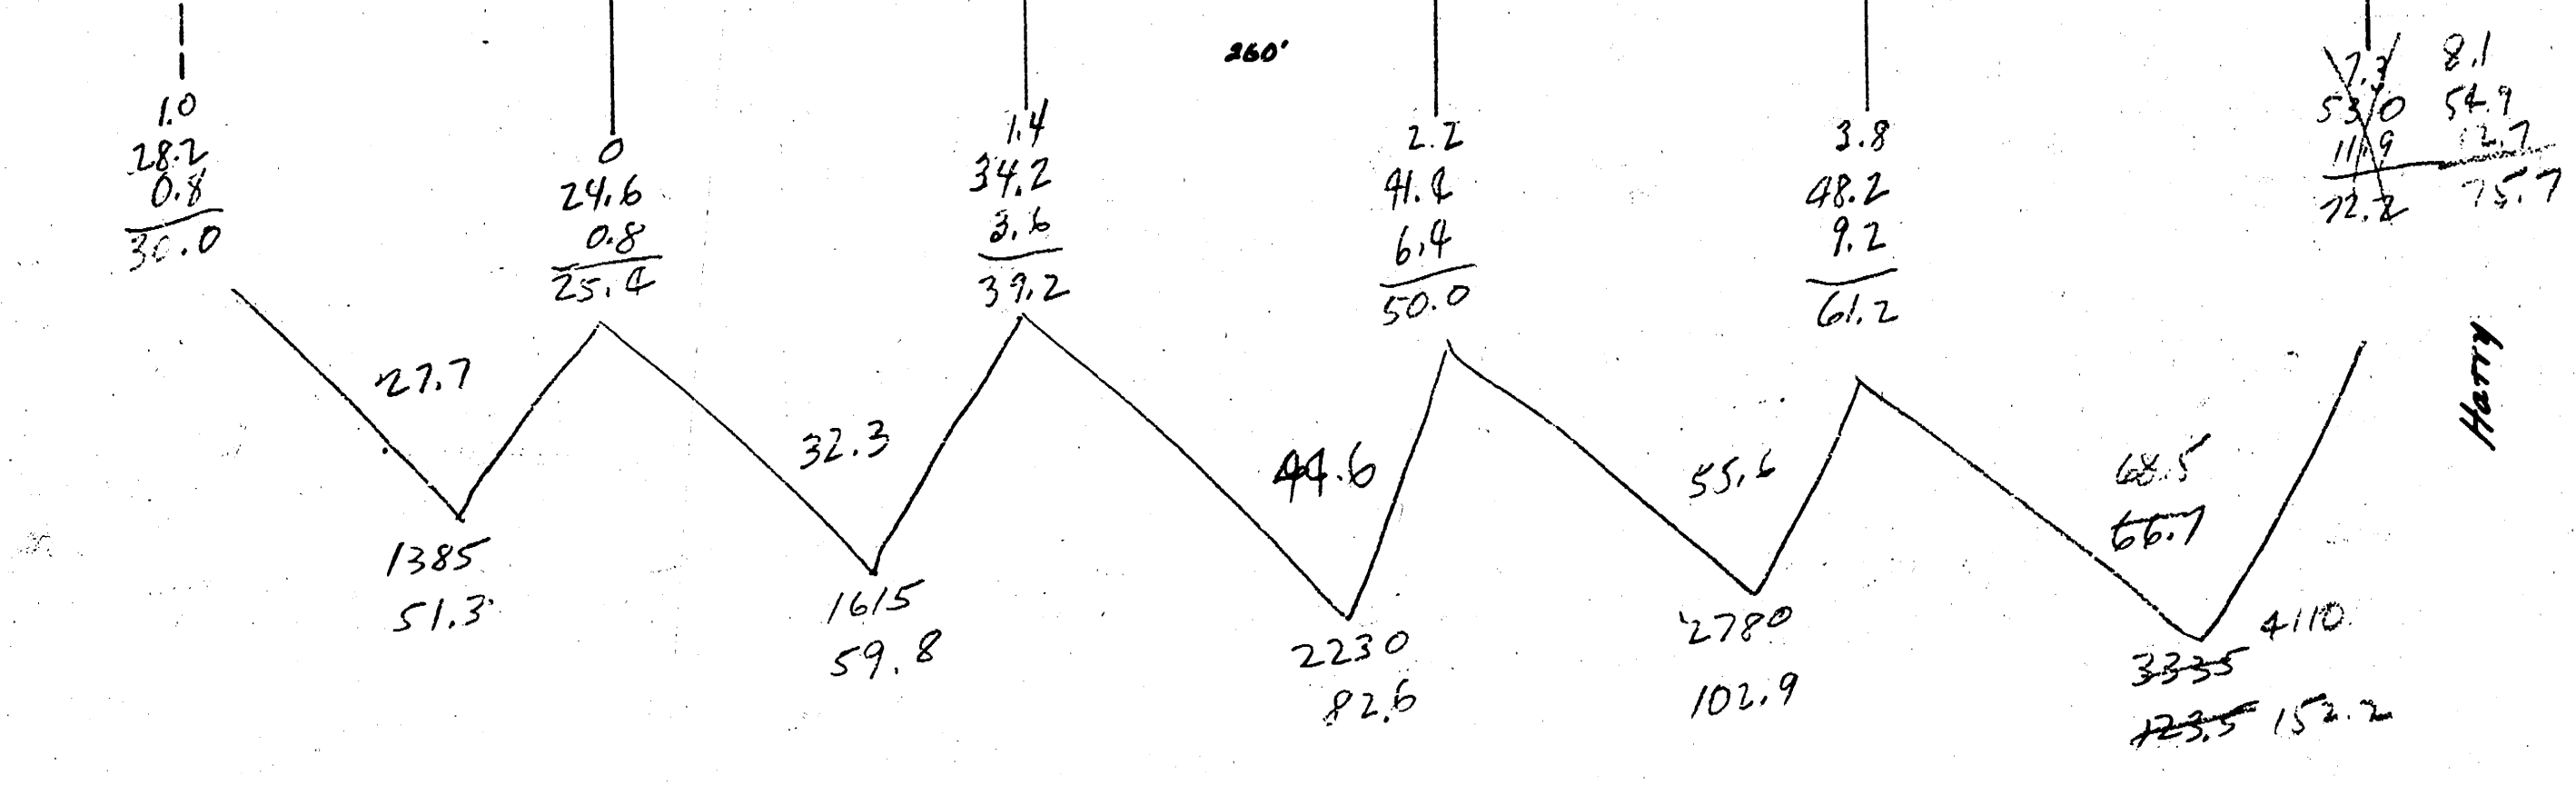

2
 2

4
 1
 4
 55