Old Manor Road - S.L. Douglas to N.L. English

30' Conc.
Int. Curb

B.M. Elevation 179.12 T.P. end of curb West side on Old Manor.

Flatten the ~~grade~~ crown from 5+68 to .1 above the gutters at 6+0 on account of valley gutter East & West on North side of English

Pete

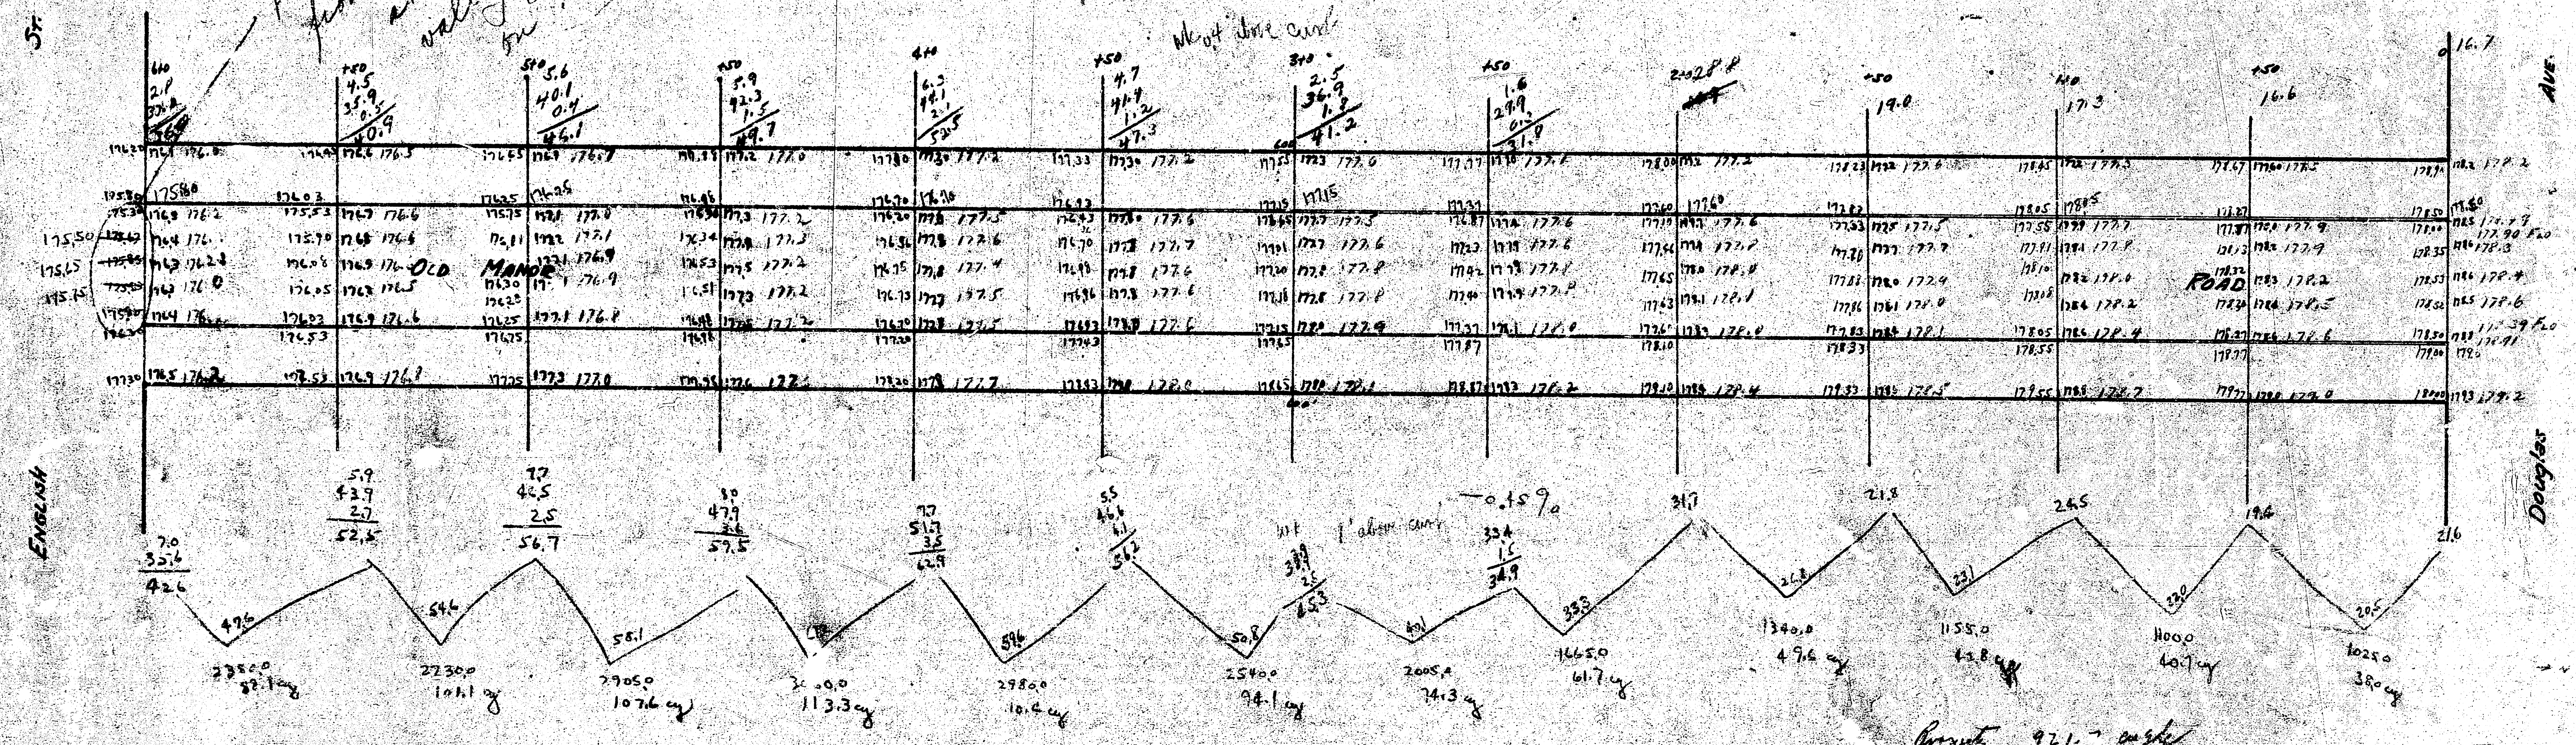

English St.
OLD MANOR ROAD
Douglas Ave.
6+0
+50
5+0
+50
4+0
+50
3+0
+50
2+028.8
+50
1+0
+50
0
16.7
17.3
16.6
19.0
Nk of line curb
1' above curb
-0.15%
42.6
52.5
56.7
57.5
62.9
56.2
45.3
34.9
31.7
21.8
24.5
19.6
21.6
2350.0
87.1 cy
2230.0
101.1 cy
2905.0
107.6 cy
3060.0
113.3 cy
2980.0
110.4 cy
2540.0
94.1 cy
2005.0
74.3 cy
1665.0
61.7 cy
1340.0
49.6 cy
1155.0
42.8 cy
1100.0
40.7 cy
1025.0
38.0 cy

Property 921.7 cu yds
+ 10% 92.2
Total 1013.9 cu yds