


B.M. 11823 Top W. end conc. pipe N.S. Frisco RR. @ W.S. Grove.  
 B.M. 11542 6" in Globe ctr wk.E. back of cb. S.E. corner Spruce & Murdock.

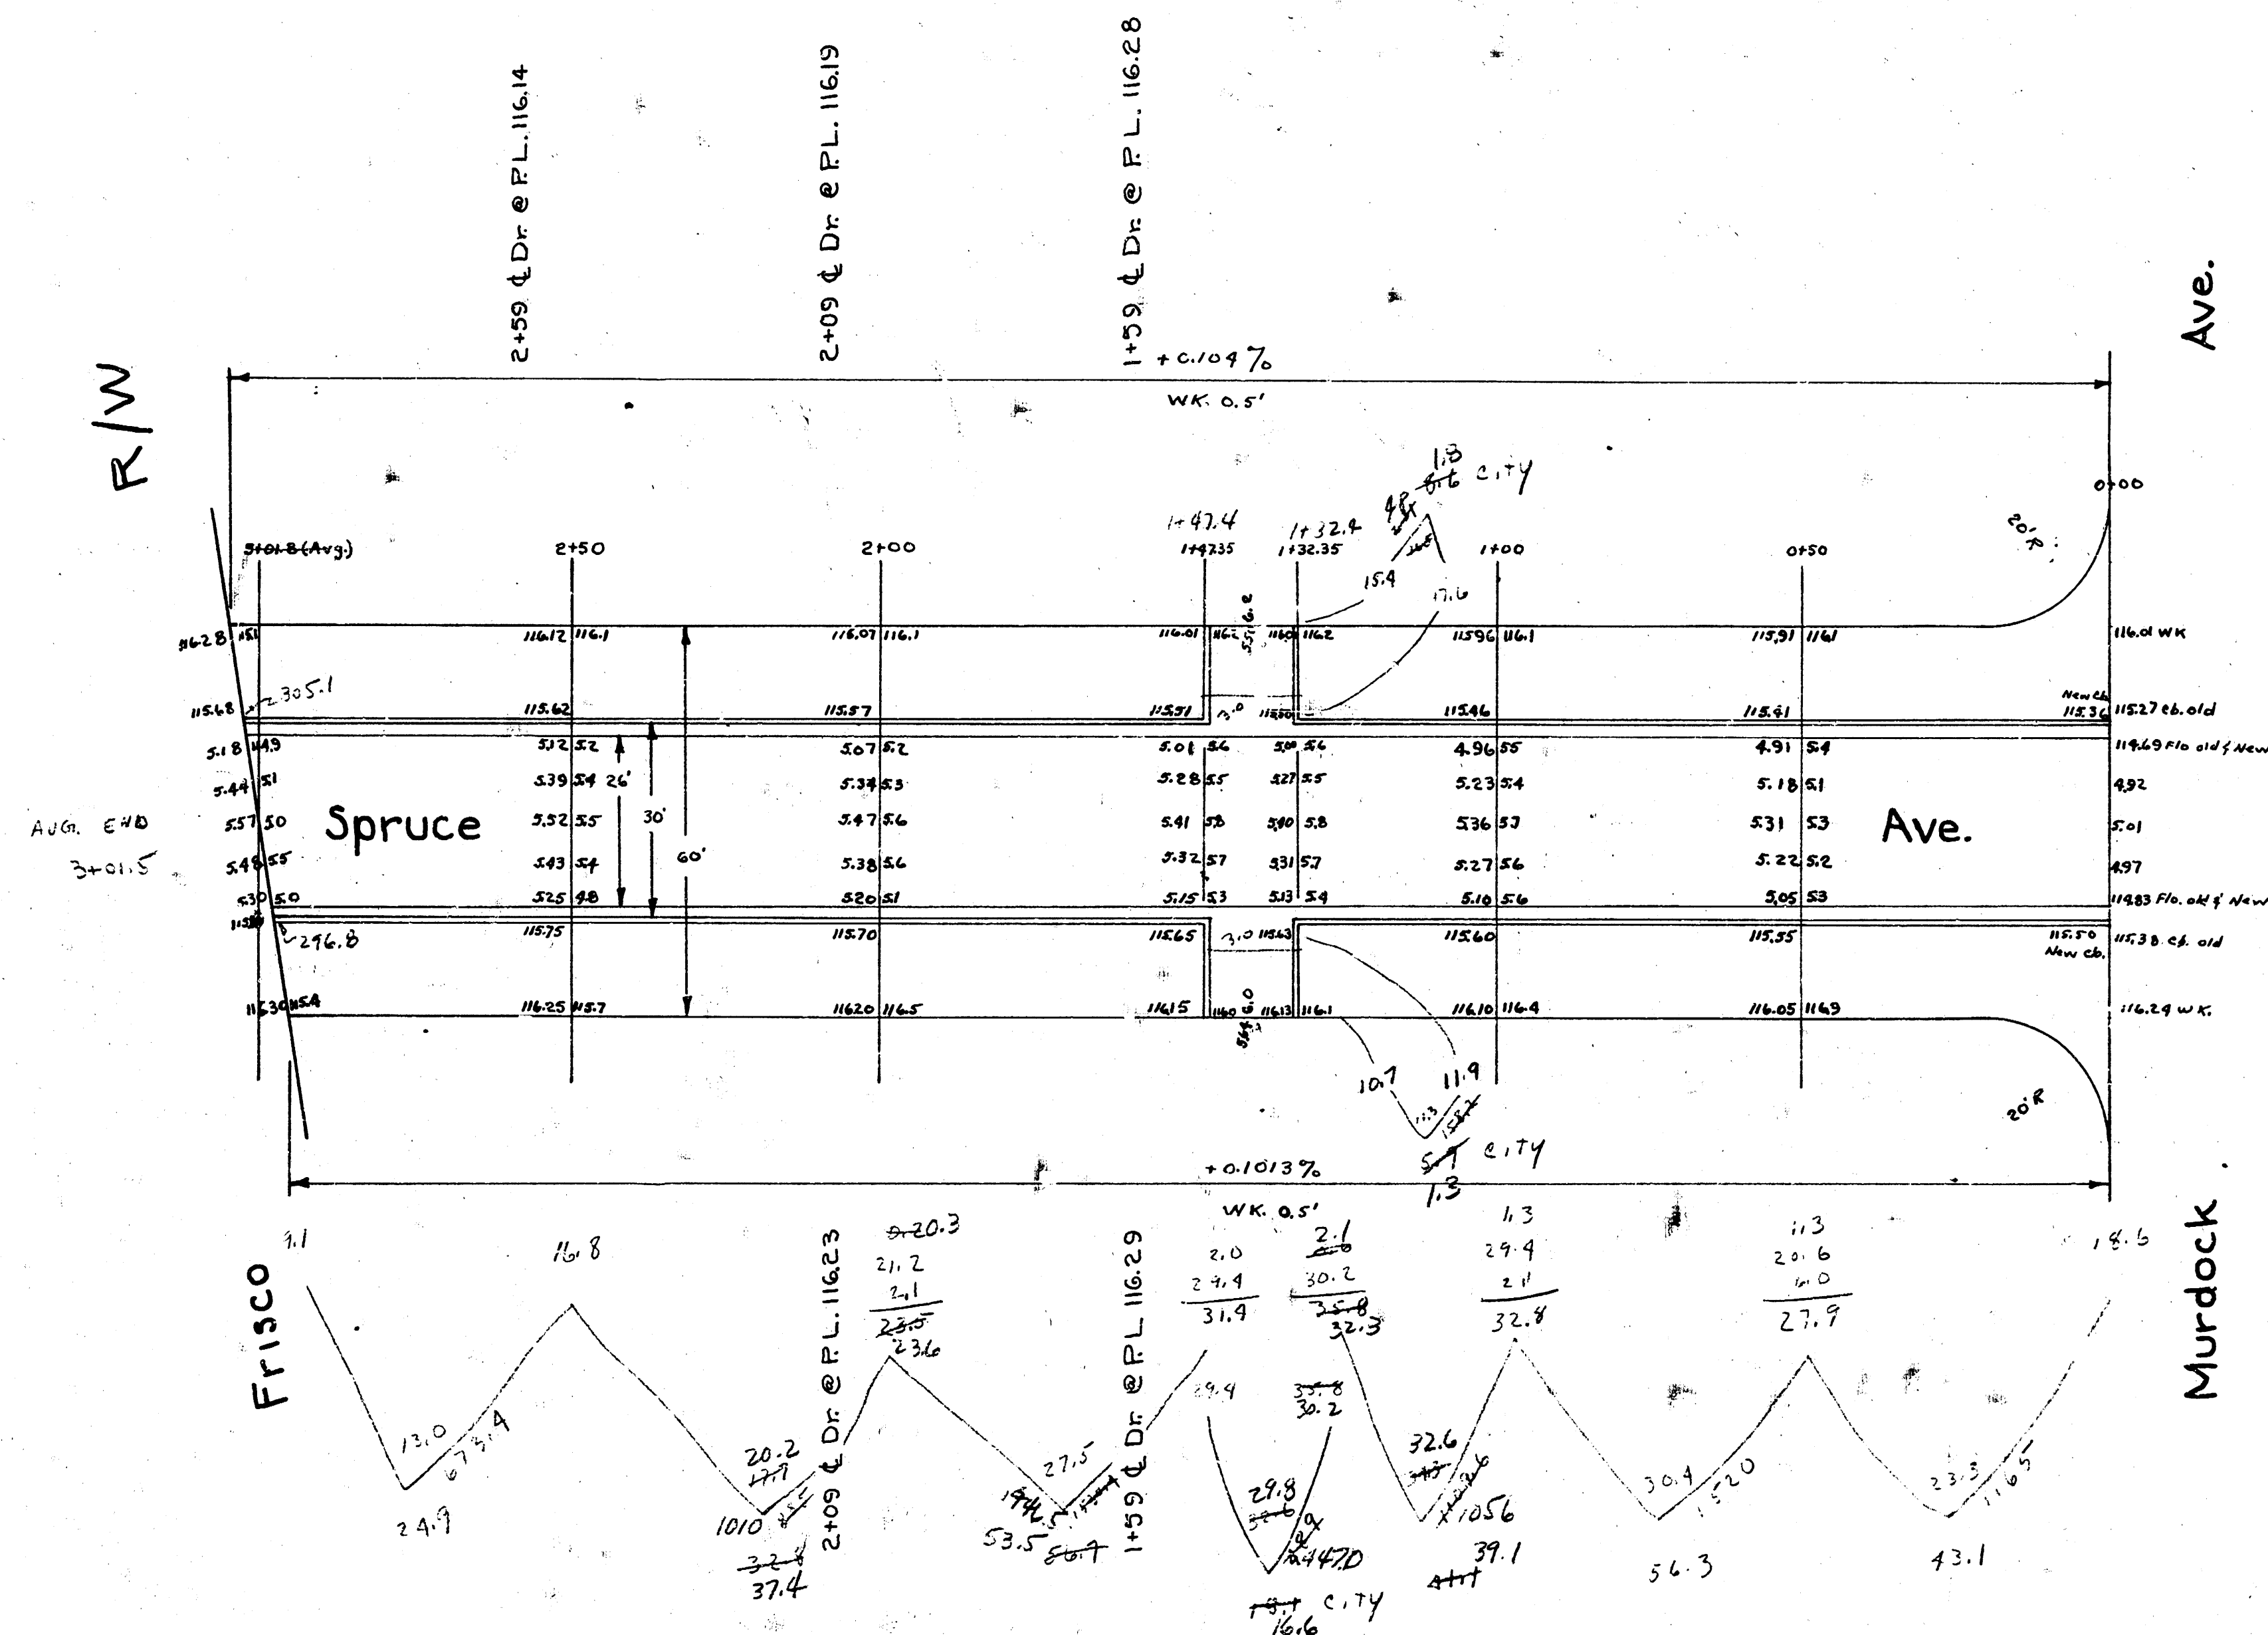

| PROP.          | CITY          |
|----------------|---------------|
| 27.9           | 18.1          |
| 32.8           | 8.0           |
| 56.7           | 5.0           |
| 41.1           | 32.2          |
| 52.3           | +107.0        |
| 42.1           |               |
| 254.9          | 30.1 34.7 46. |
| 280.9 24.7 46. |               |

Spruce Ave.  
 S.L. Murdock - N.L. Frisco R/W  
 26'-2'-30' A.C.  
 City of Wichita, Kansas  
 L.K. White - City Engineer  
 March 1949 Proj. # C-19-33