B.M 125.77 S.W. Cor. porch house # 1808 E.S. Spruce

Property	C.T.	Total Property
68.0	23.7	906.9
75.6	28.6	1300.1
77.0	13.6	2207.0
73.7	165.9	
74.1	110%	110%
74.1	182.5 Cu Ft	2427.7 Cu Ft
71.5	Total	
74.1		
75.2		
75.0		
90.6 Cu Ft		

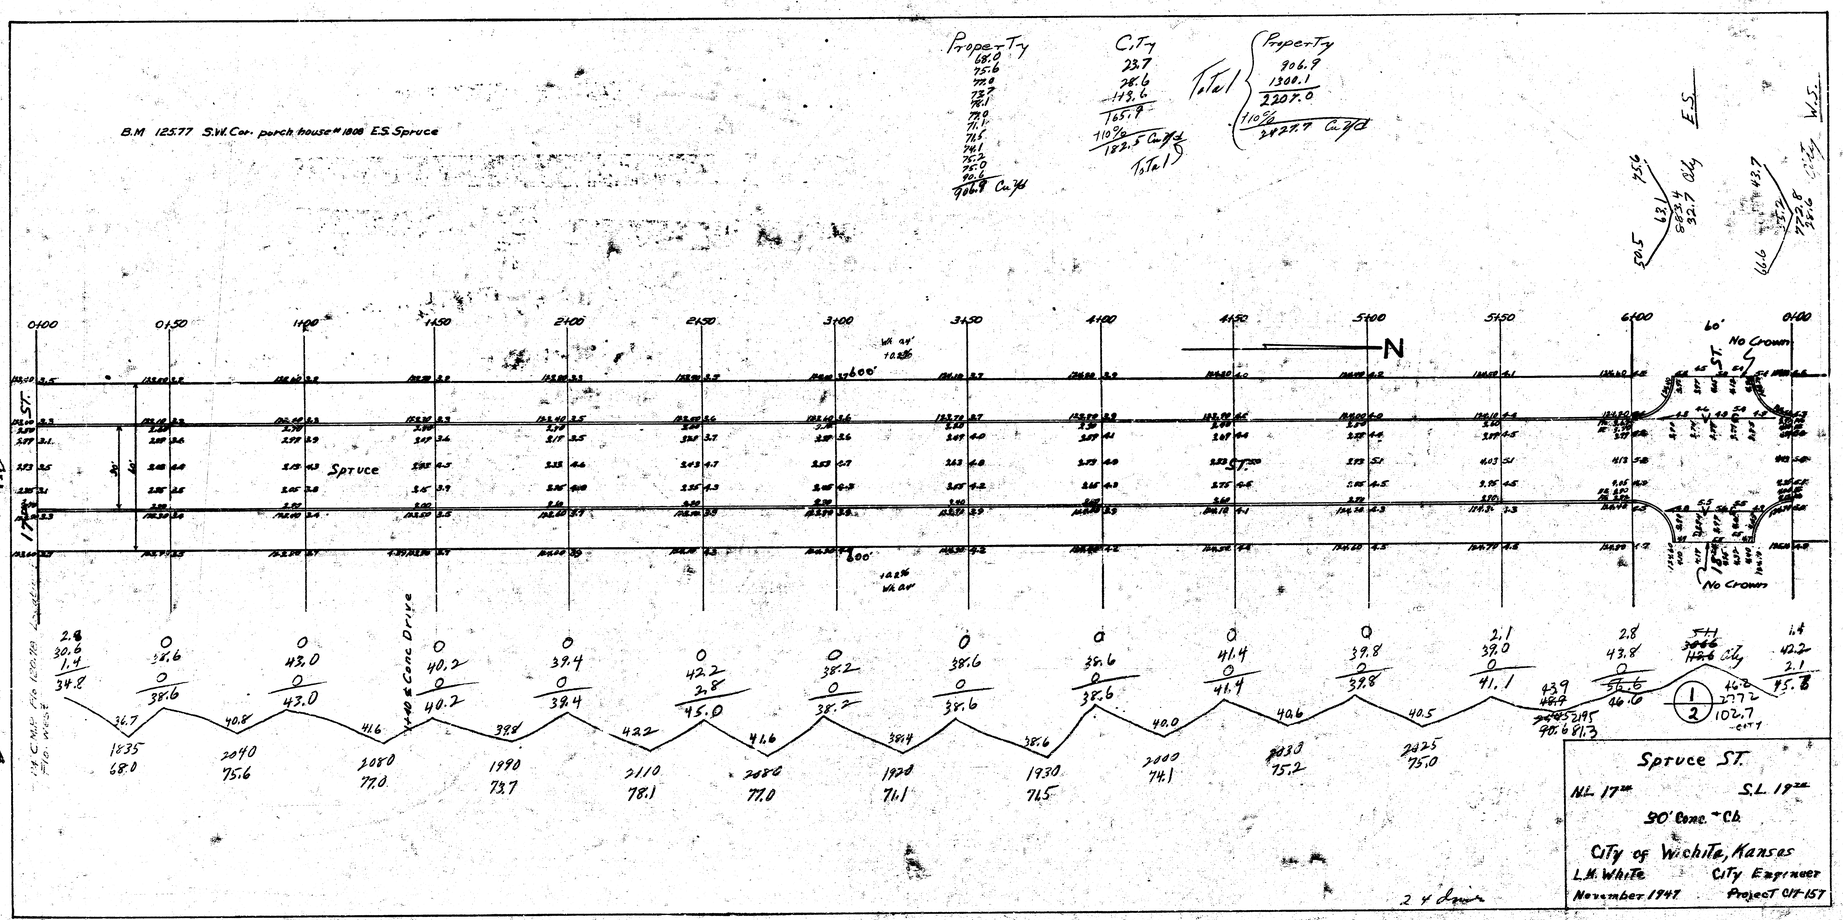

B.M. 130.52 "G" INGLOBE S.S. OF DRIVE. 2082 GROVE (19TH) ON WK.
B.M 124.56 "T" IN THACKERY in WWK E NE. GROVE & 17TH.

Property
81.3
82.0
87.8
84.1
103.0
146.1
168.1
119.6
106.3
79.1
1300.1

0+00 0+50 1+00 1+50 2+00 2+50 3+00 3+50 4+00 4+50 5+00 5+50 5+85.17

40.23% Wt. 0.5'

585.17

40.23% Wt. 0.5'

N

S.T.

Spoke

S.T.

19TH

30'

45'

1.4	0	0	0	0	1.3	3.1	9.5	6.2	4.9	3.2	3.5	10.5
42.2	40.2	45.4	45.4	41.3	46.1	54.8	72.0	65.5	58.3	46.6	47.4	52.8
2.1	1.8	2.2	1.8	2.2	2.0	3.9	14.4	13.9	10.4	7.7	6.3	10.9
45.7	42.0	47.6	47.2	43.5	49.4	61.8	95.9	85.6	71.6	57.5	57.2	80.2
43.9	44.8	47.4	45.4	46.5	55.6	78.9	90.8	78.6	64.6	57.4	68.7	
2135	2240	2370	2270	2325	2780	3945	4540	3930	3230	2870	3435	4016.2
81.3	83.0	87.8	84.1	86.1	103.0	146.1	168.1	145.6	119.6	106.3	127.1	

2 Lanes

Spruce ST.
NL. 17TH SL. 19TH

(2/2)

(2) 13 A