

B.M. "C" IN RITCHIE TOP COR. N.E. HOODSON W.S. MINNESOTA 98.26
B.M. "N" IN NUGLER. P.P. N.W. COR. MINNESOTA & STAFFORD 99.32


TOTALS

PROP.	WIDENING
491.4	294.6
+10% 540.5	+10% 324.1
CU. YDS. Exc.	CU. YDS. Exc.

Note: Field Engr

Exc. Intersection to match pavt.
on Swan & Stafford. X-sect. for exc.
Install C.B. & lead to M.H.

SCALE: 1"=20'

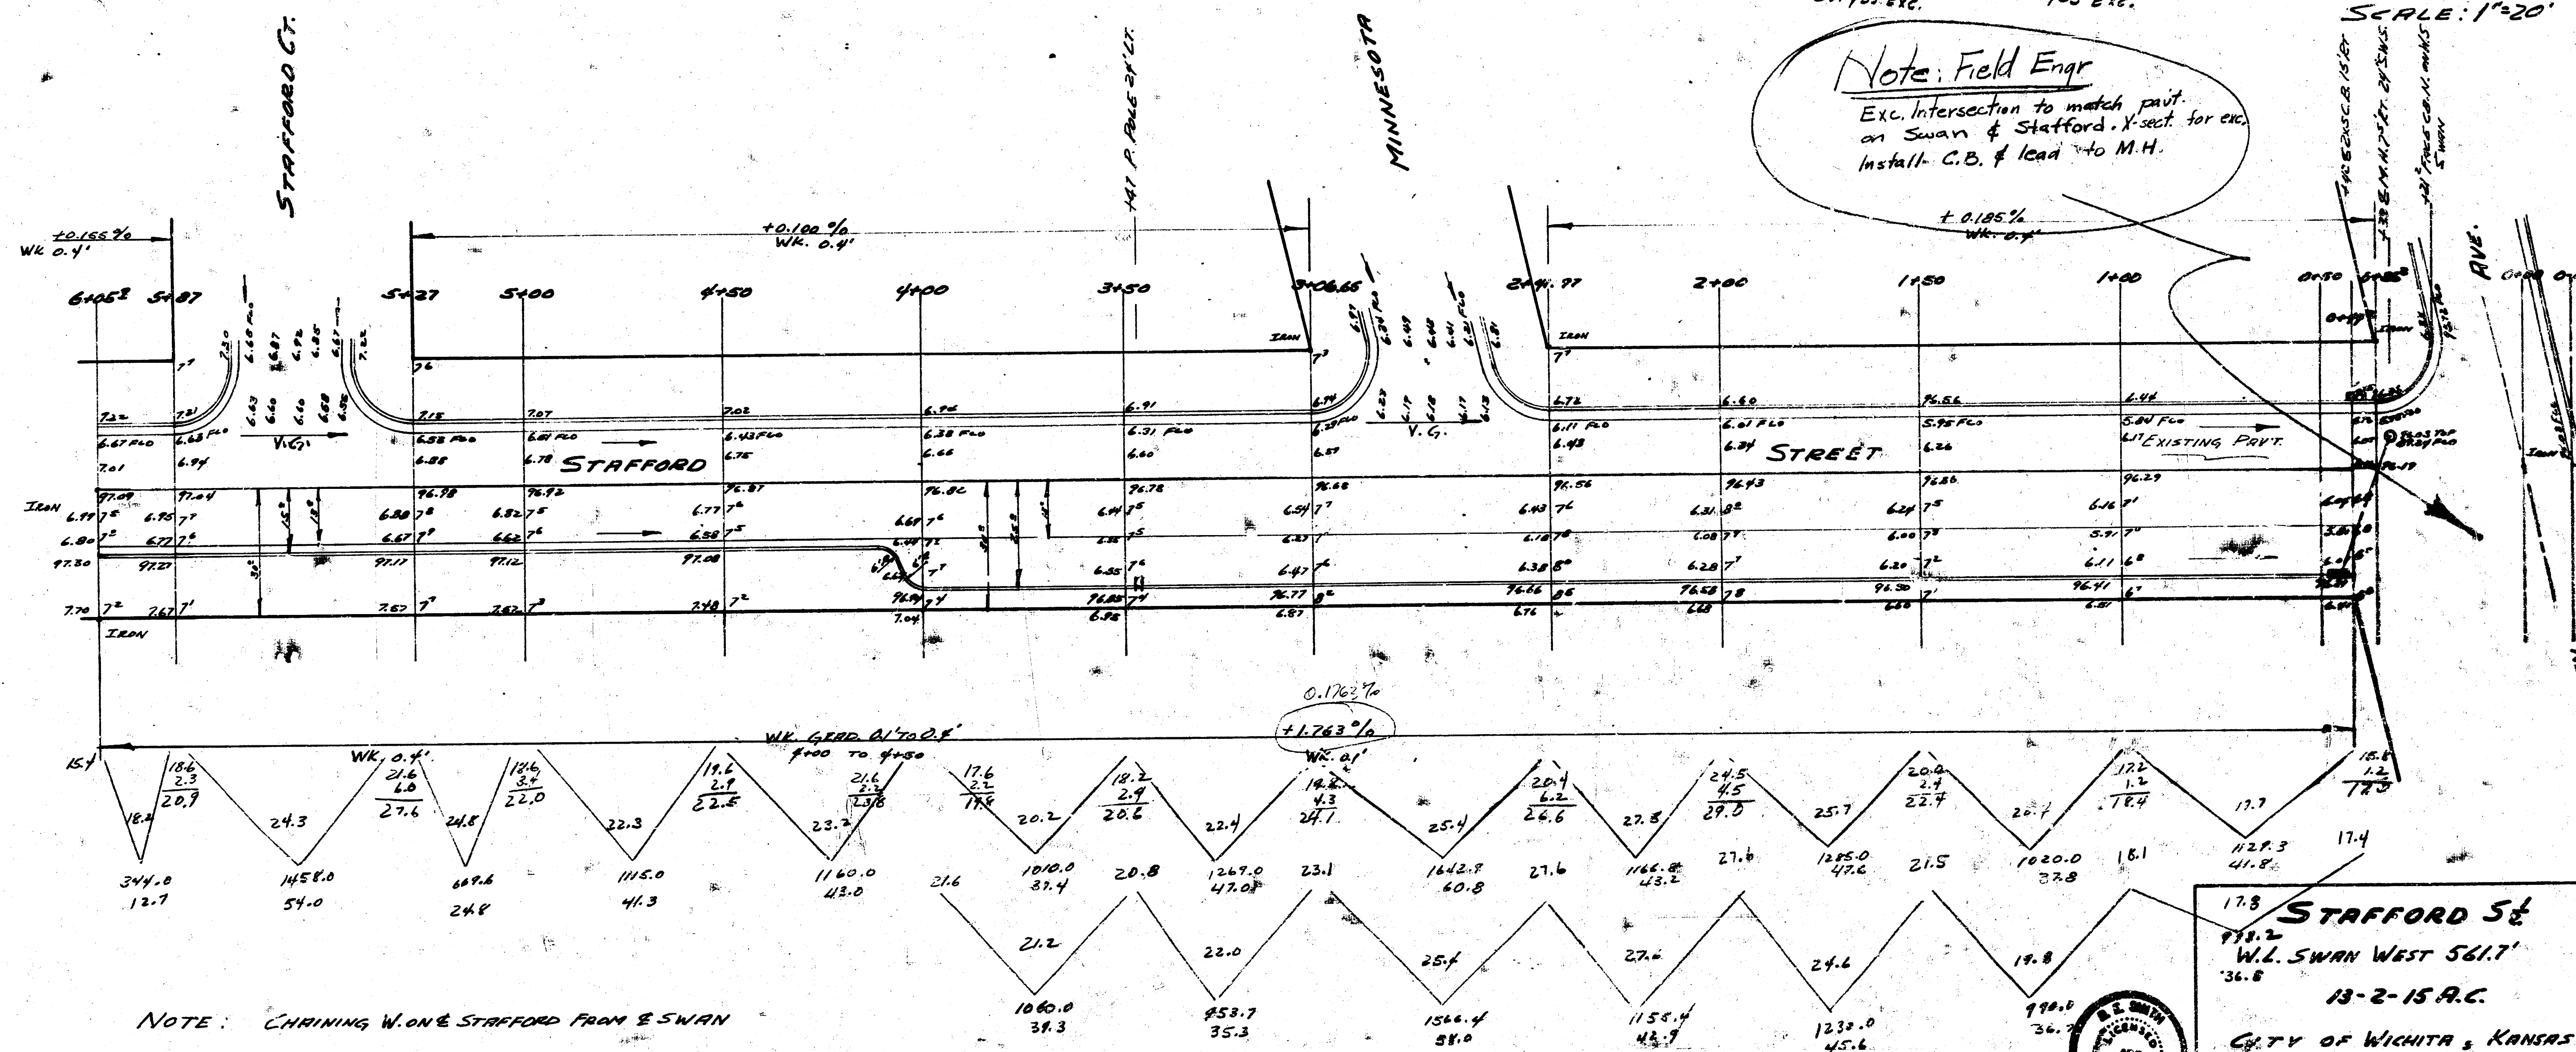

NOTE: CHAINING W. ON STAFFORD FROM E SWAN



STAFFORD St
W.L. SWAN WEST 561.7'
13-2-15 A.C.
CITY OF WICHITA, KANSAS
L.K. WHITE CITY ENGINEER
JULY, 1932 PRIVATE

1 5 5 3