
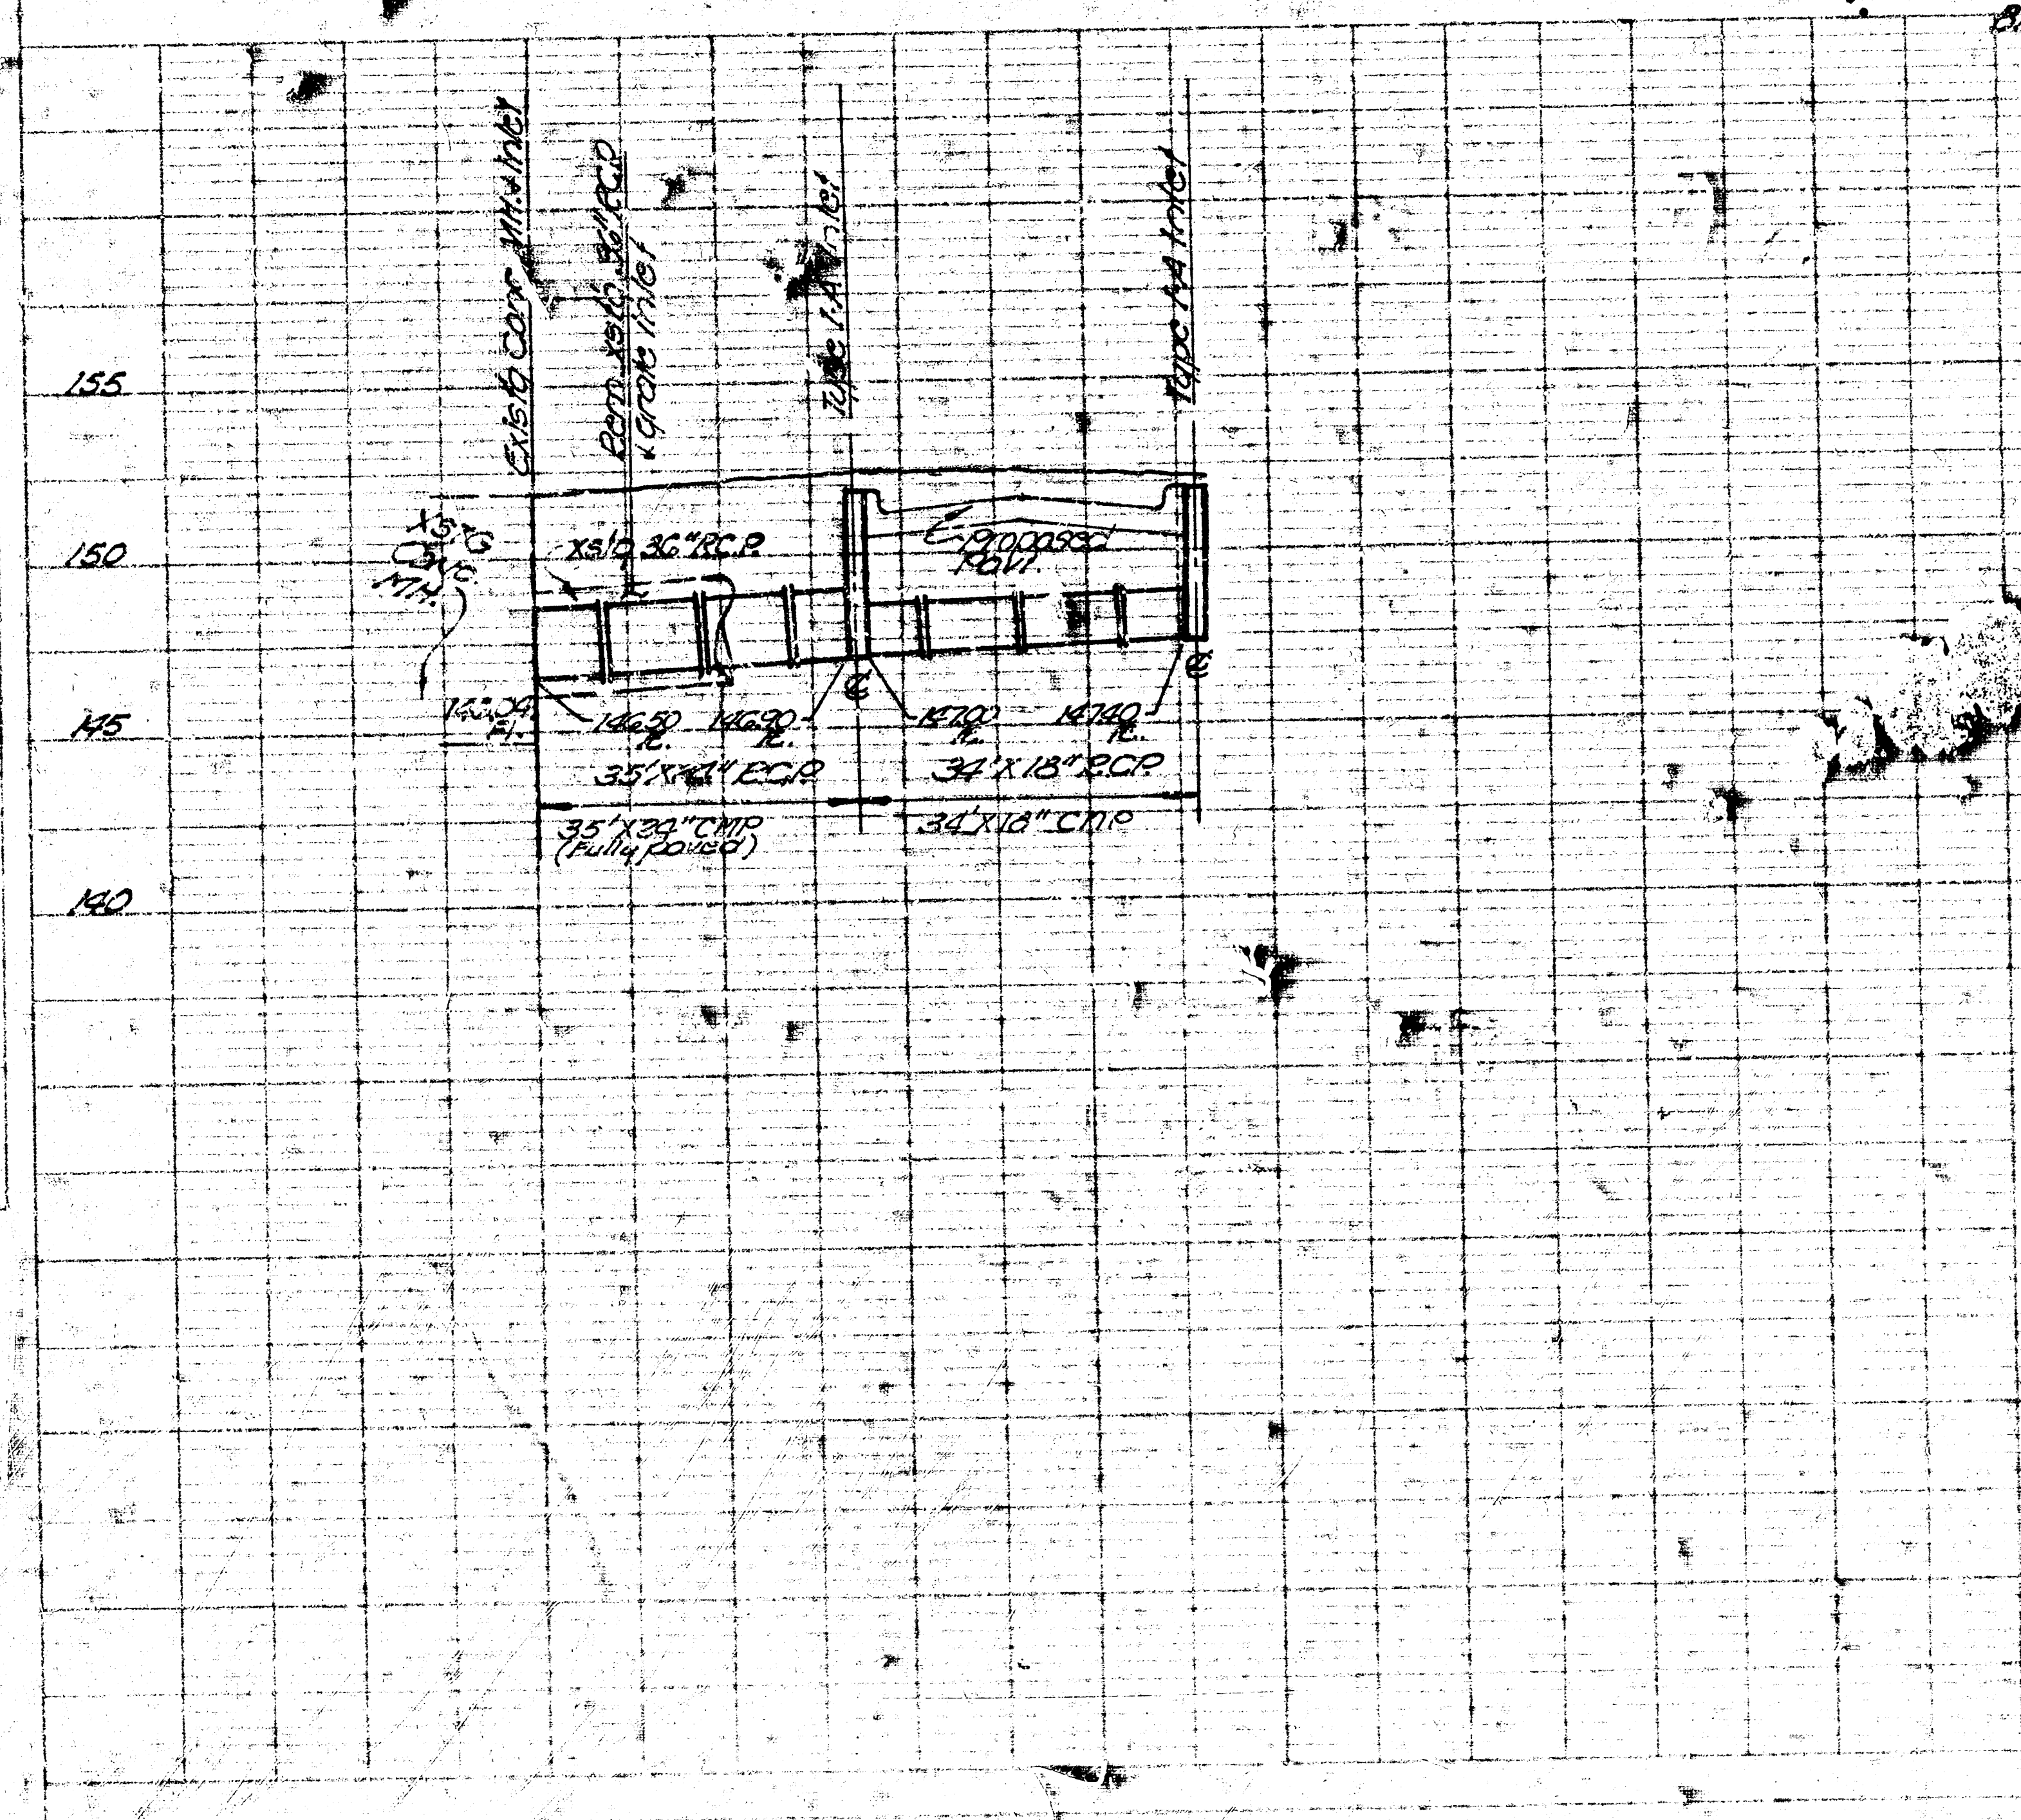


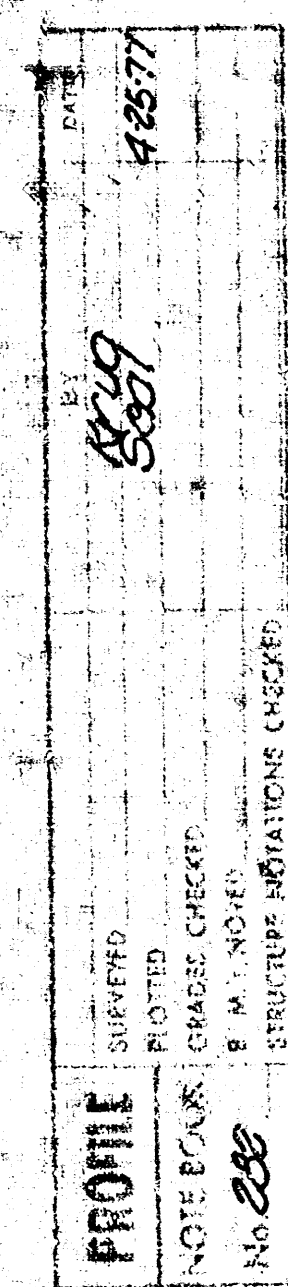

Plan Scale: 1" = 20'
Profile Scale: 1" = 20' Horiz.
1" = 5' Vert.

**INCIDENTAL DRAINAGE FOR STREETS
IN SUNSET MANOR WEST 3RD ADD'N**

CITY OF WICHITA, KANSAS

R. W. LINN CITY ENGINEER
PROJECT NUMBER: DAKD576073
DATE: March 1979