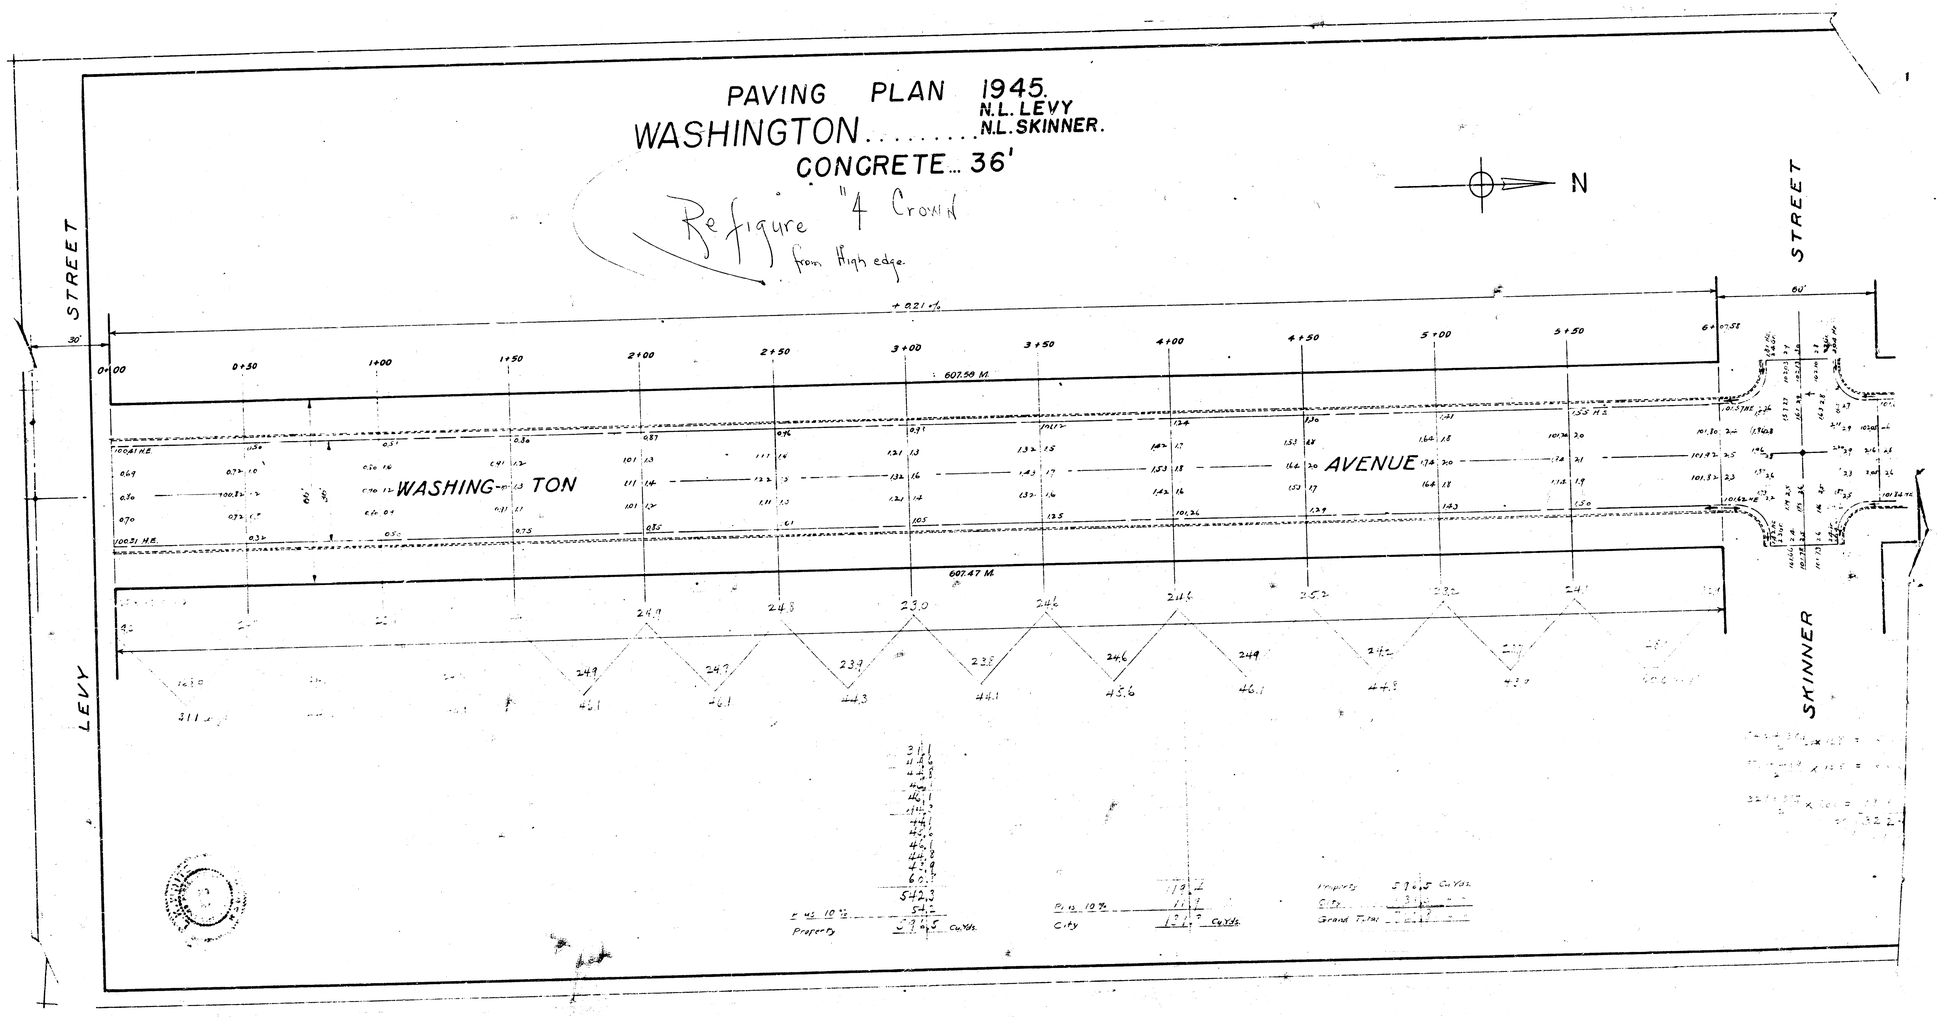
PAVING PLAN 1945.
WASHINGTON..... N.L. LEVY
N.L. SKINNER.
CONCRETE... 36'
Refigure "4 Crown
from High edge.
N
STREET
STREET
LEVY
SKINNER
WASHING-TON
AVENUE
30'
60'
0+00
0+50
1+00
1+50
2+00
2+50
3+00
3+50
4+00
4+50
5+00
5+50
6+07.58
607.50 M.
607.47 M.
+ 0.21 %
Property
City
Grand Total