


WATERMAN EL. Battin to EL. Pinecrest. 20' Asph. Conc. Curb & Gutter. 5" Conc. Base 2" Asph. Conc. Surface.

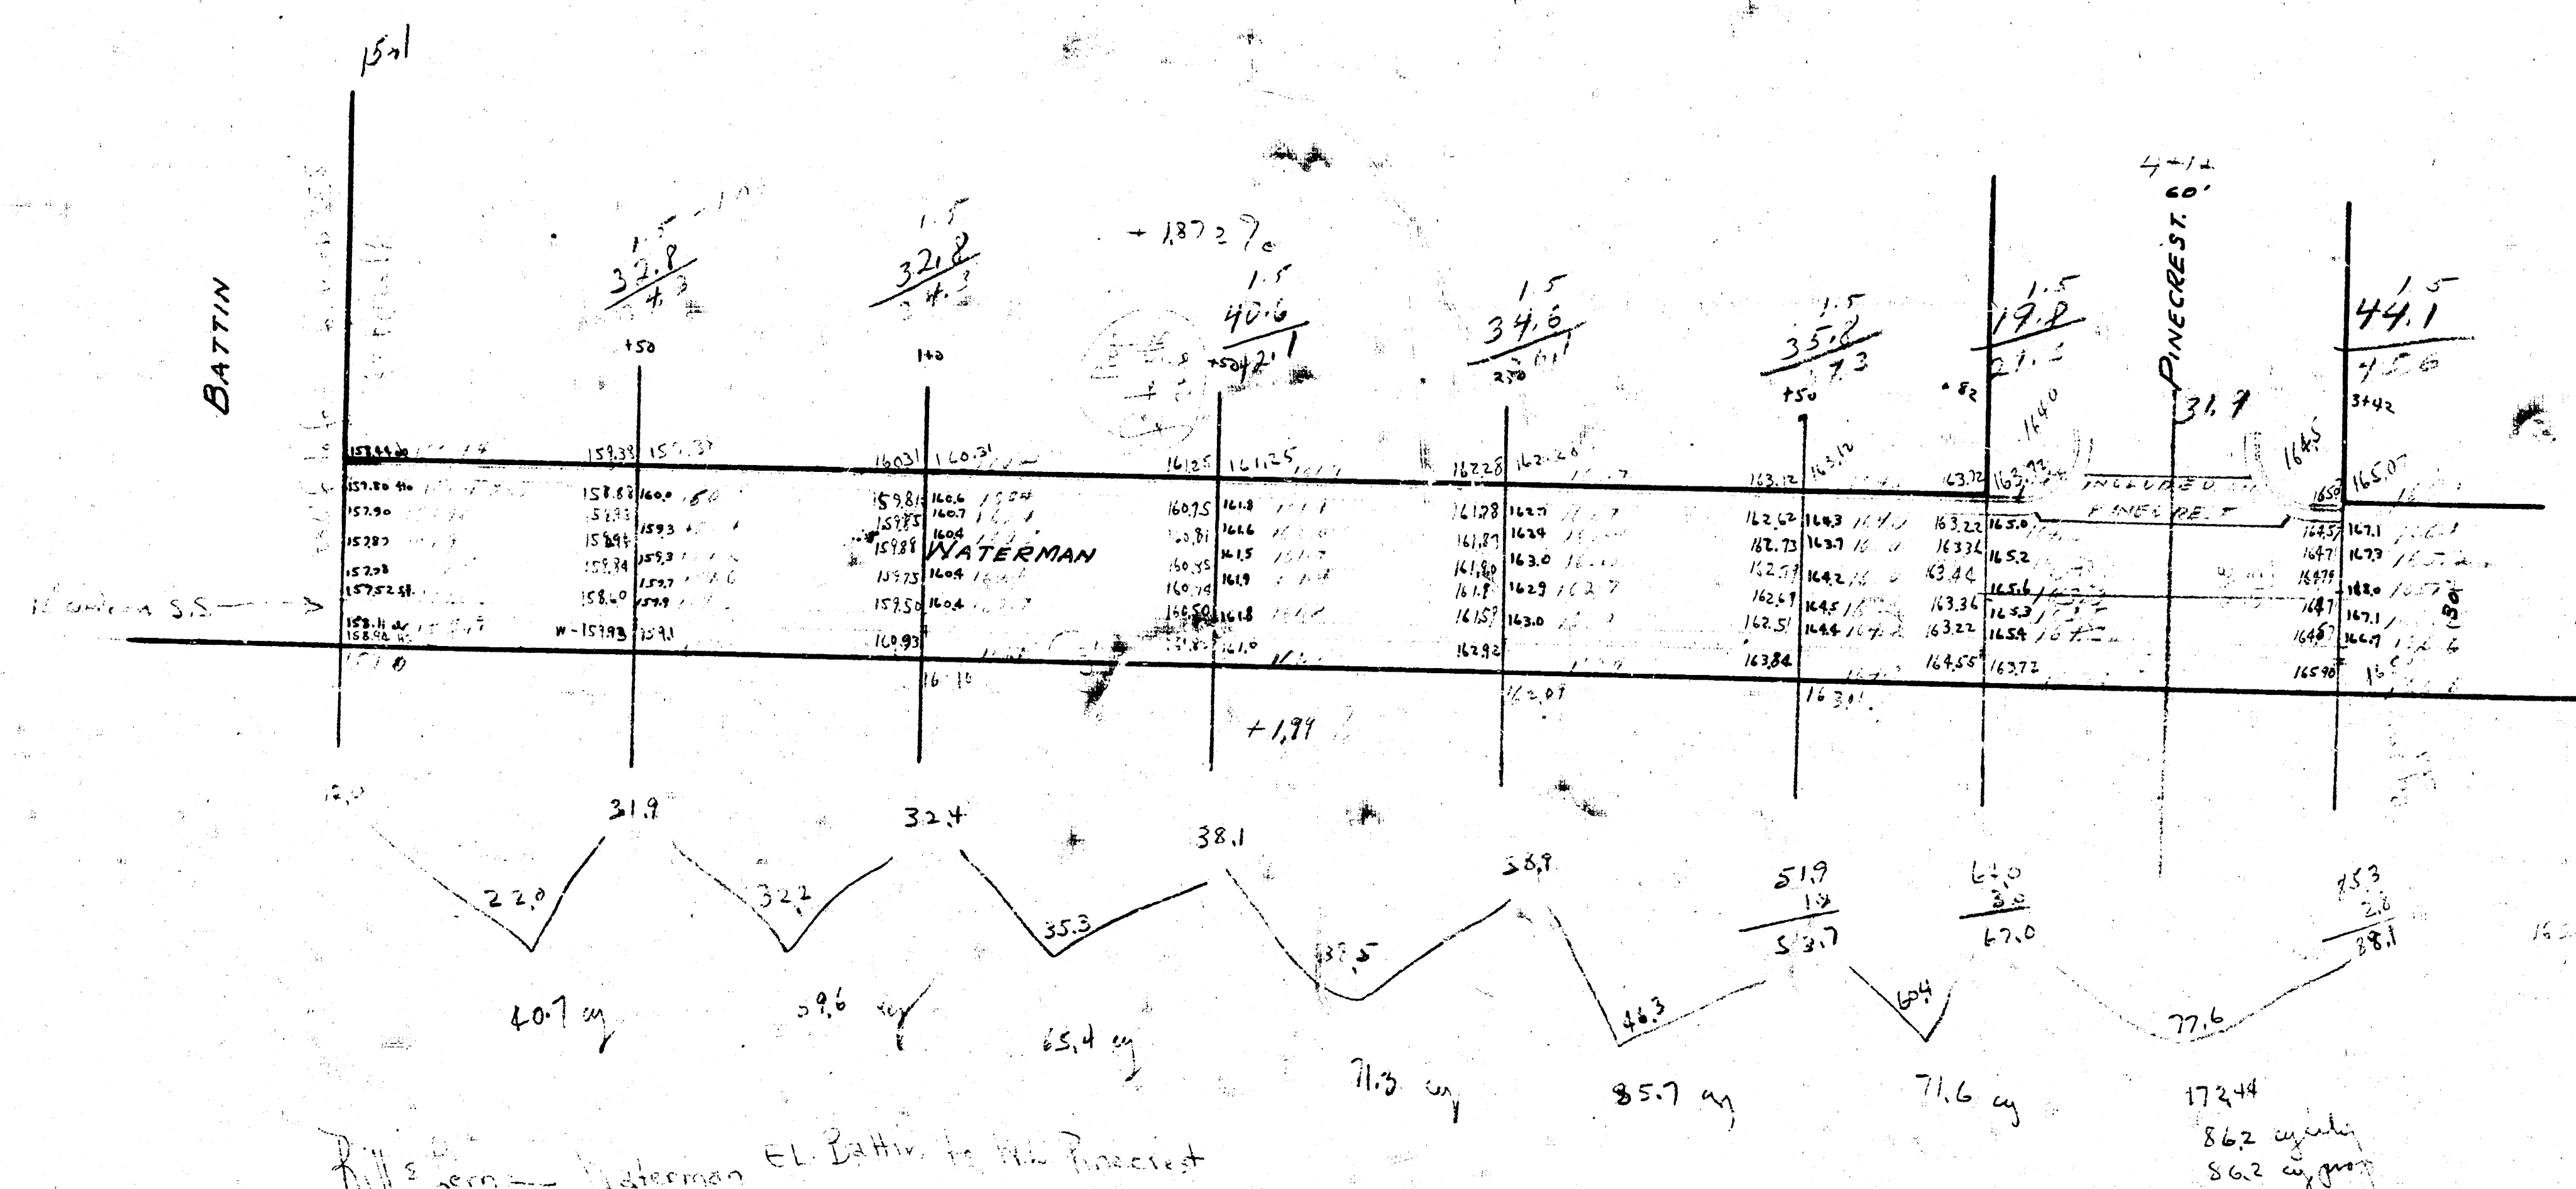

Bill's term - Waterman EL. Battin to EL. Pinecrest
 Base at right - 21.7' (approx. 10' to 15')

Waterman EL. Pinecrest to EL. Battin
 Part of the 150' + 10' straight from
 as shown in plan. (This part also 20' to 15')

Prop 480.5
 45.1
 528.6

Calc 76.2
 76.2

