


55

3M 170.18 R.R. spike in power pole N.S. Kellogg, 50' E. of E.L. Lexington

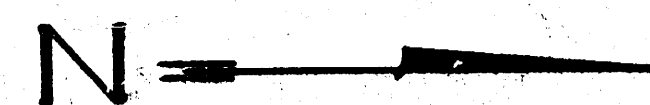

NOTE: Measurements on E.S. of Waverly, 90' N. of E.L.

Property

98.7
97.8
102.4
92.1
94.3
99.8
113.9
125.9
122.2
1044.5

Total

Property - 1044.5

2098.3



+10% 2307.1 sqds.

City - 0


Scale 1" = 20' 0"

1718.833 ± 2.459416
2.459416 x 457 = 111.99436
2.459416 x 40 = 98.37664

1000	2' 00' 00"
200	2' 00' 00"
300	2' 00' 00"
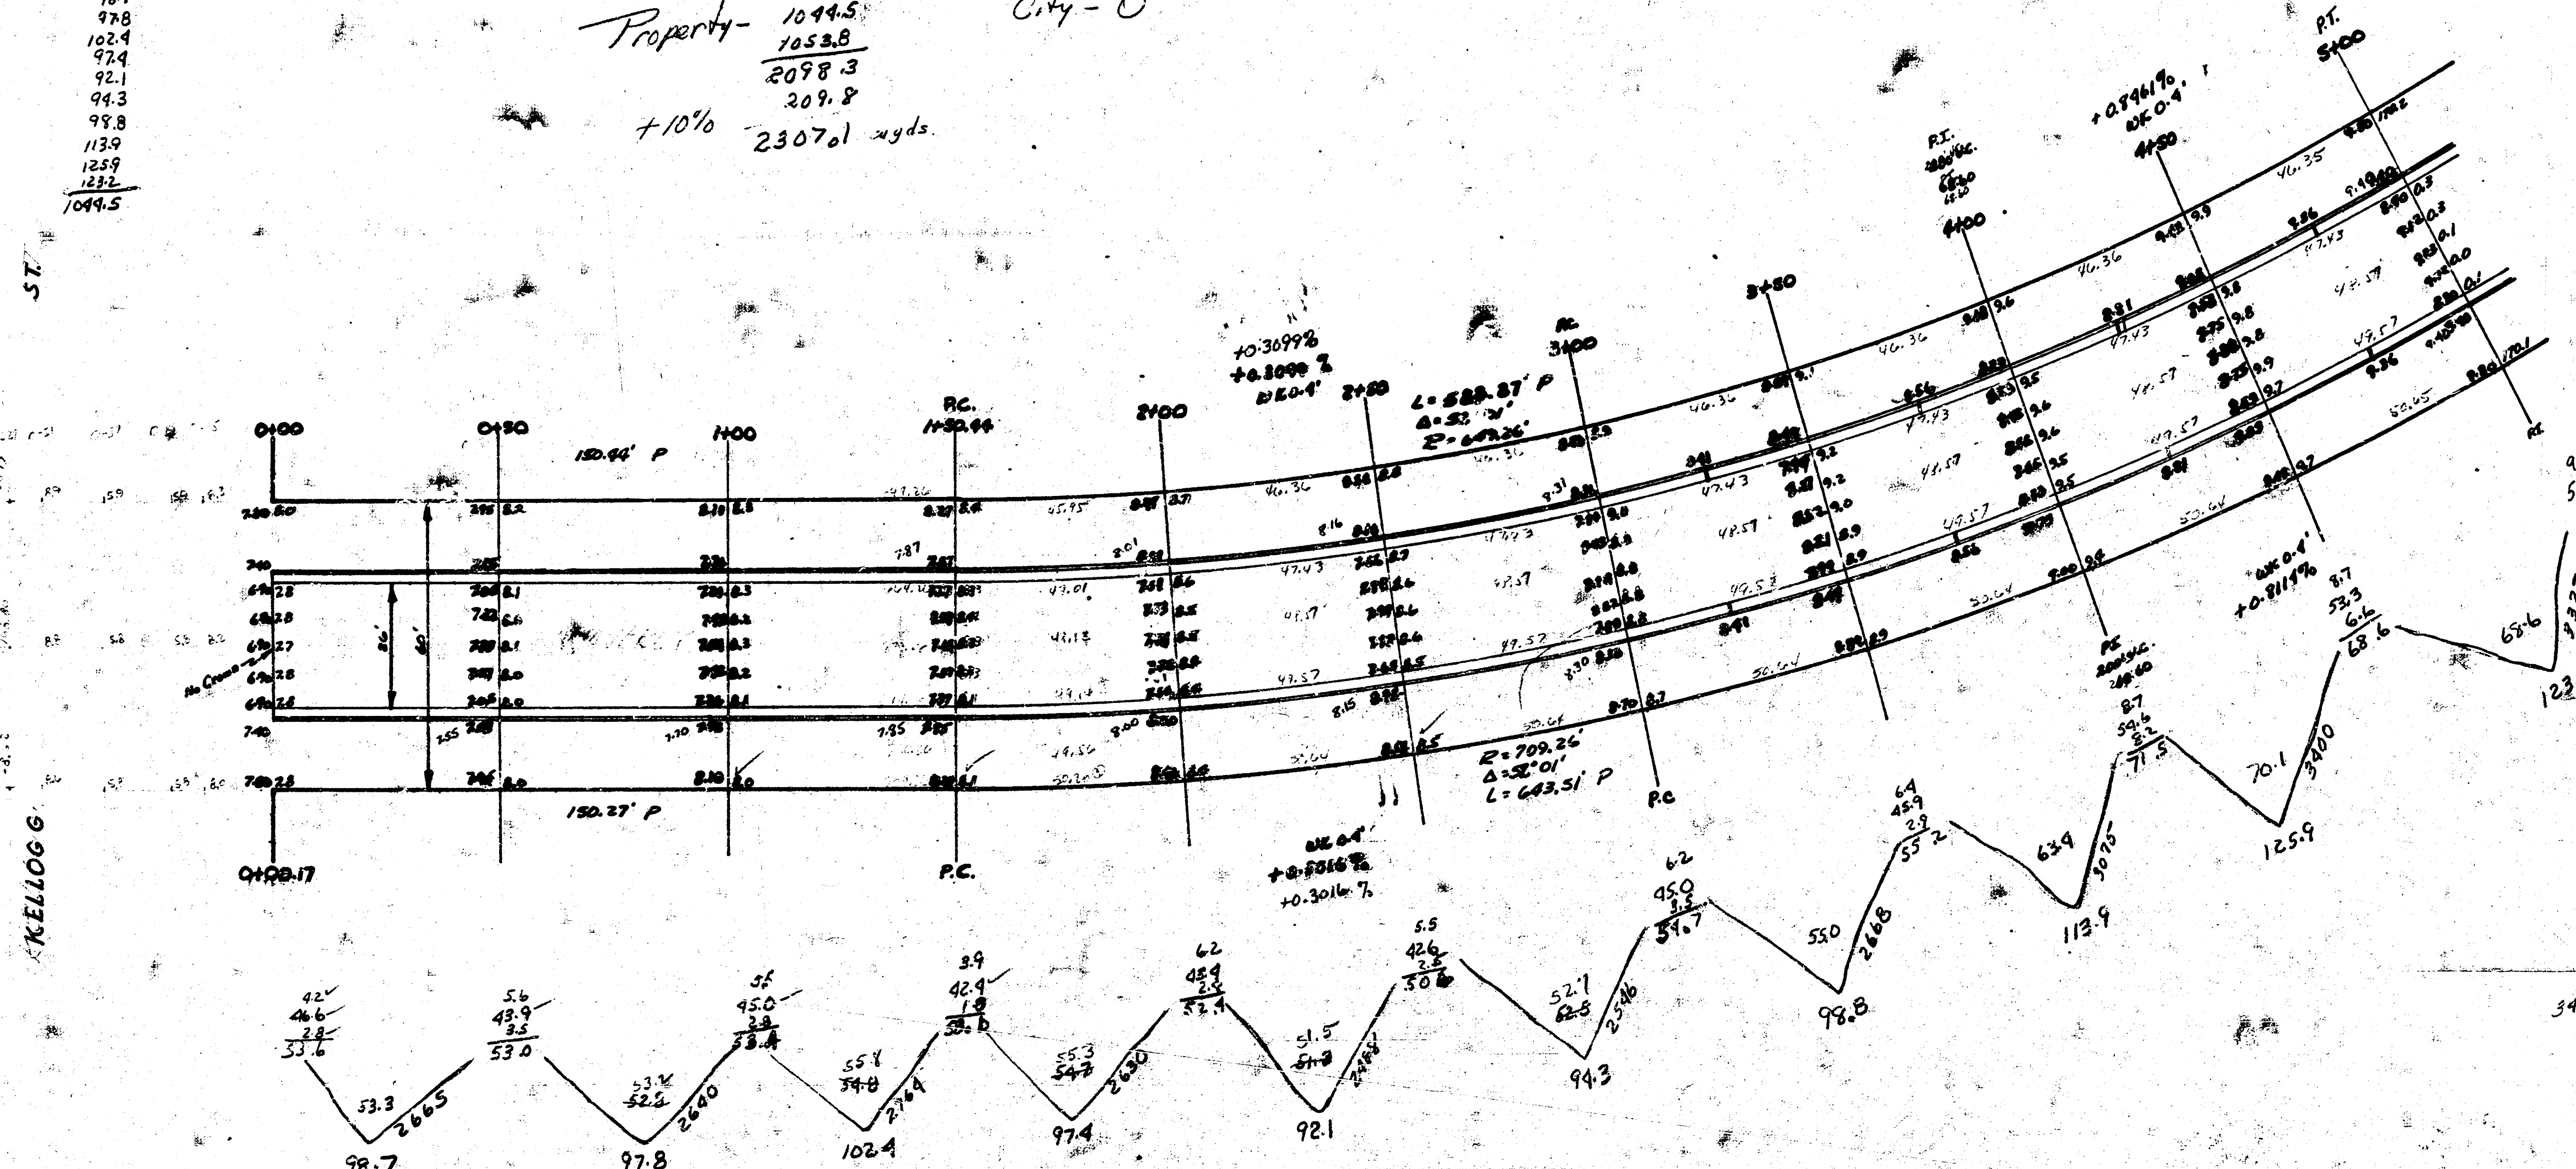


WAVERLY DRIVE
S.L. RIDGECREST-N.L. KELLOGG DR
26-2-30 A.C.
CITY OF WICHITA, KANS.
L.K. WHITE CITY ENGINEER
JUNE 1950 PROJ. CIO-105

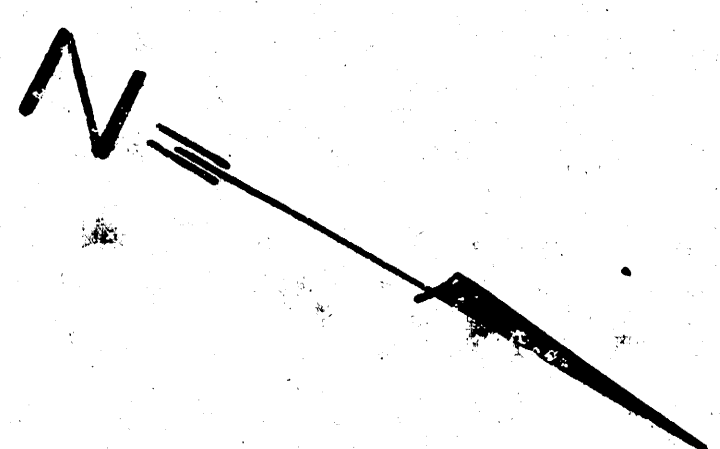

NOTE: Measurements on ES. of Waverly, 9° W. of E.R.L.

Property

128.6
135.8
145.7
151.1
147.5
108.8
133.5
111.0
1053.8

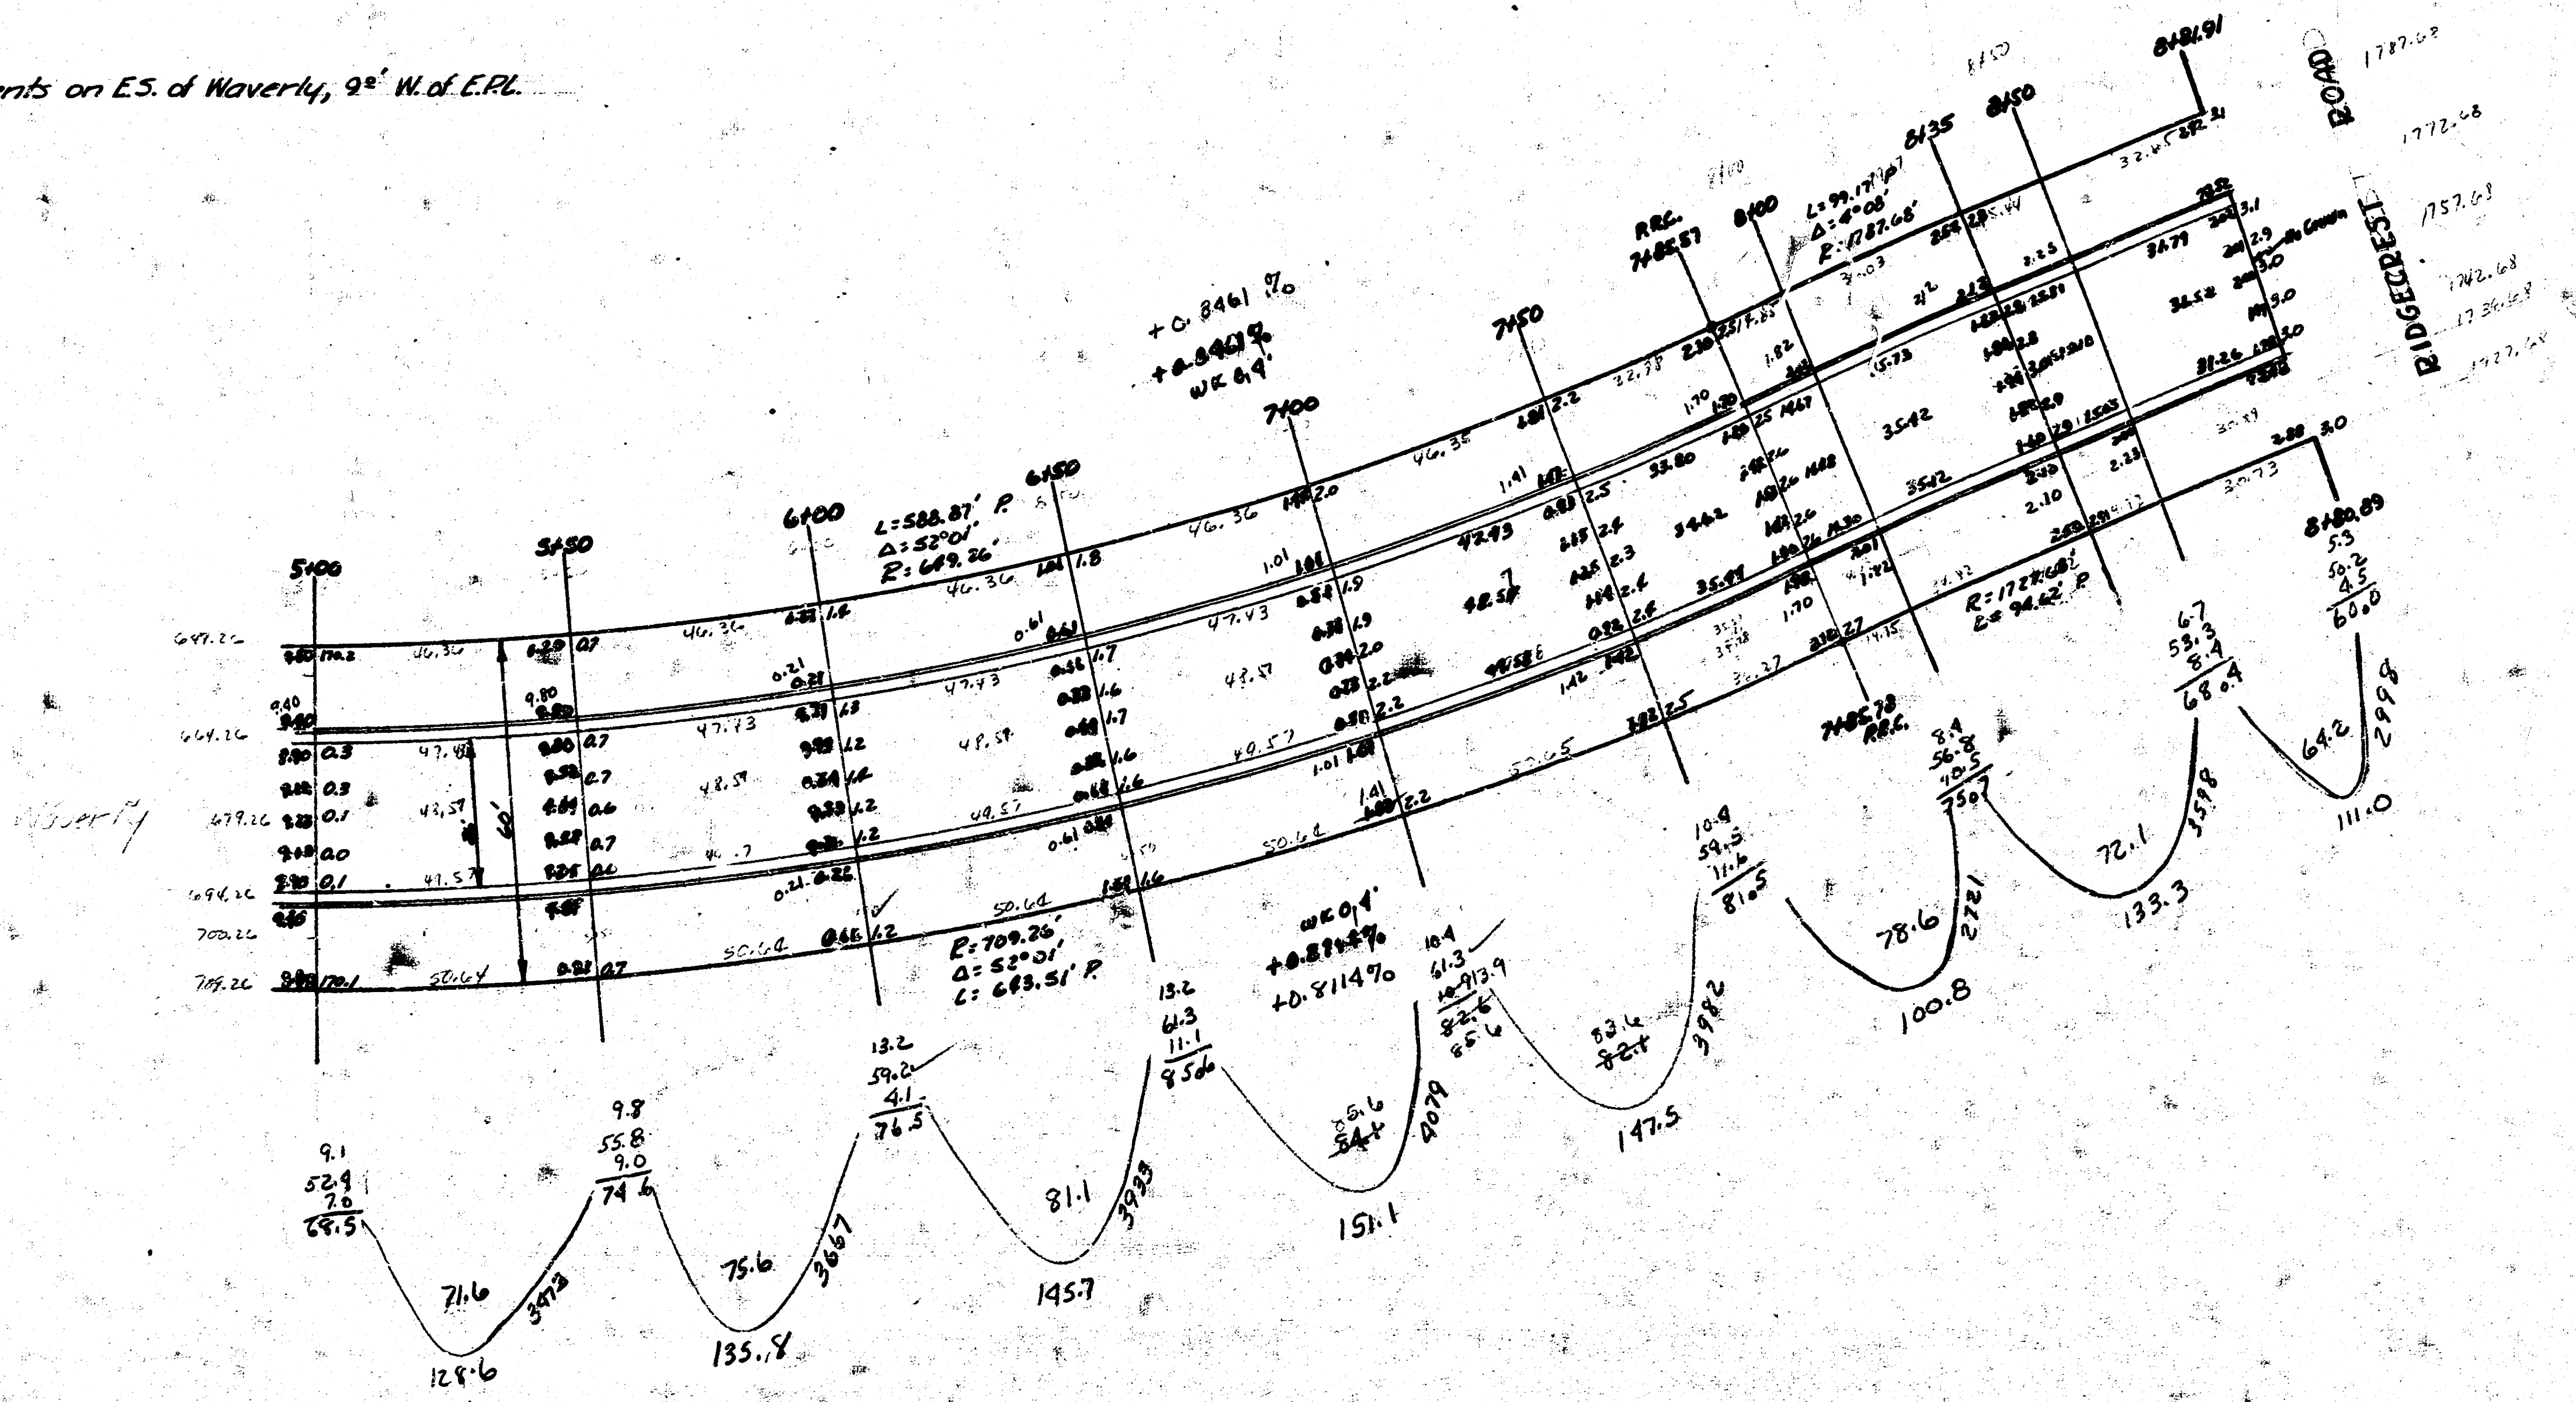

2
2

4 0 5 30