
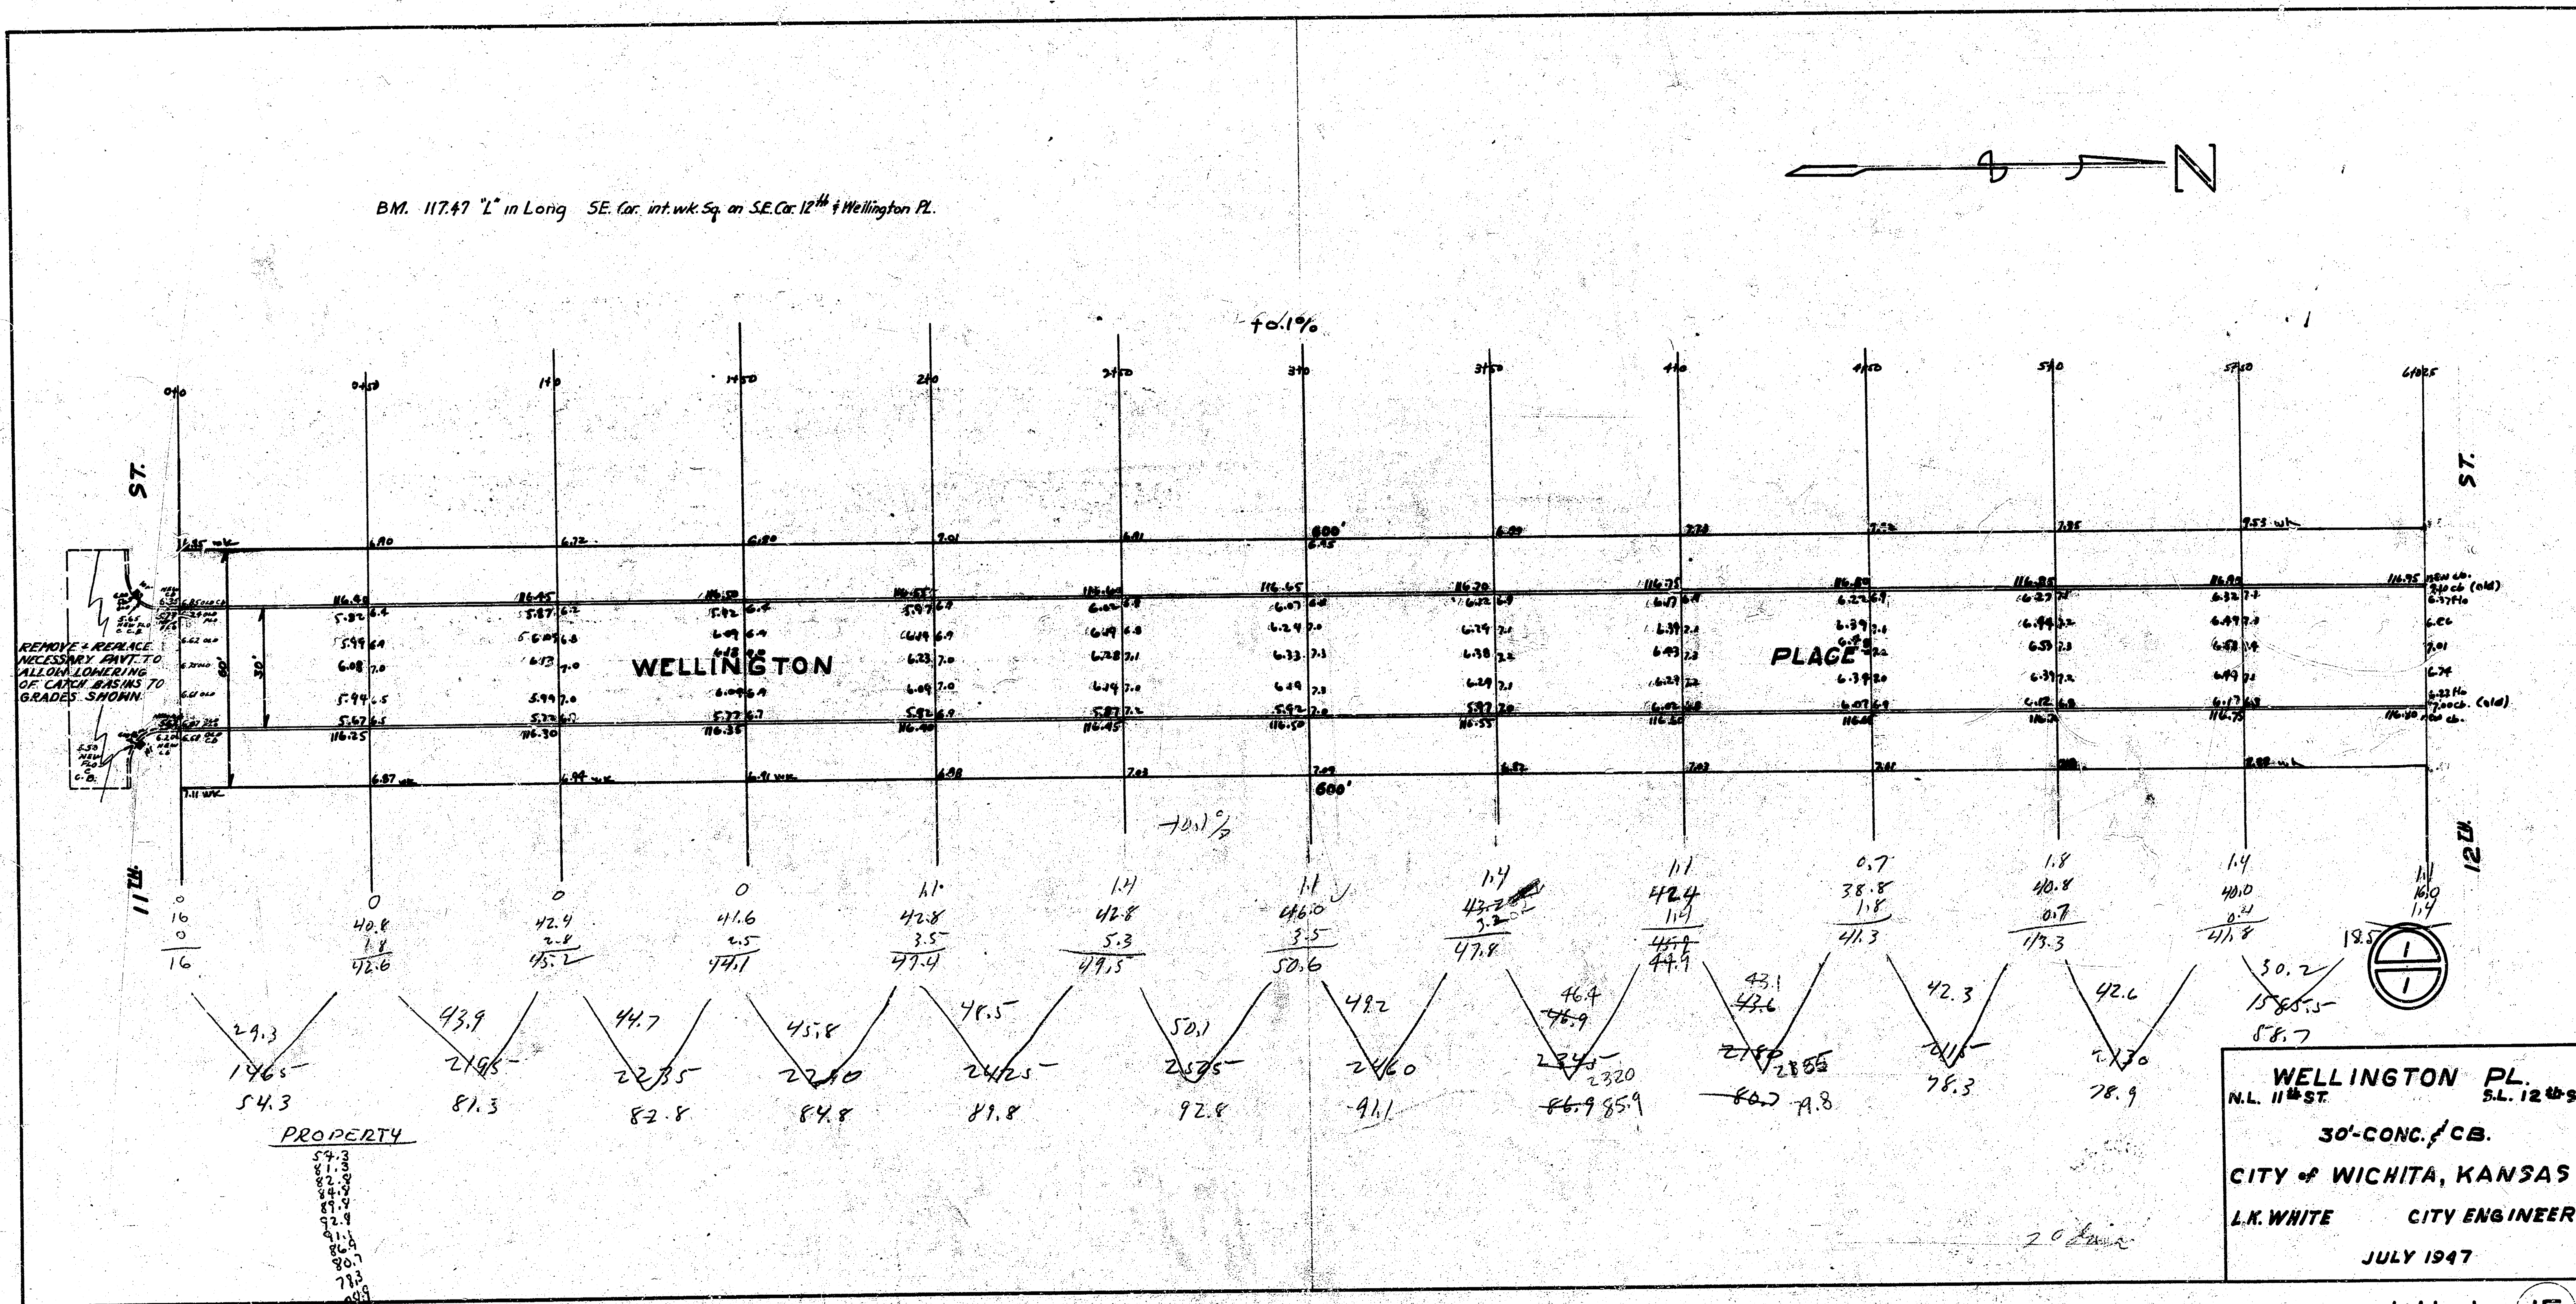


B.M. 117.47 "L" in Long SE. cor. int. wk. Sq. on SE. Cor. 12<sup>th</sup> & Wellington Pl.

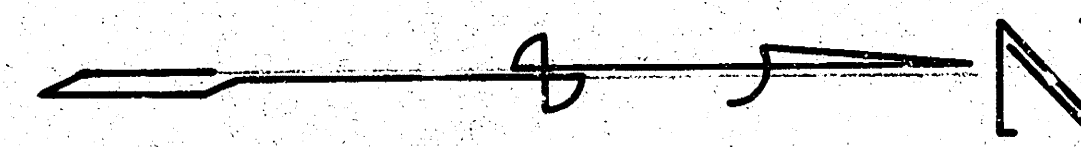

PROPERTY


96.4  
96.4  
105.6  
total

4114 15