


Sta On S R

B.M. 93667 Standard - N.E. Cox 27th St. & Meridian Ave.

Note

Remove Existing 30" R.C.P.
Install 2'-15" R.C.P. 50' Long.
Const. Dirt And Sand Hookup.

Survey Done By: B.E. Smith
Plan: Revision
Pac.
Checked

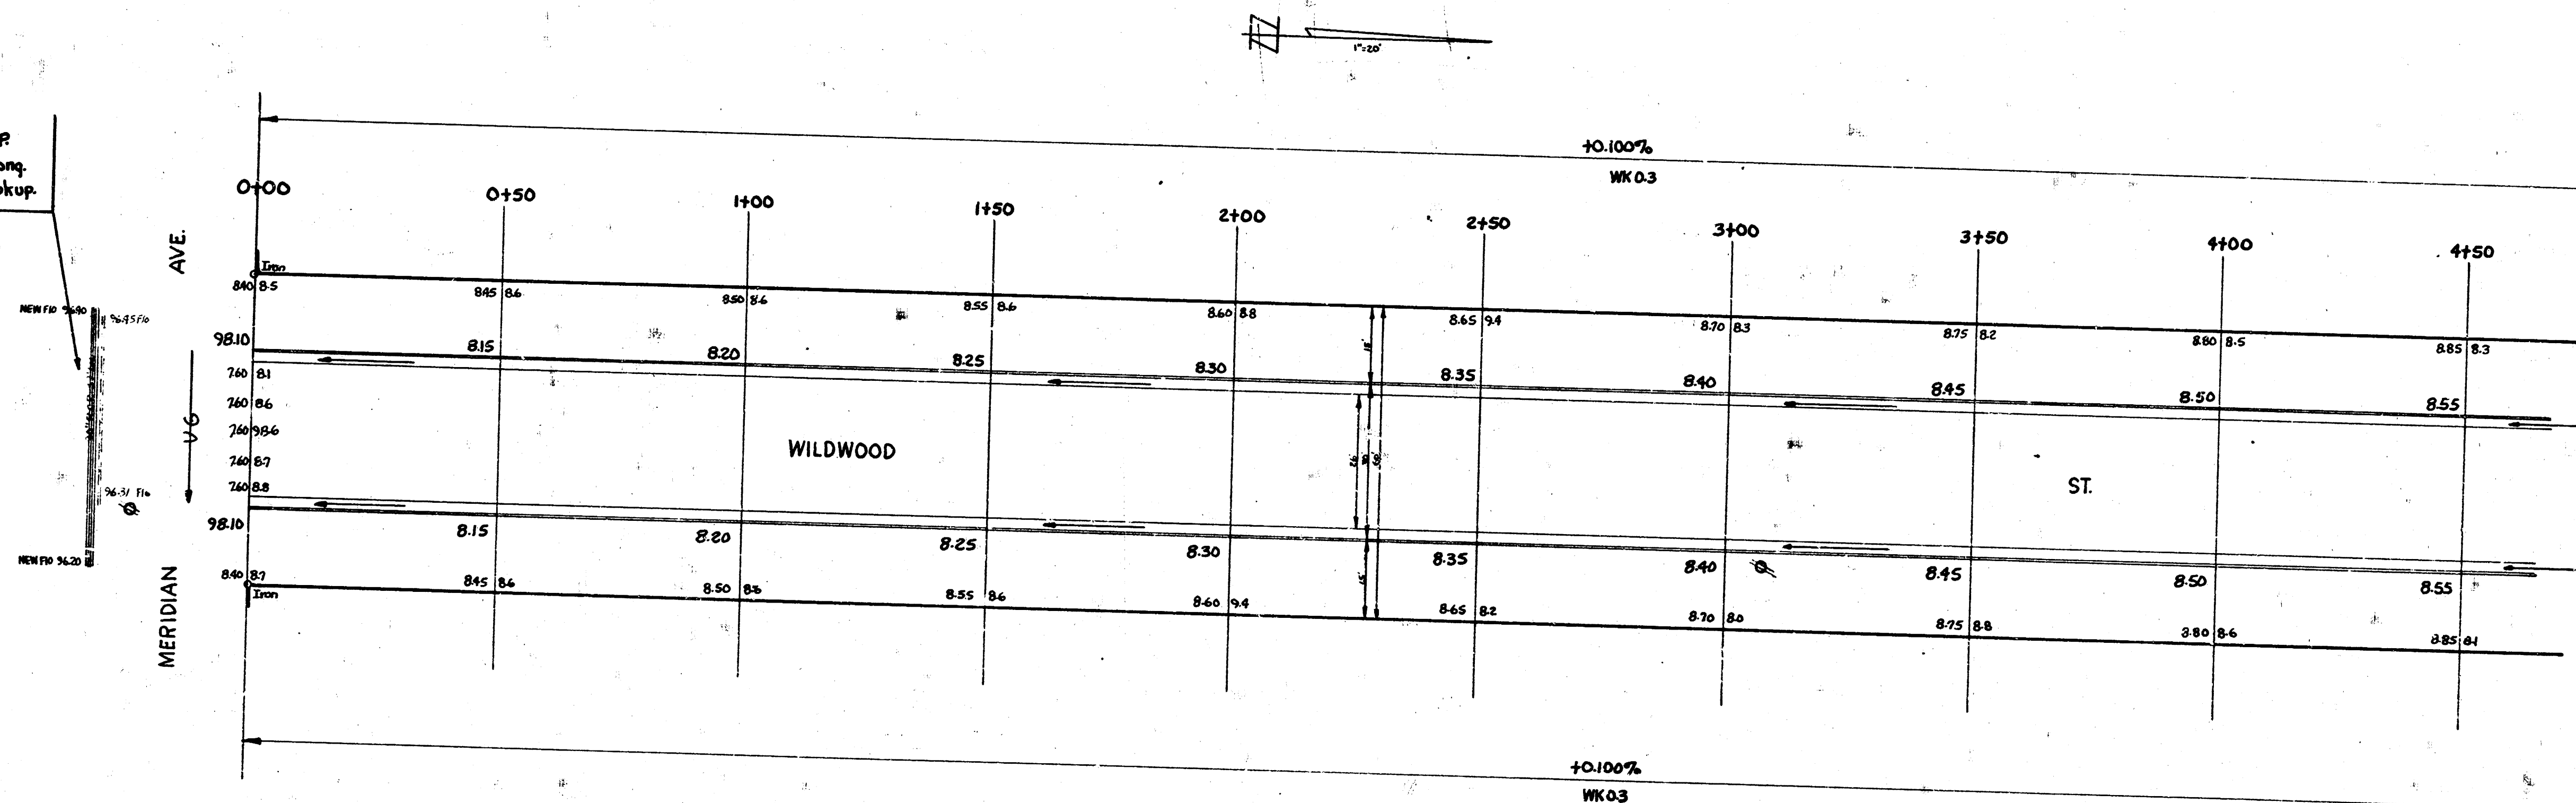


Wildwood St.

El. Meridian To W.L. Everett
26'-2-30 AC.

City Of Wichita, Kansas
B.E. Smith City Engineer
Aug. 1956 Proj. No. C14-300



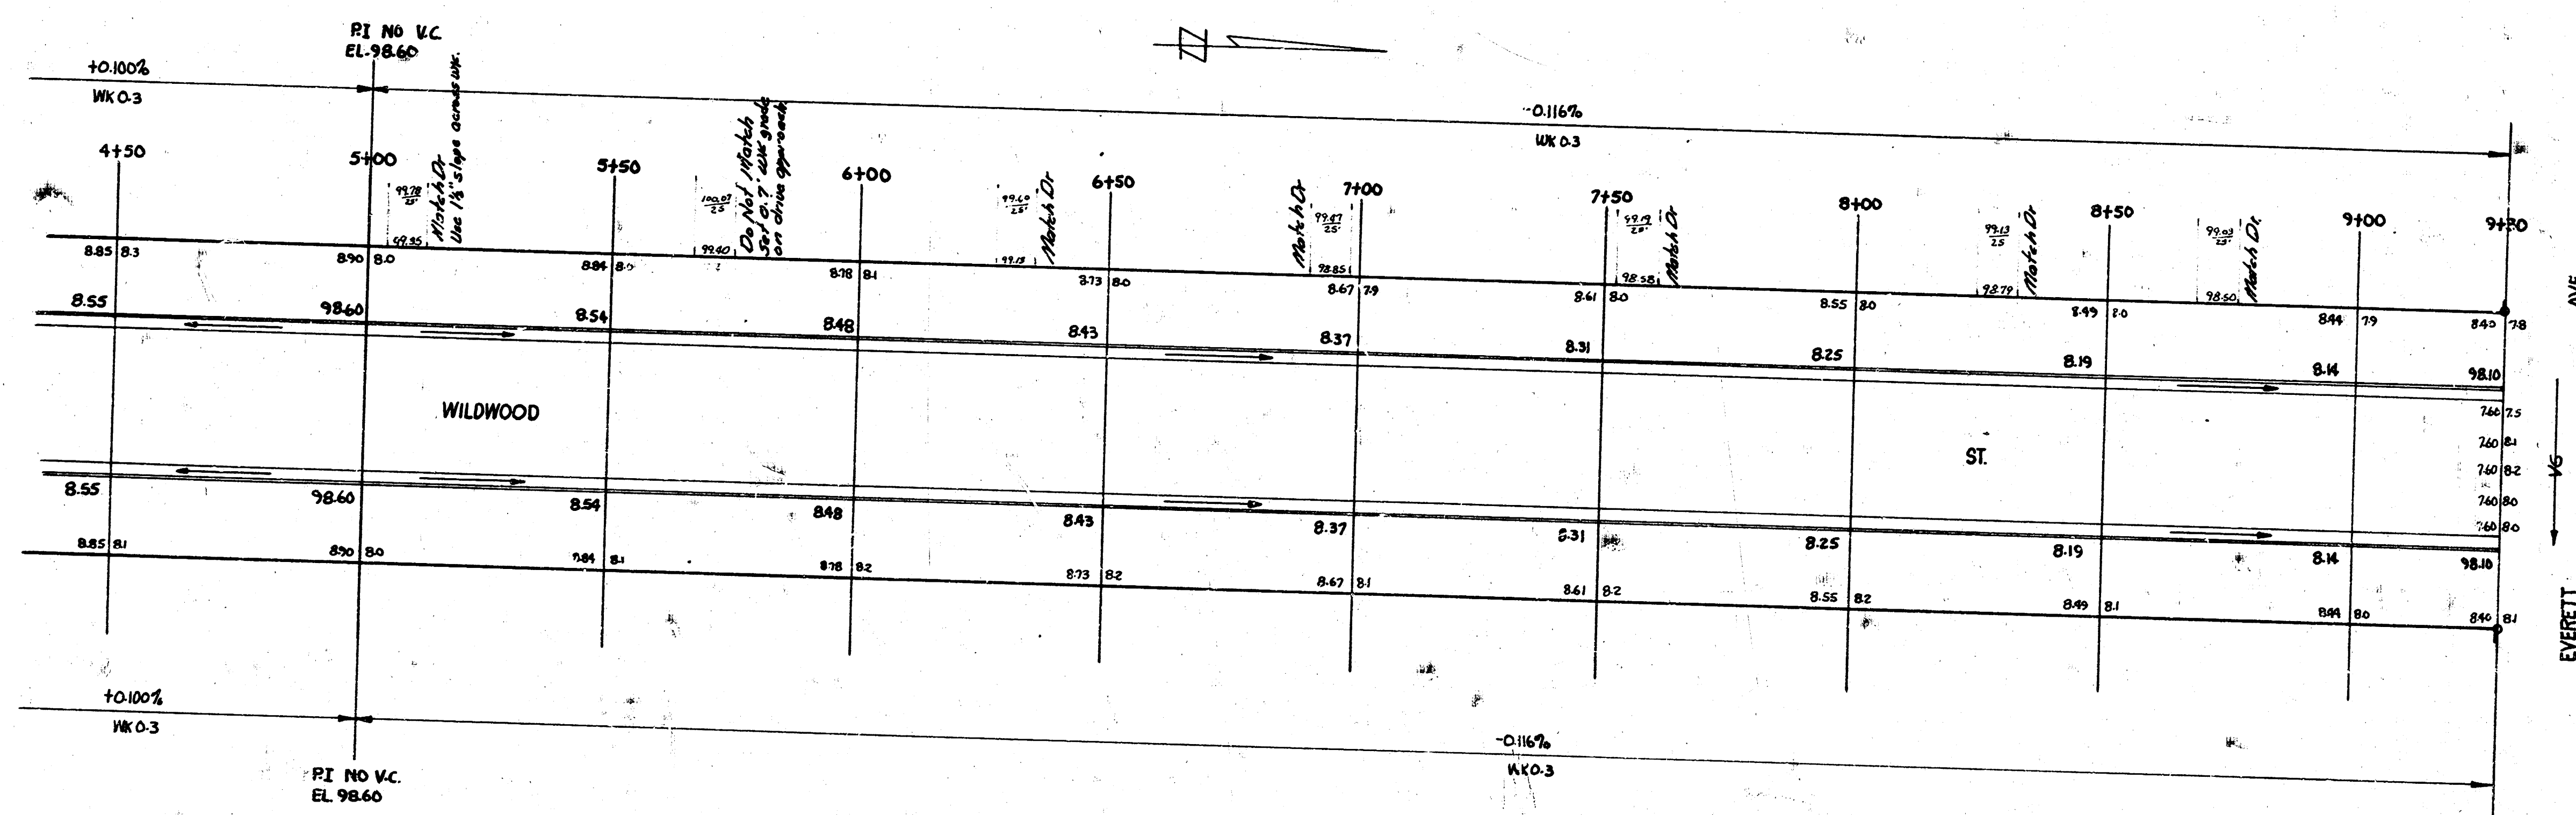

Wildwood St.
Prop. No. C14-300