



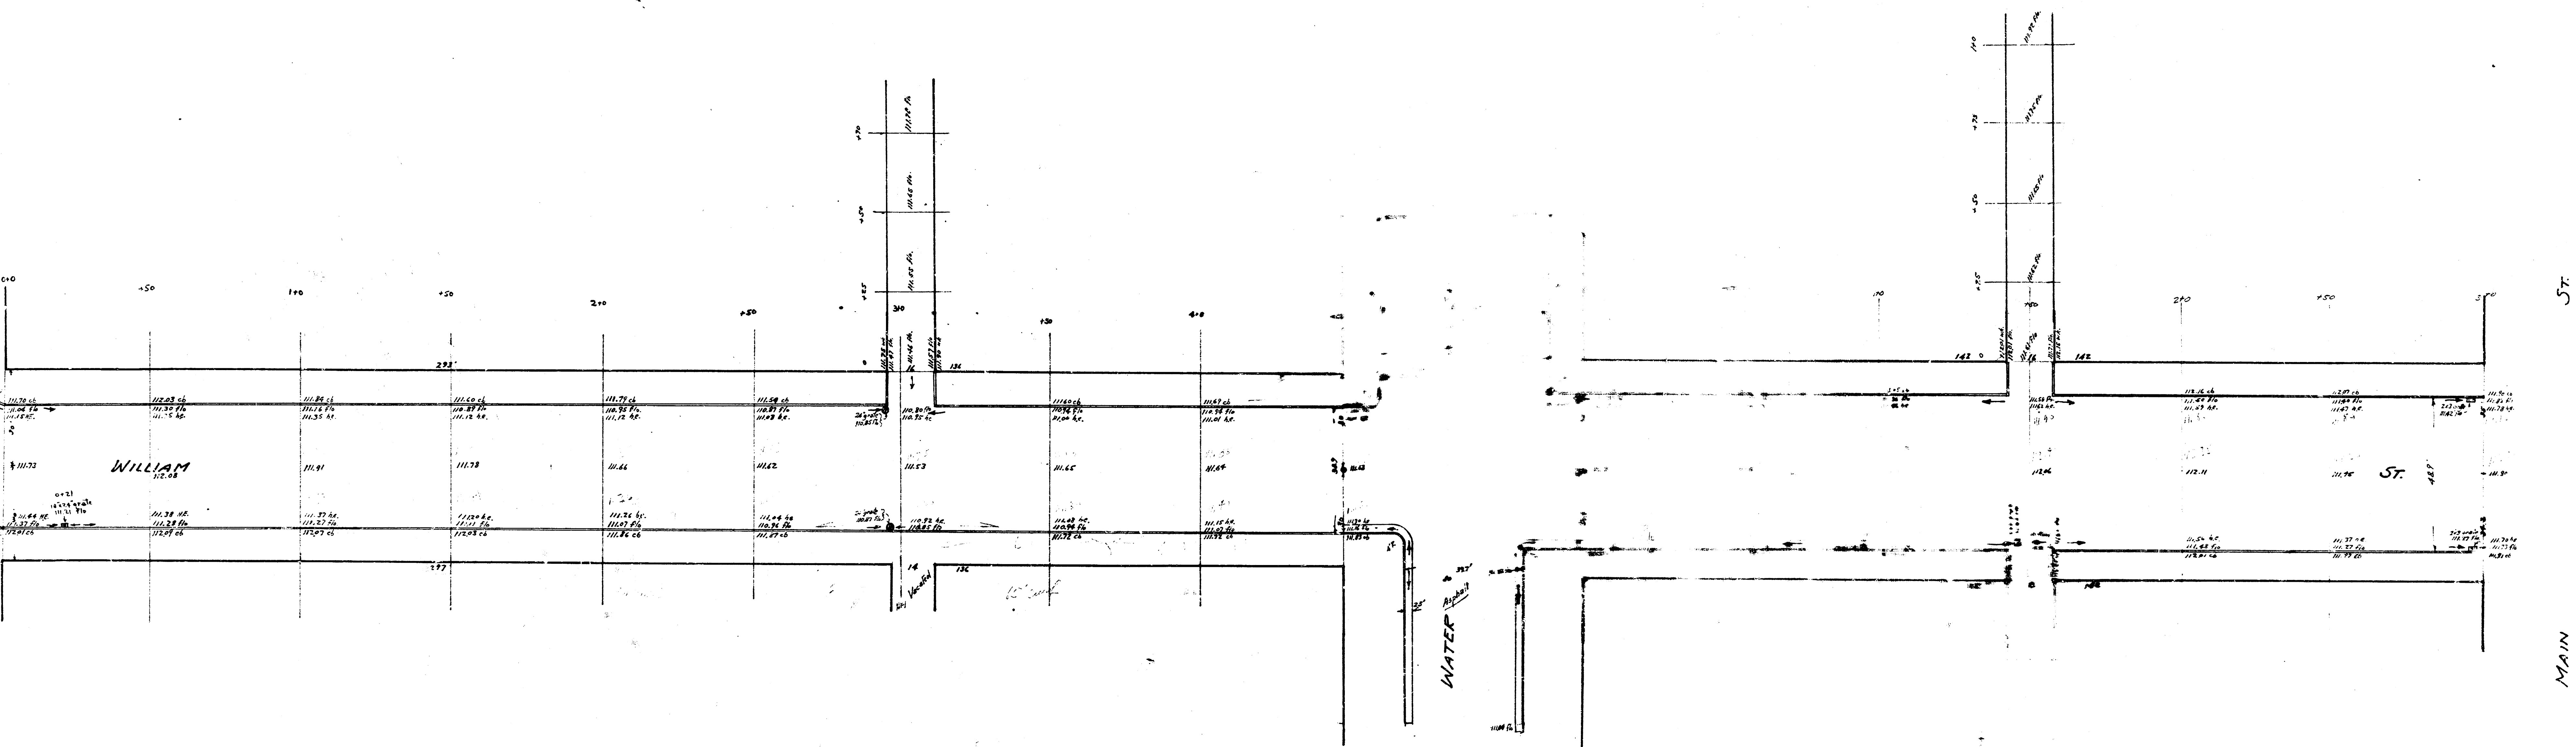

B.M. Elev. 111.50 Iron in Thin S.S. William, Center of William
 110.98 Iron in Thin S.S. Main & Center of William
 111.06 Iron in Thin S.S. Main & Center of William
 111.00 Iron in Thin S.S. Broadway & C. of William
 108.20 Iron in Thin S.S. Tappan & C. of William
 108.80 Iron in Thin S.S. Empress & C. of William

57

MAIN

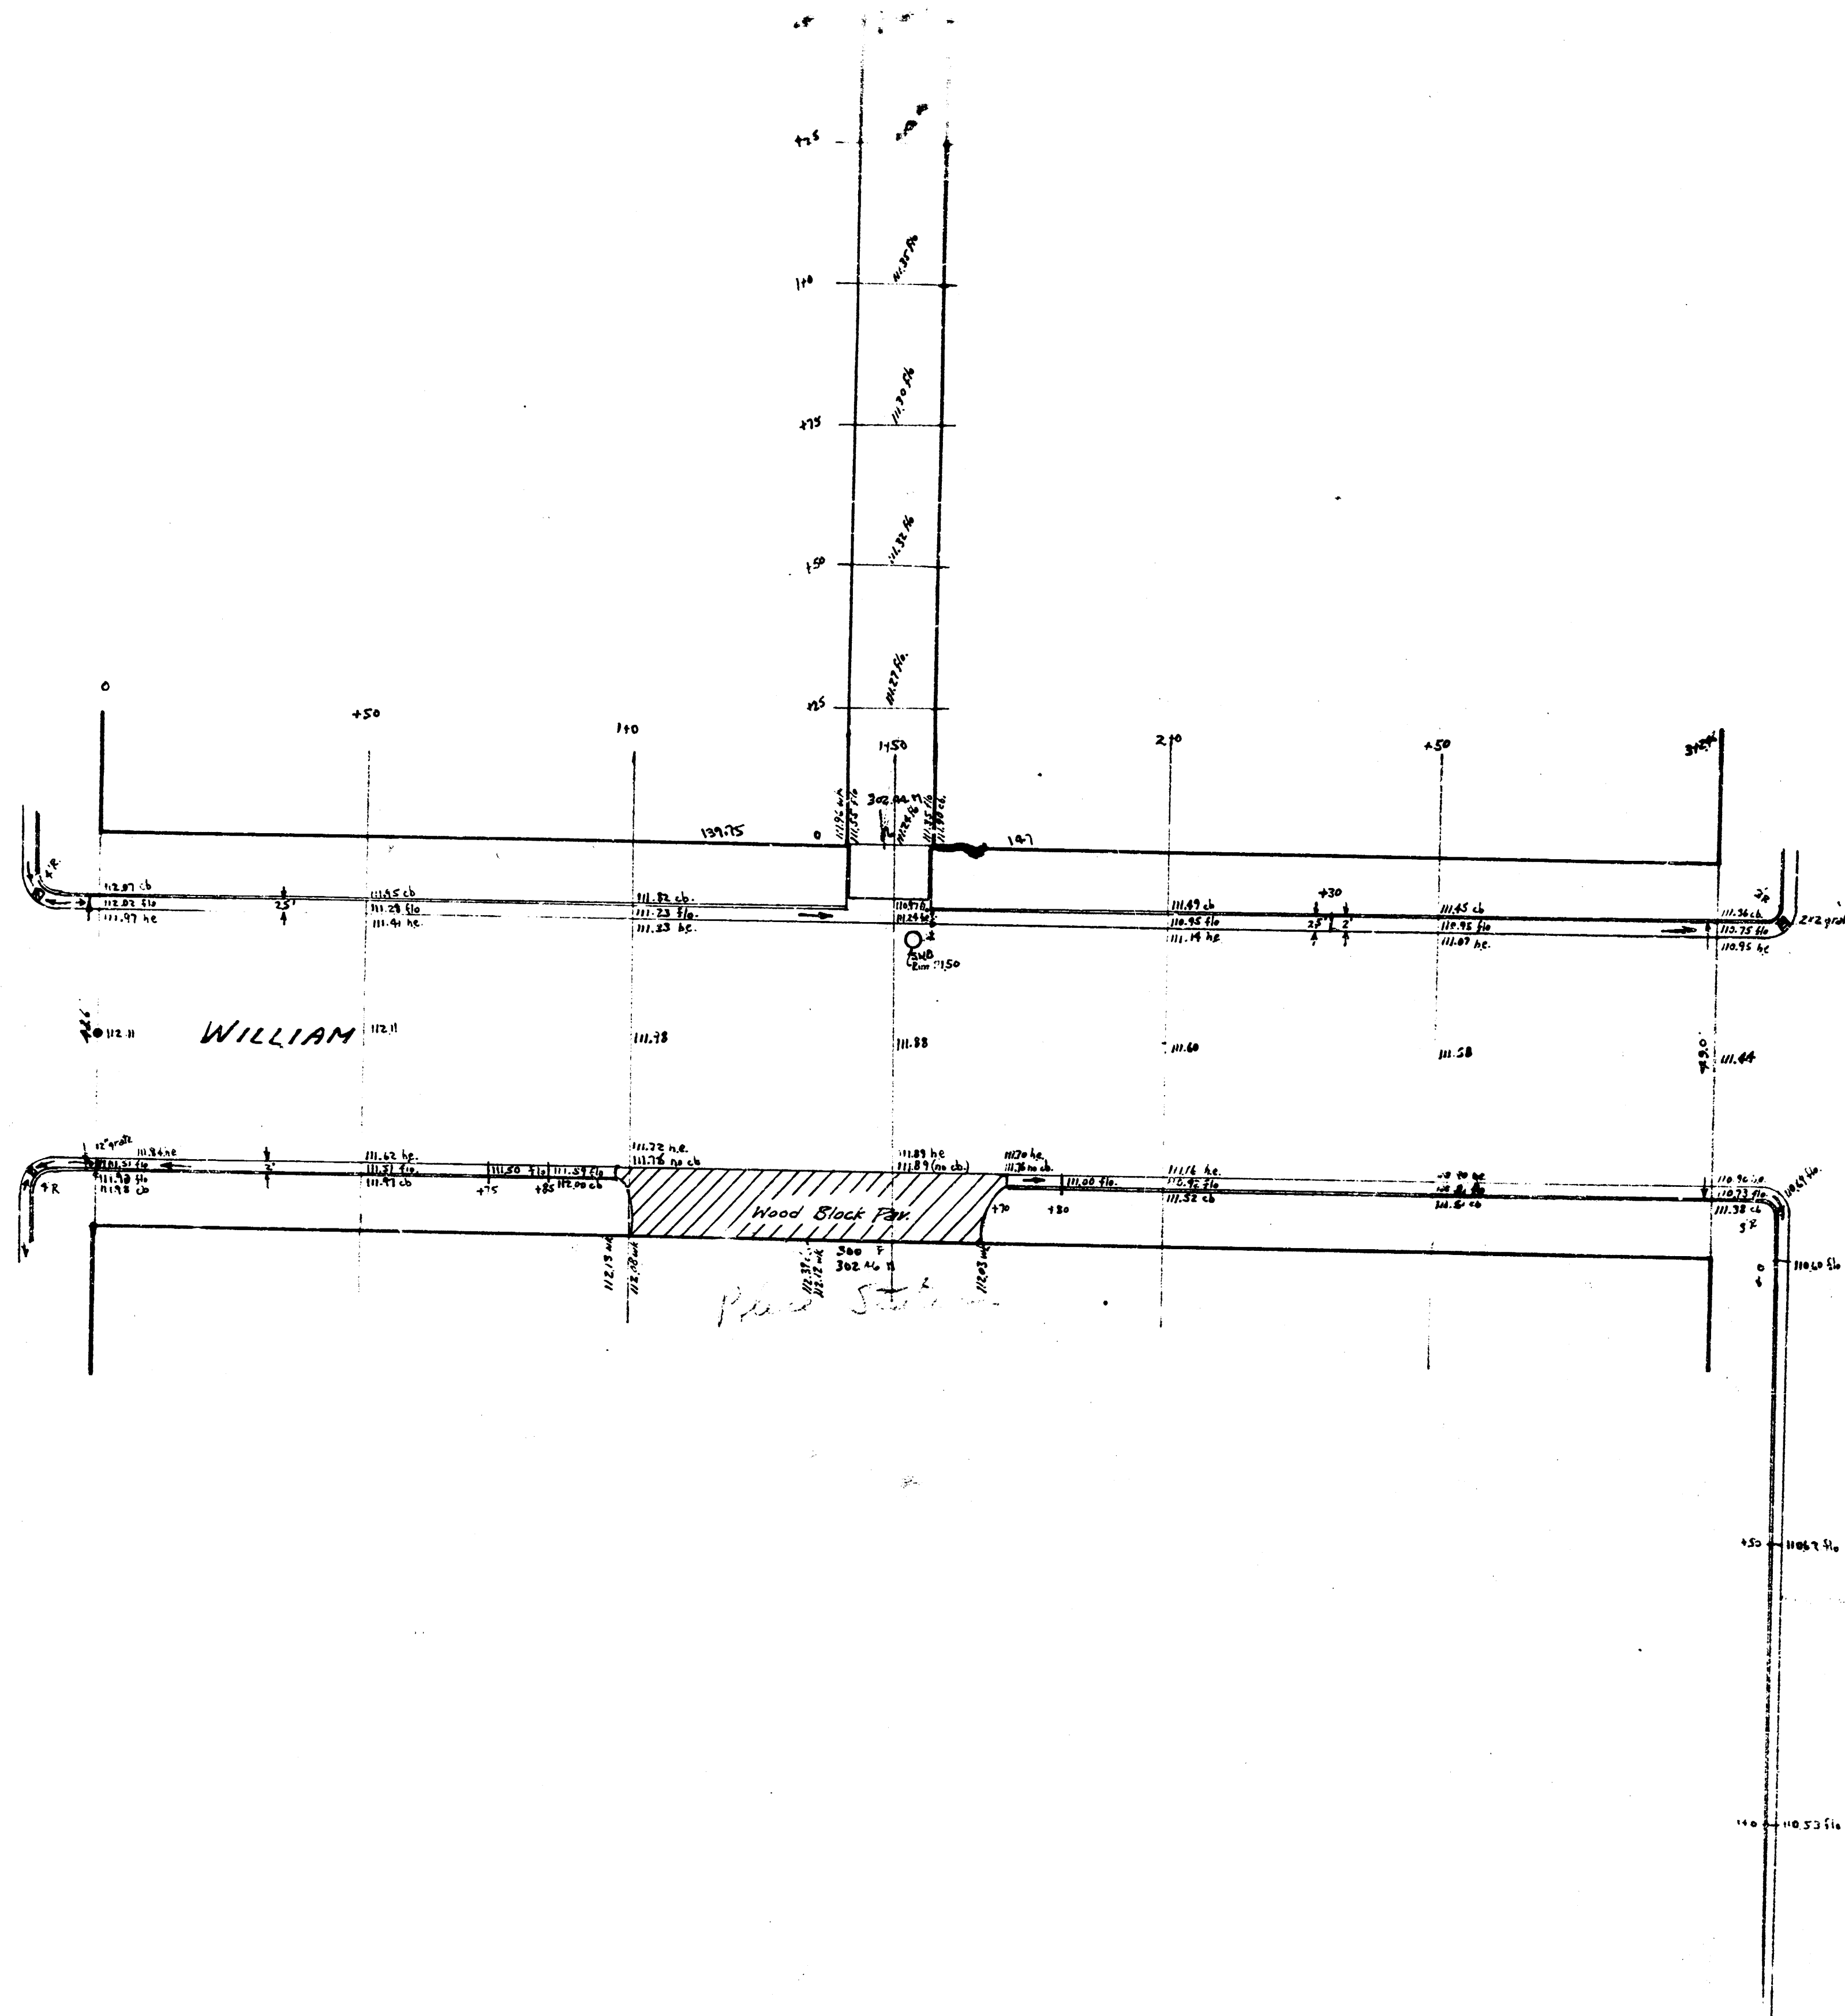

57

MARKET

