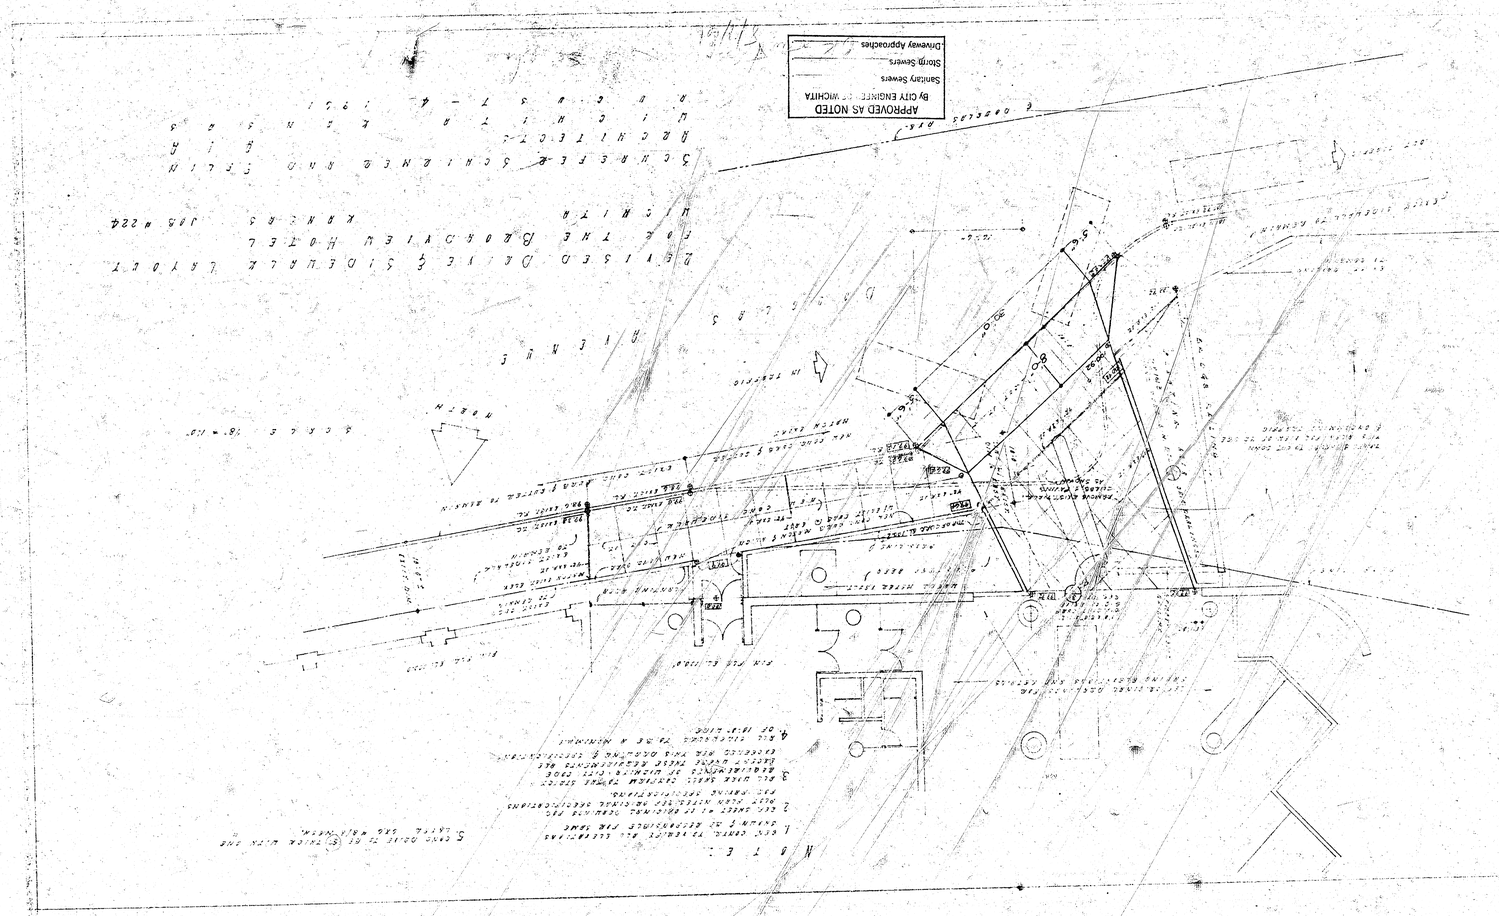
APPROVED AS NOTED
By CITY ENGINEER - WICHITA
Sanitary Sewers
Storm Sewers
Driveway Approaches
NOTE:
SCALE: 1/8" = 1'-0"
NORTH
WICHITA, KANSAS
JOB # 224
ARCHITECTS
WICHITA, KANSAS
