


SW 1/4 SEC. 12 TWP. 27S R.1E

11-41

4800 | 4900 | 5000 | 5100 | 5200 | 5300 | 5400

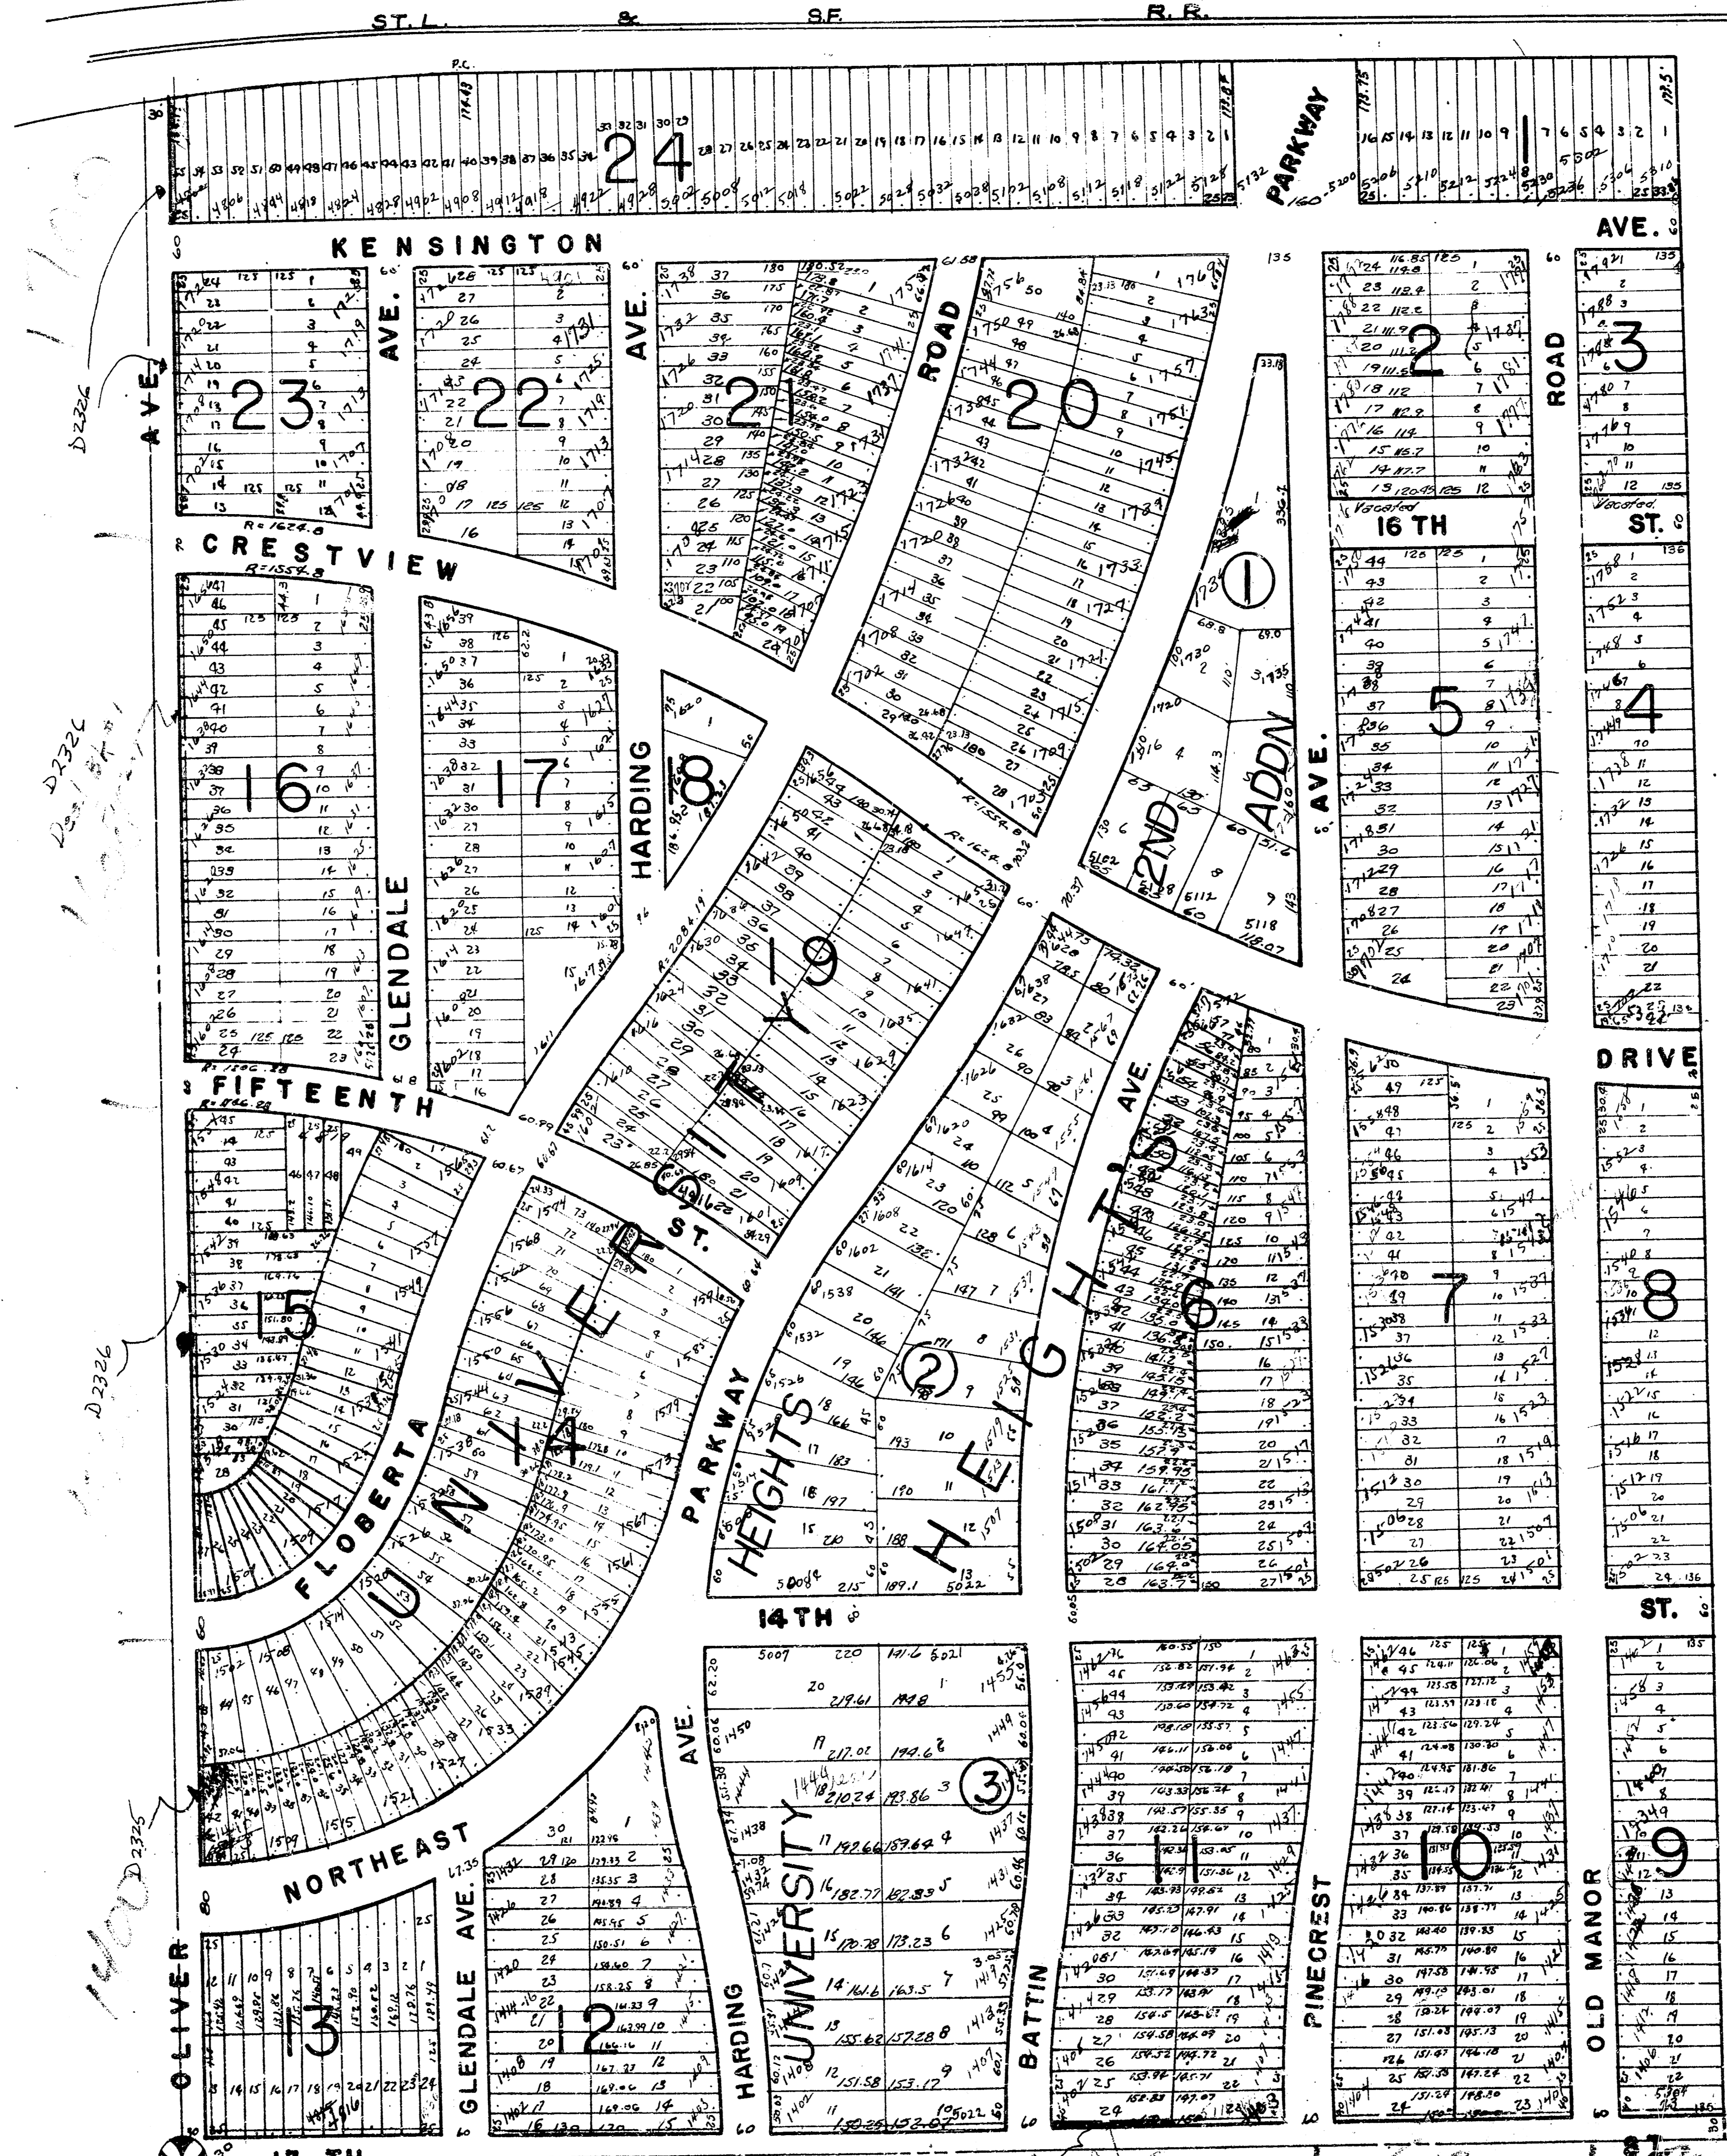

D2324
17700

D2324
14000

D2326

D2325
14000

4800 | 4900 | 5000 | 5100 | 5200 | 5300 | 5400