E. 1/2 of SW. 1/4 & W. 1/2 of SE. 1/4 of SEC. 23-27-1E.
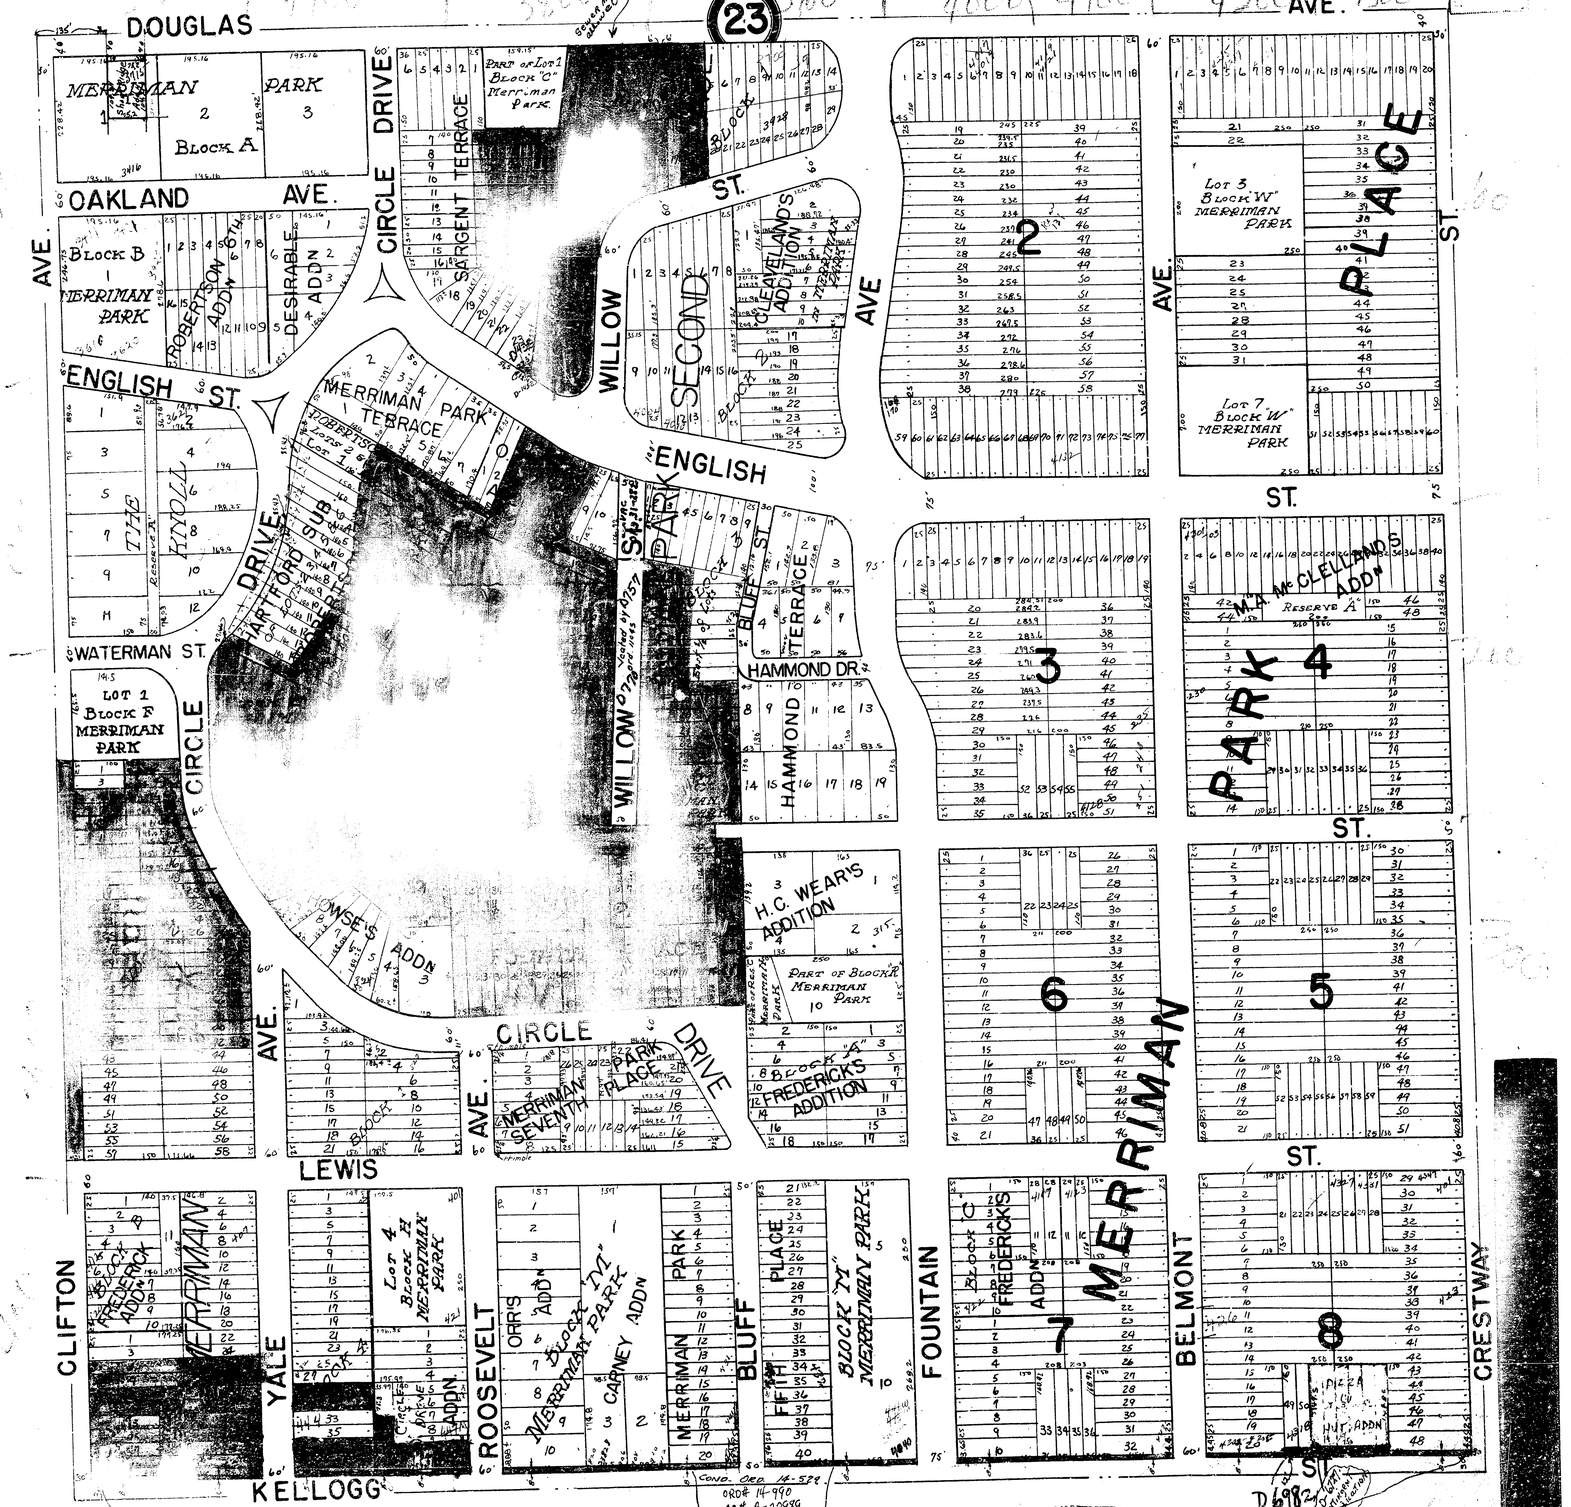
11-52 5-22