


N.E. 1/4 SEC. 26 TWP. 27 R.1.E.

11-55

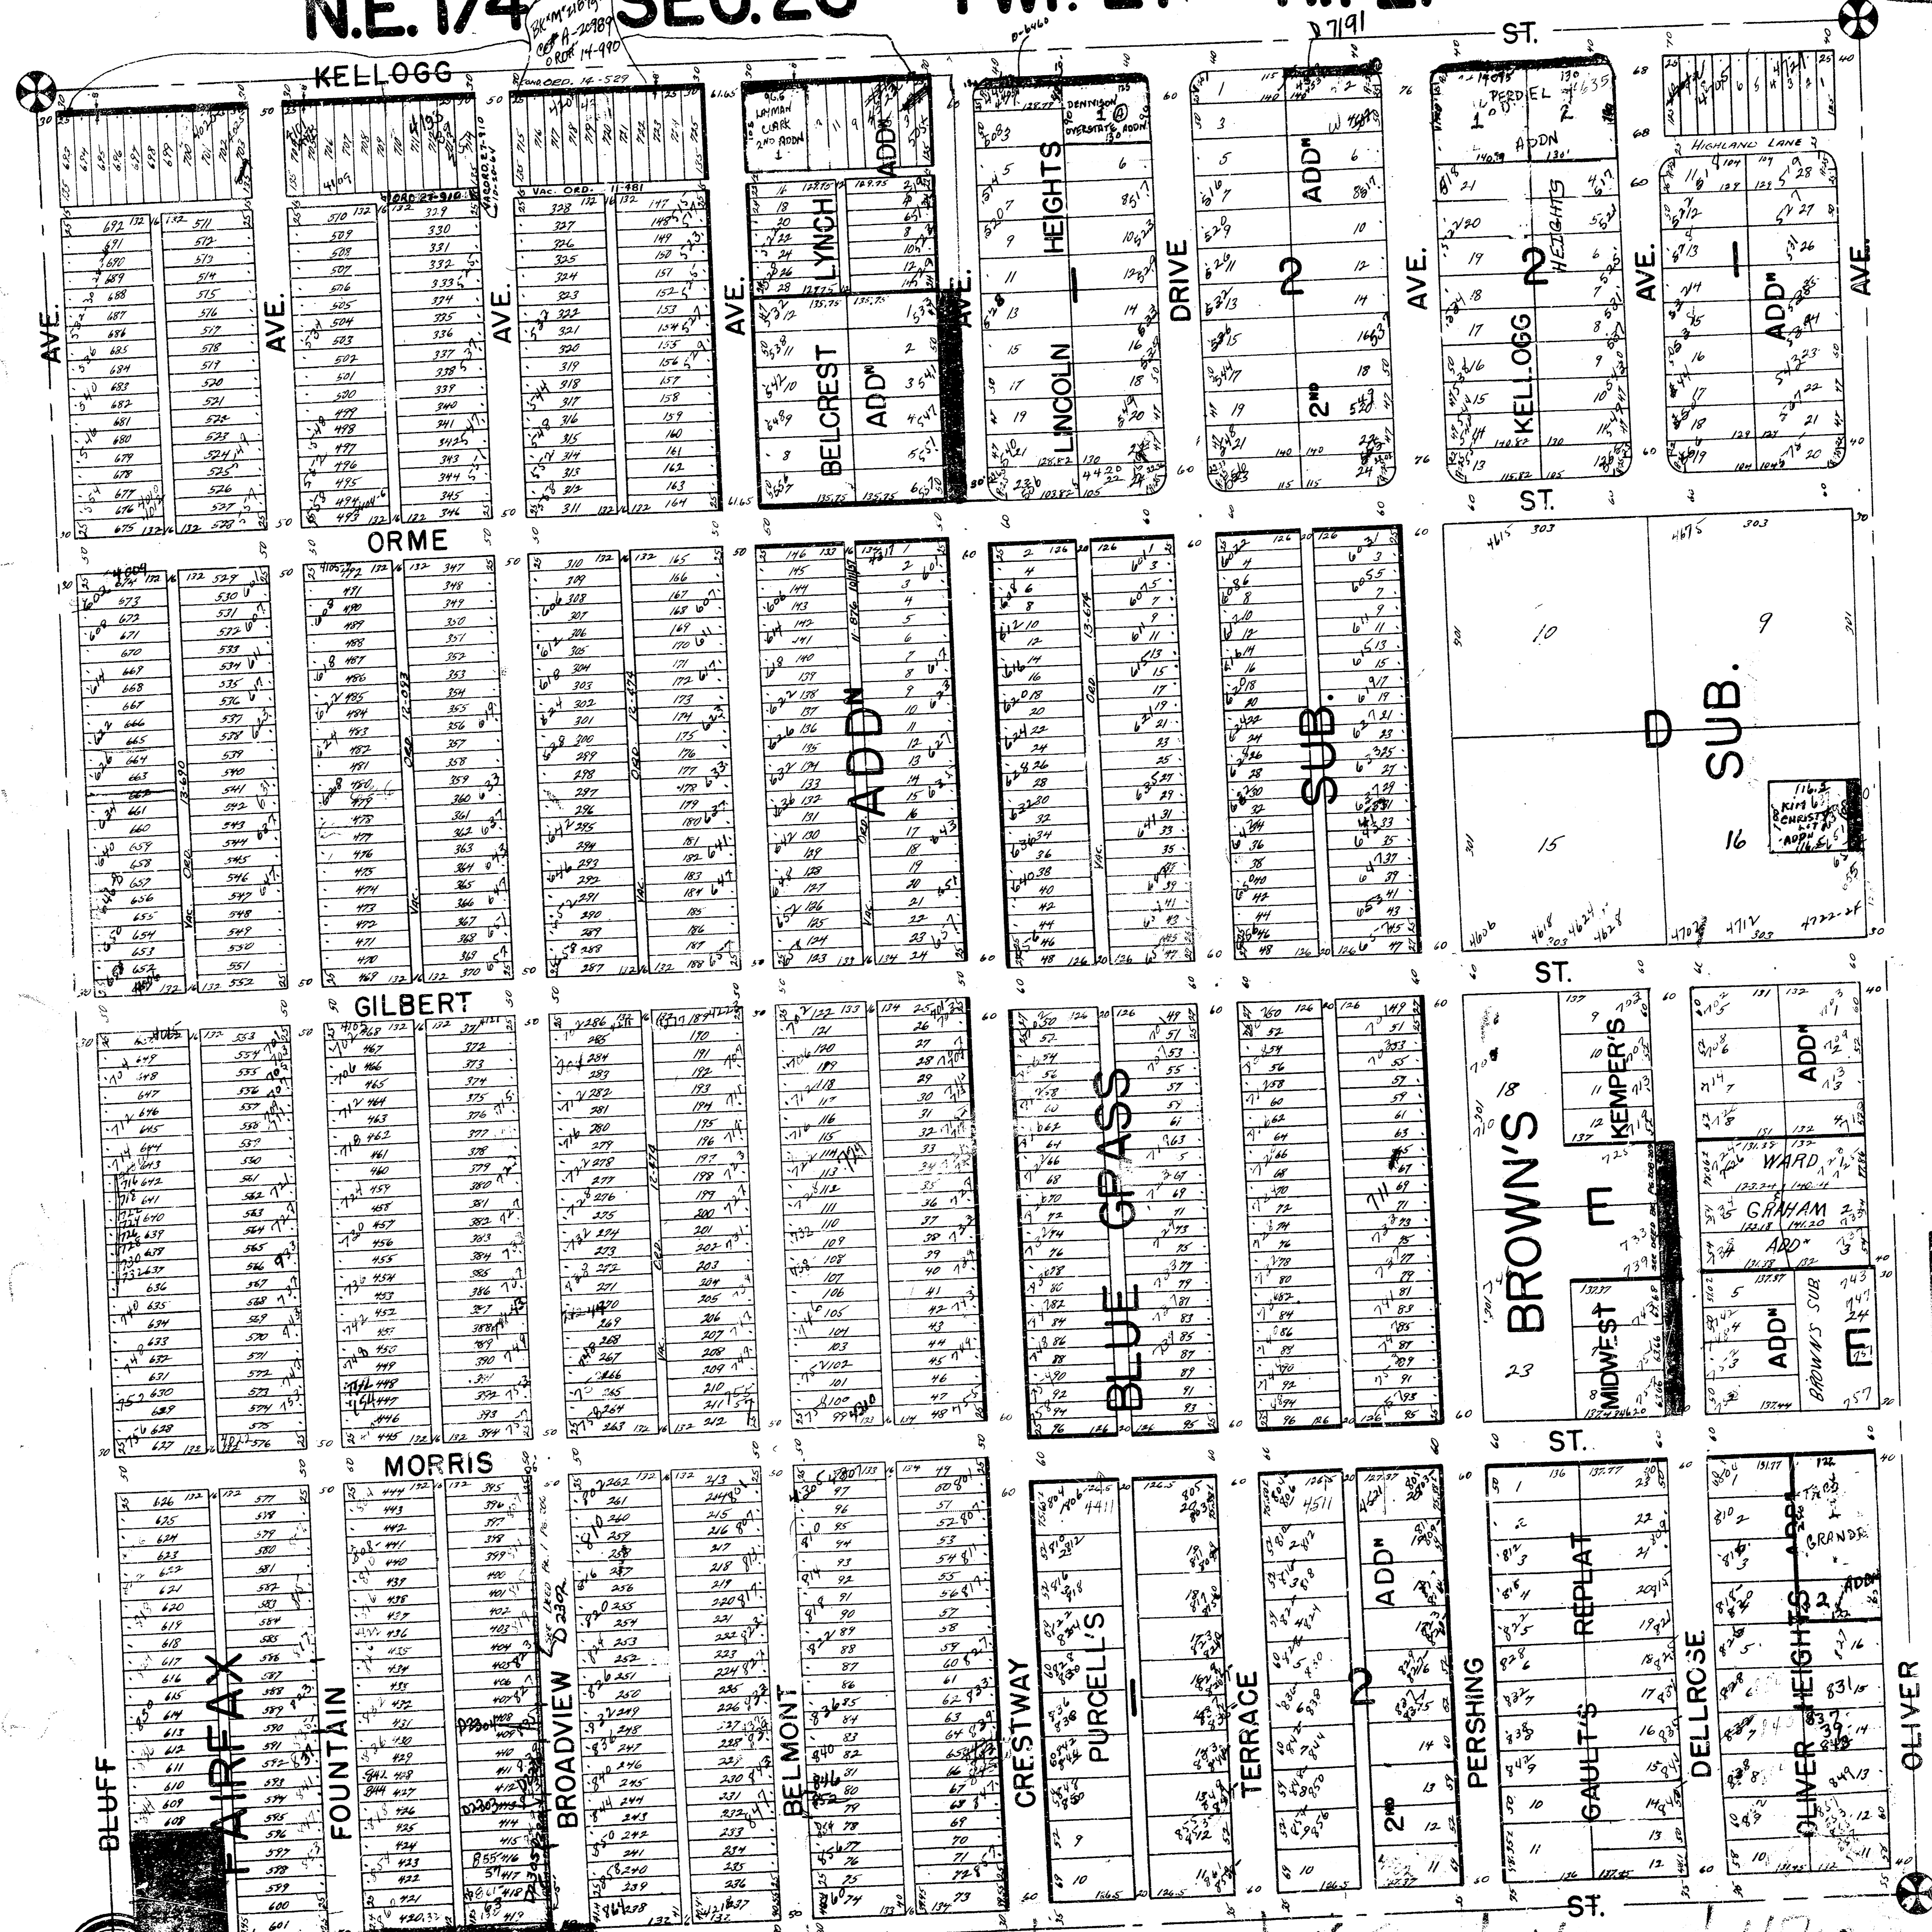

26

4000 | 4100 | 4200 | 4300 | 4400 | 4500 | 4600 | 4700