


S.W. 1/4 SEC. 25 TWP. 27 S. R. 1 E.

11-59

25

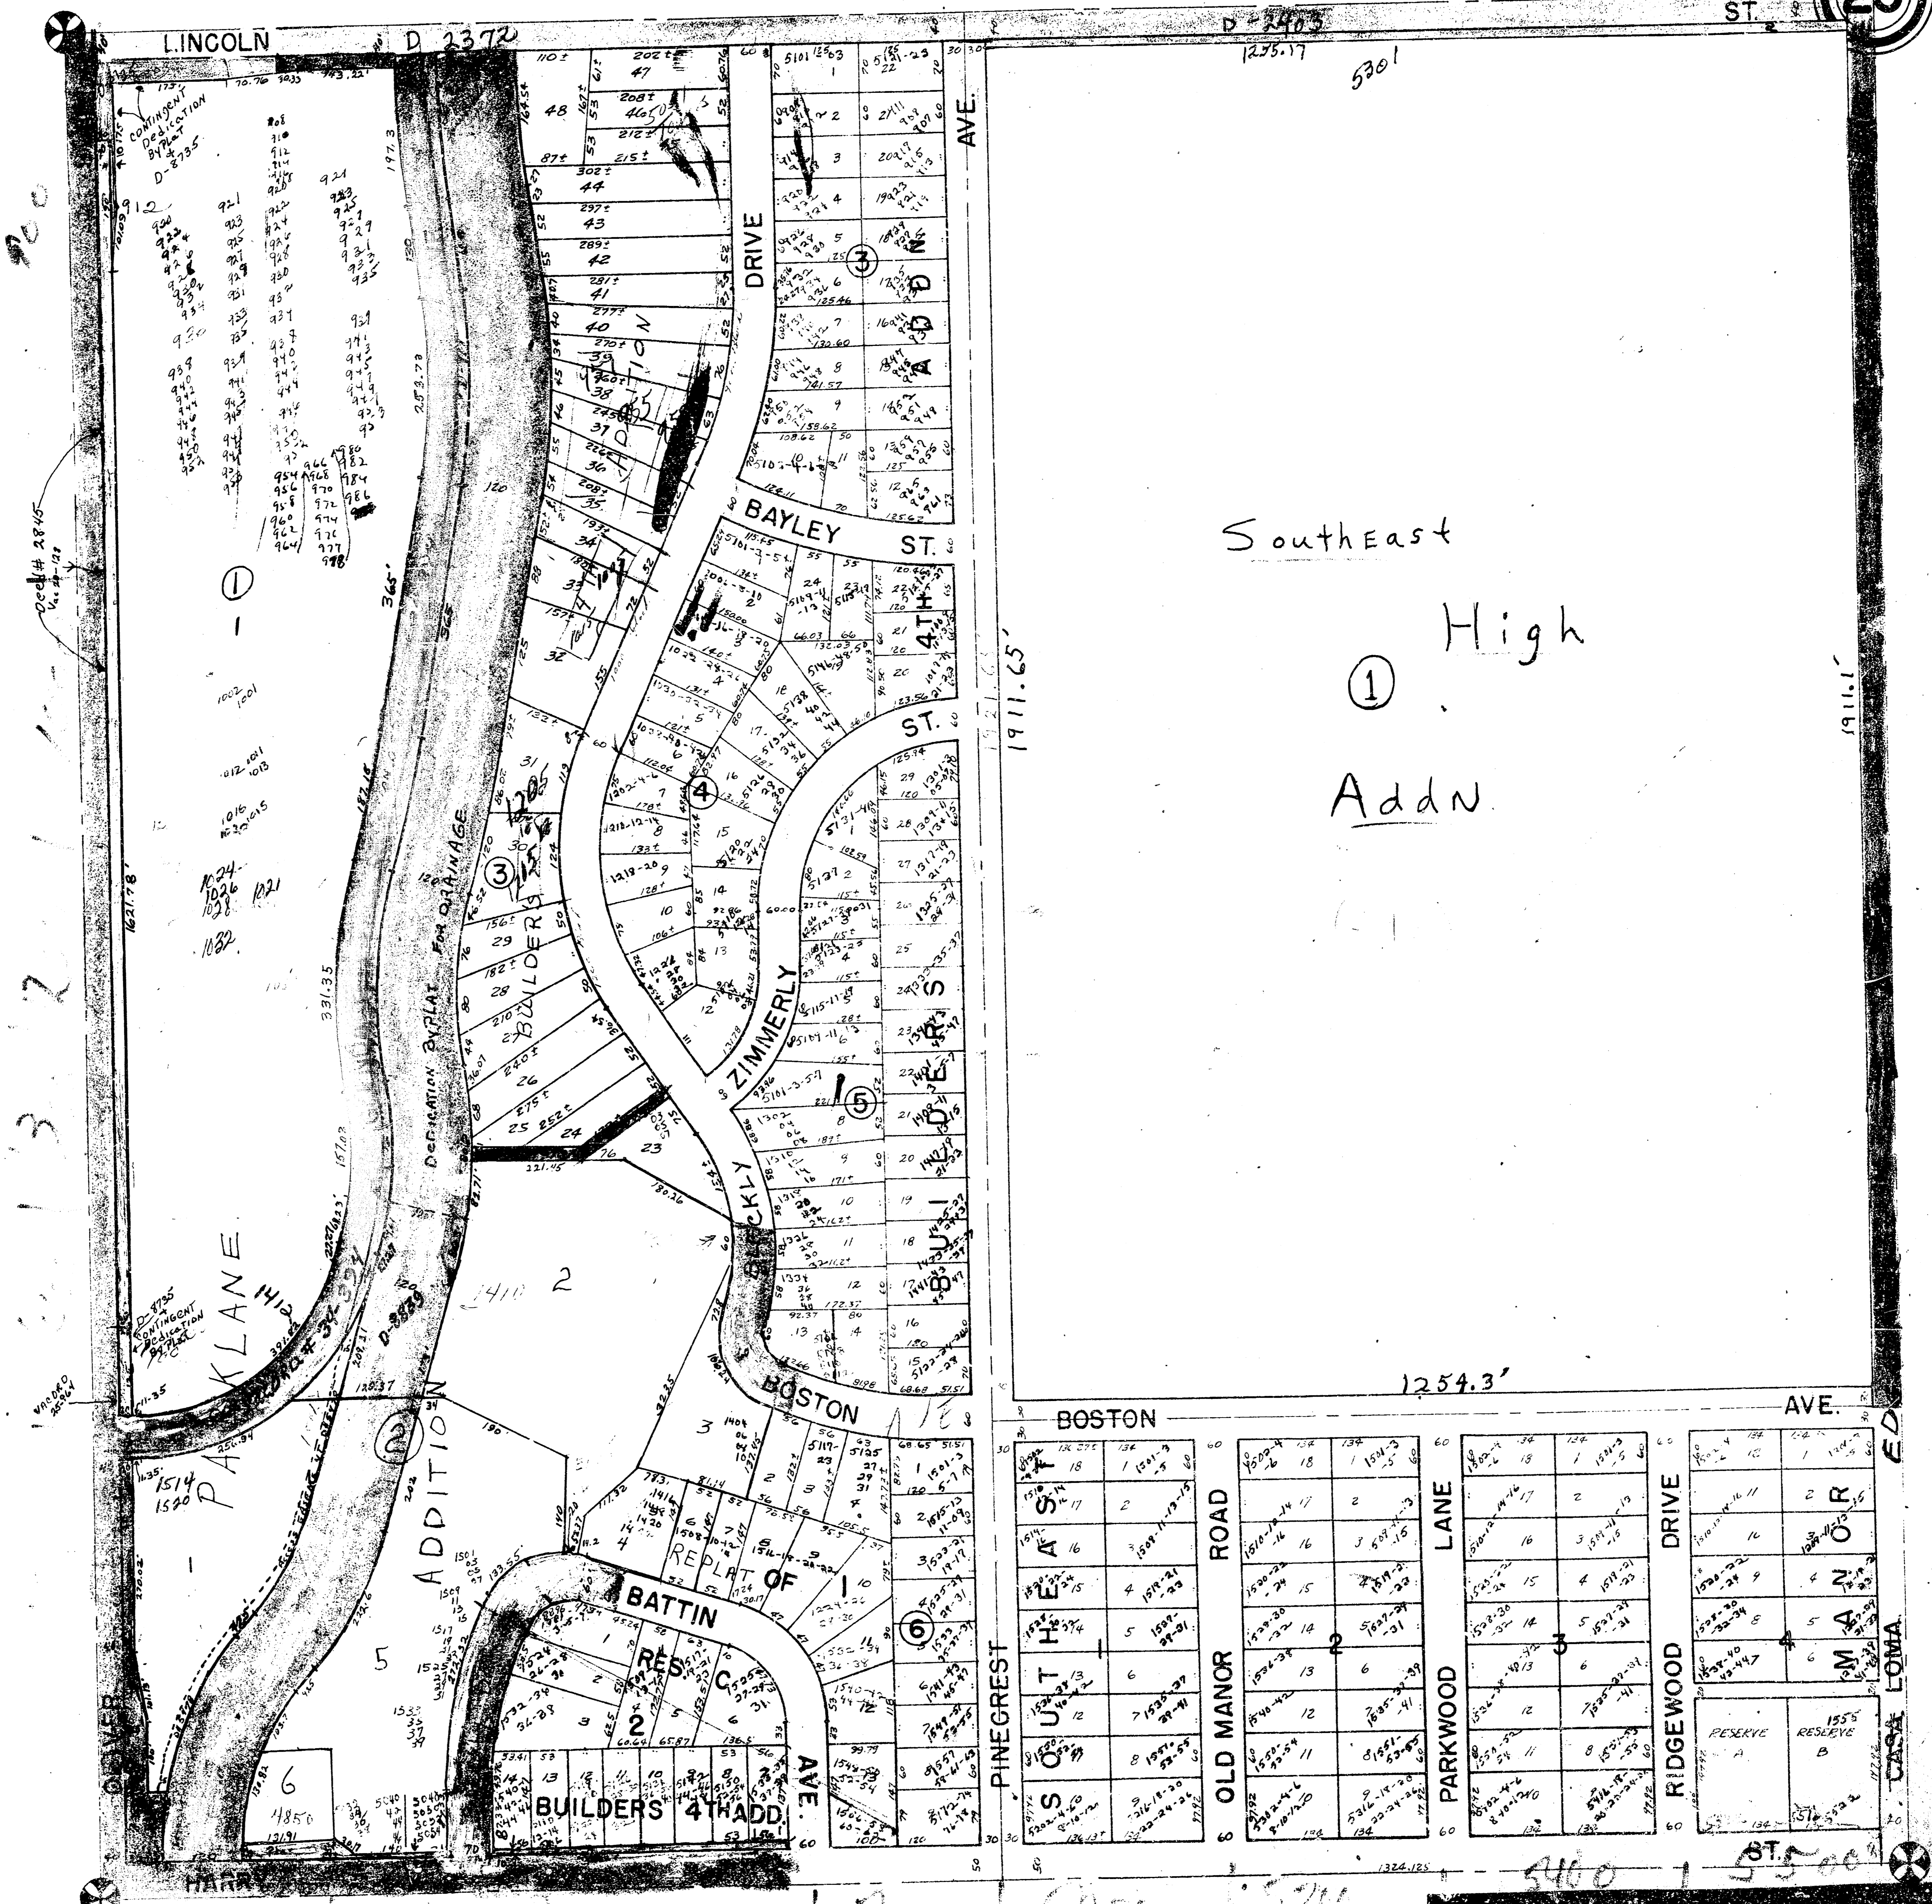

Southeast
① High
Addn

60132

4800 5100 5300 5500

5400 5500