9-85

N.E. ¼ SEC. 20, TWP. 28 S. R. 1 E.

9-85
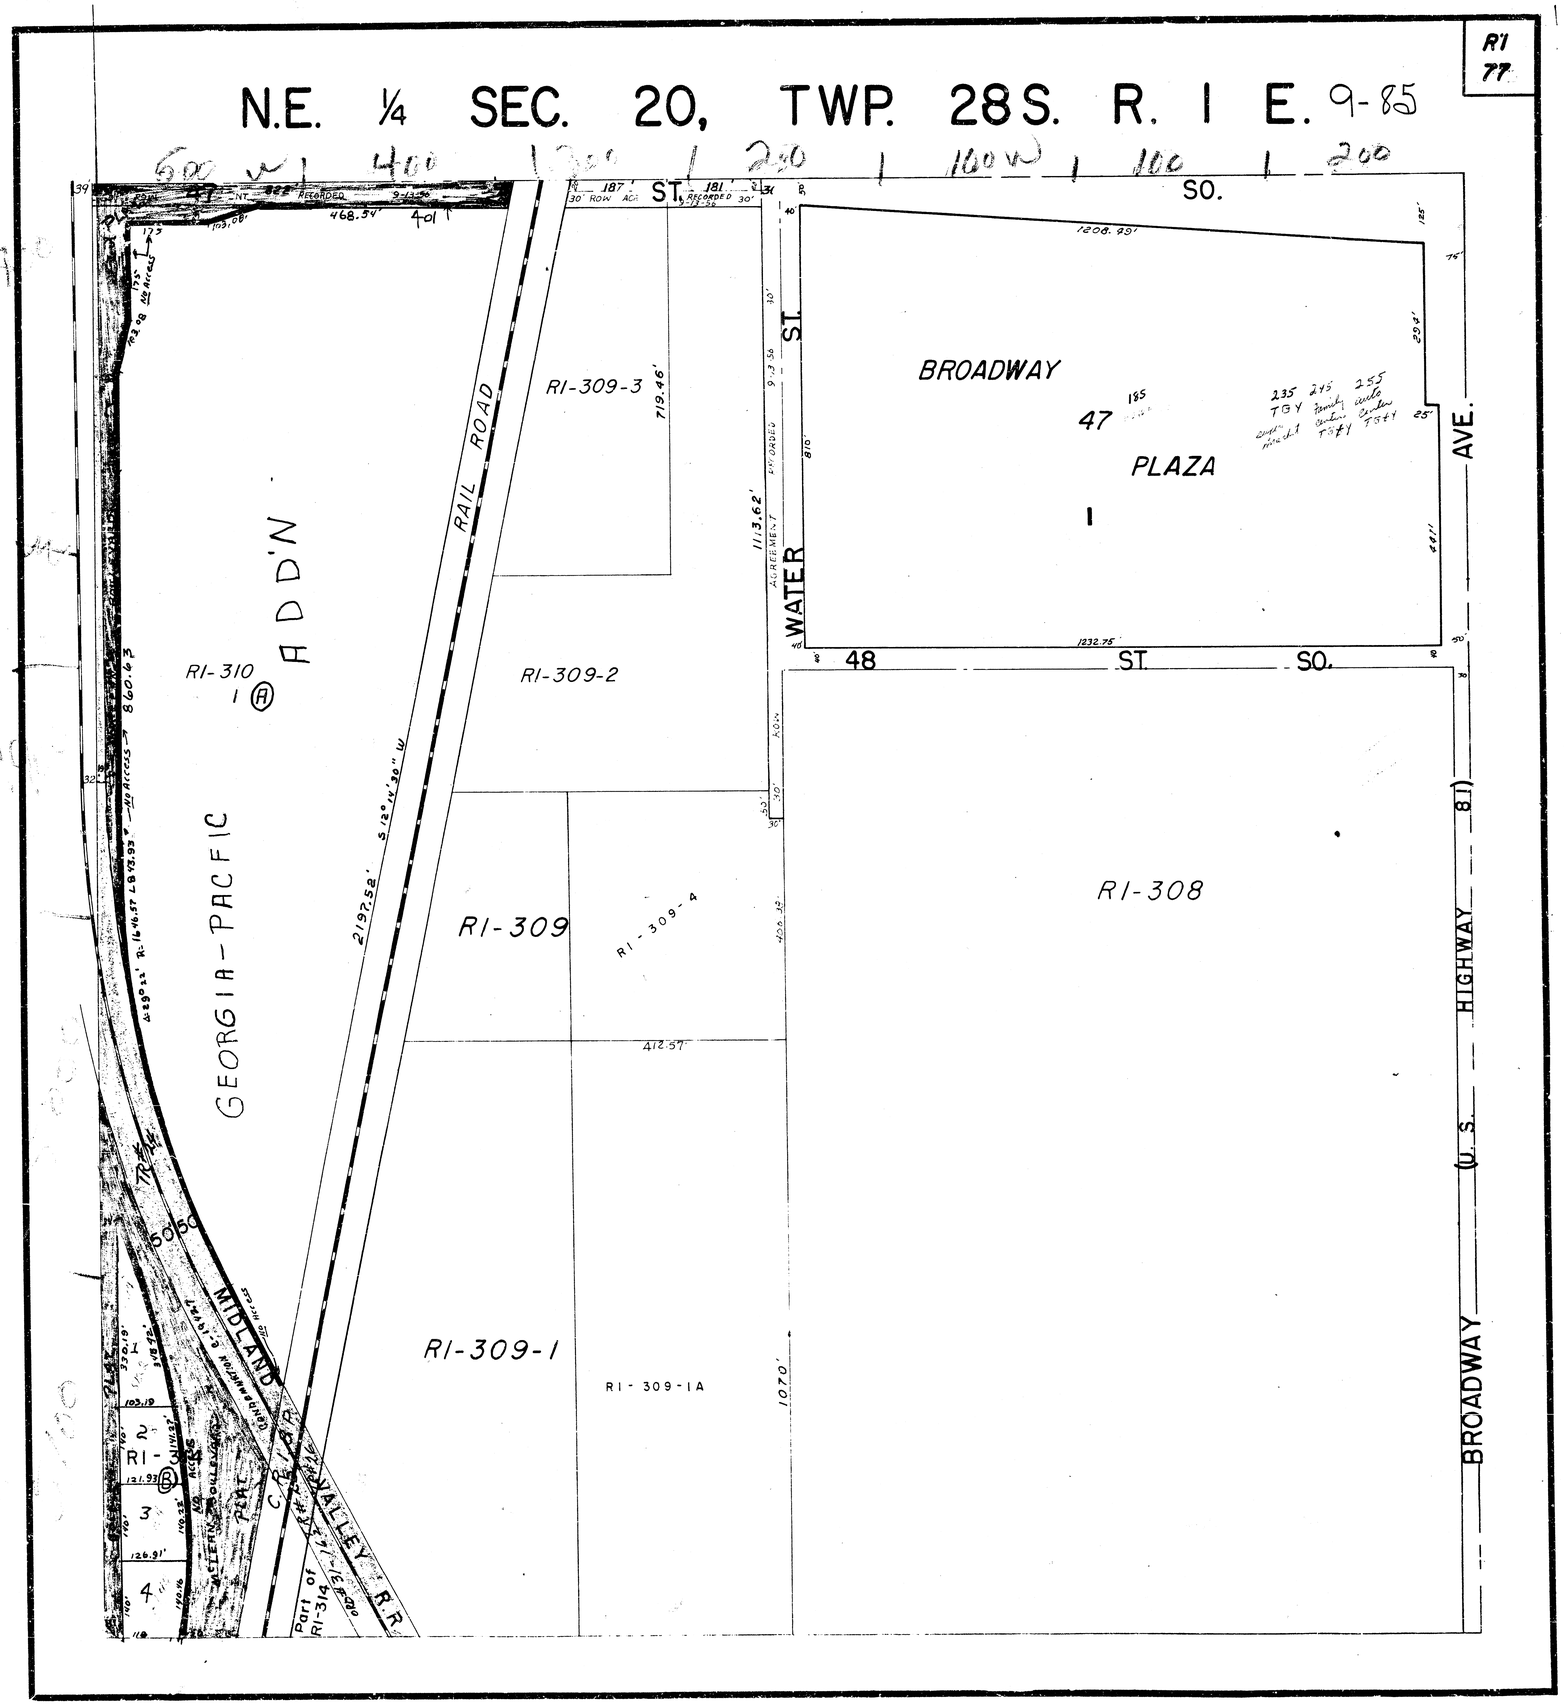
R1
77