


10-28

# S.W. 1/4 SEC. 34, TWP. 26 S, R. 1 E.

10-28

1700 | 1800 | 1900 | 2000 | 2100 | 2200 | 2300 | 2400

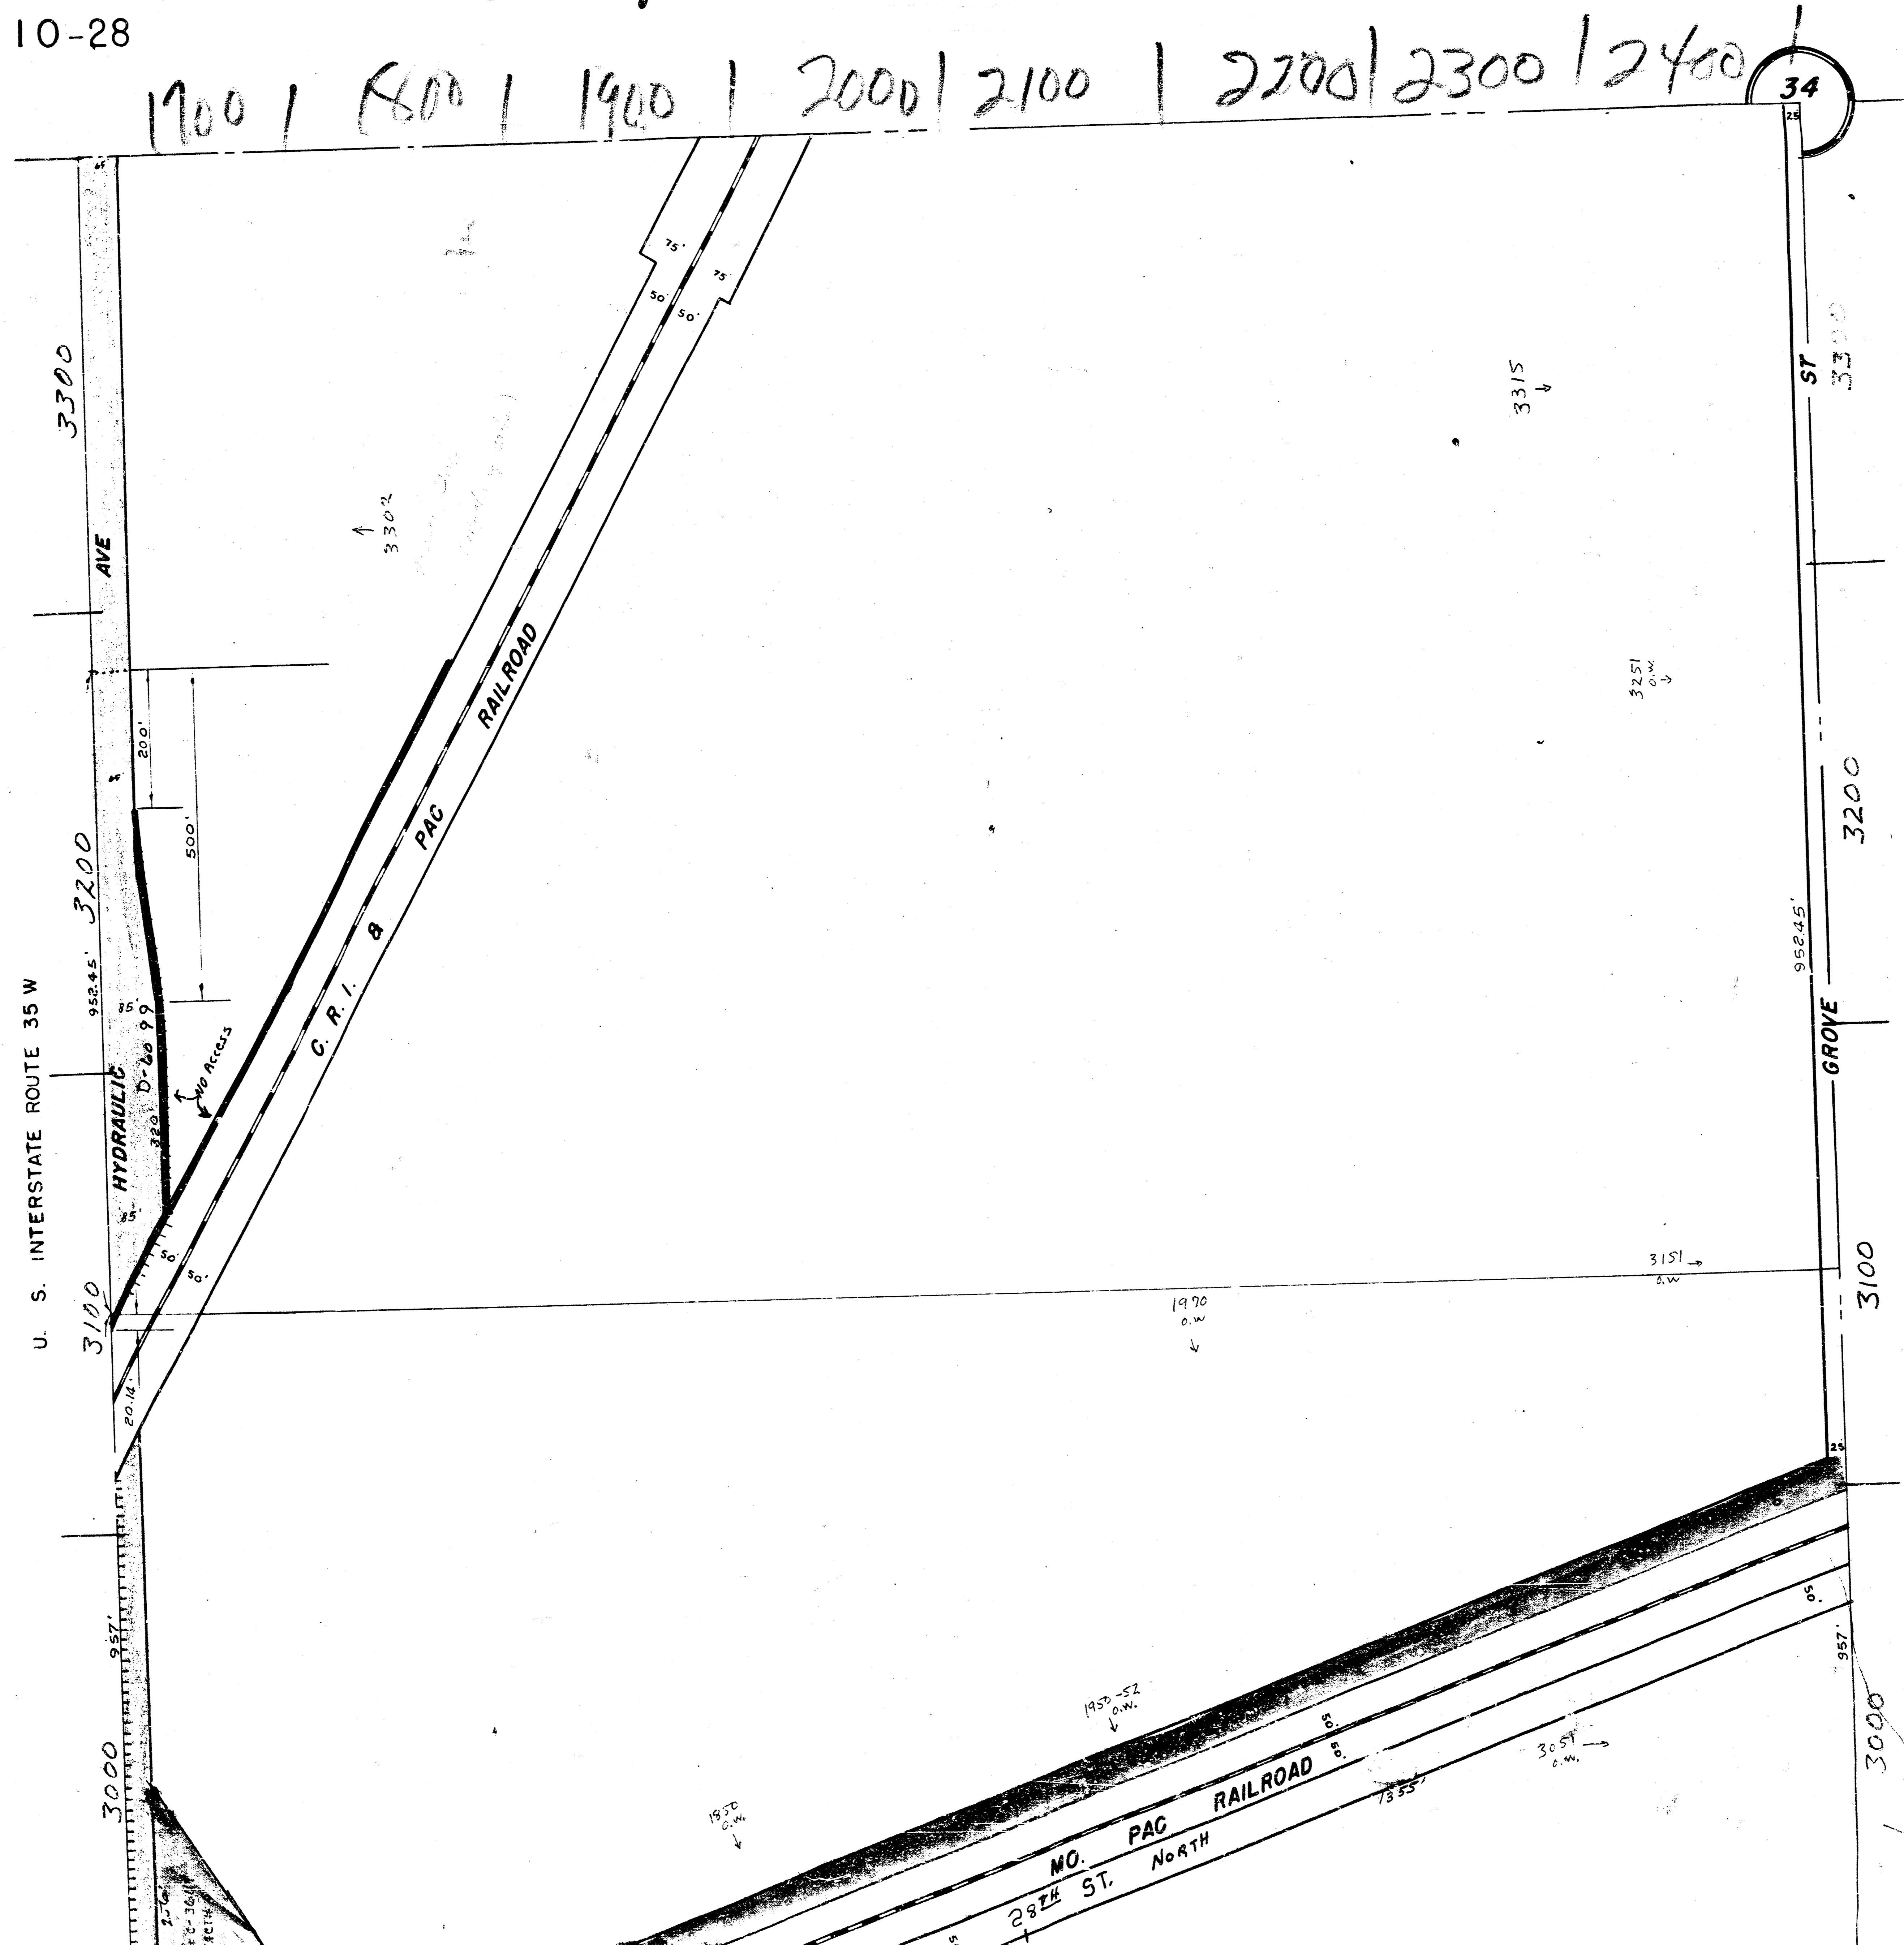

O.W. oil well