


S.W. QUAR. SEC. 3, T. 27 S, R. 1 E.

10-34

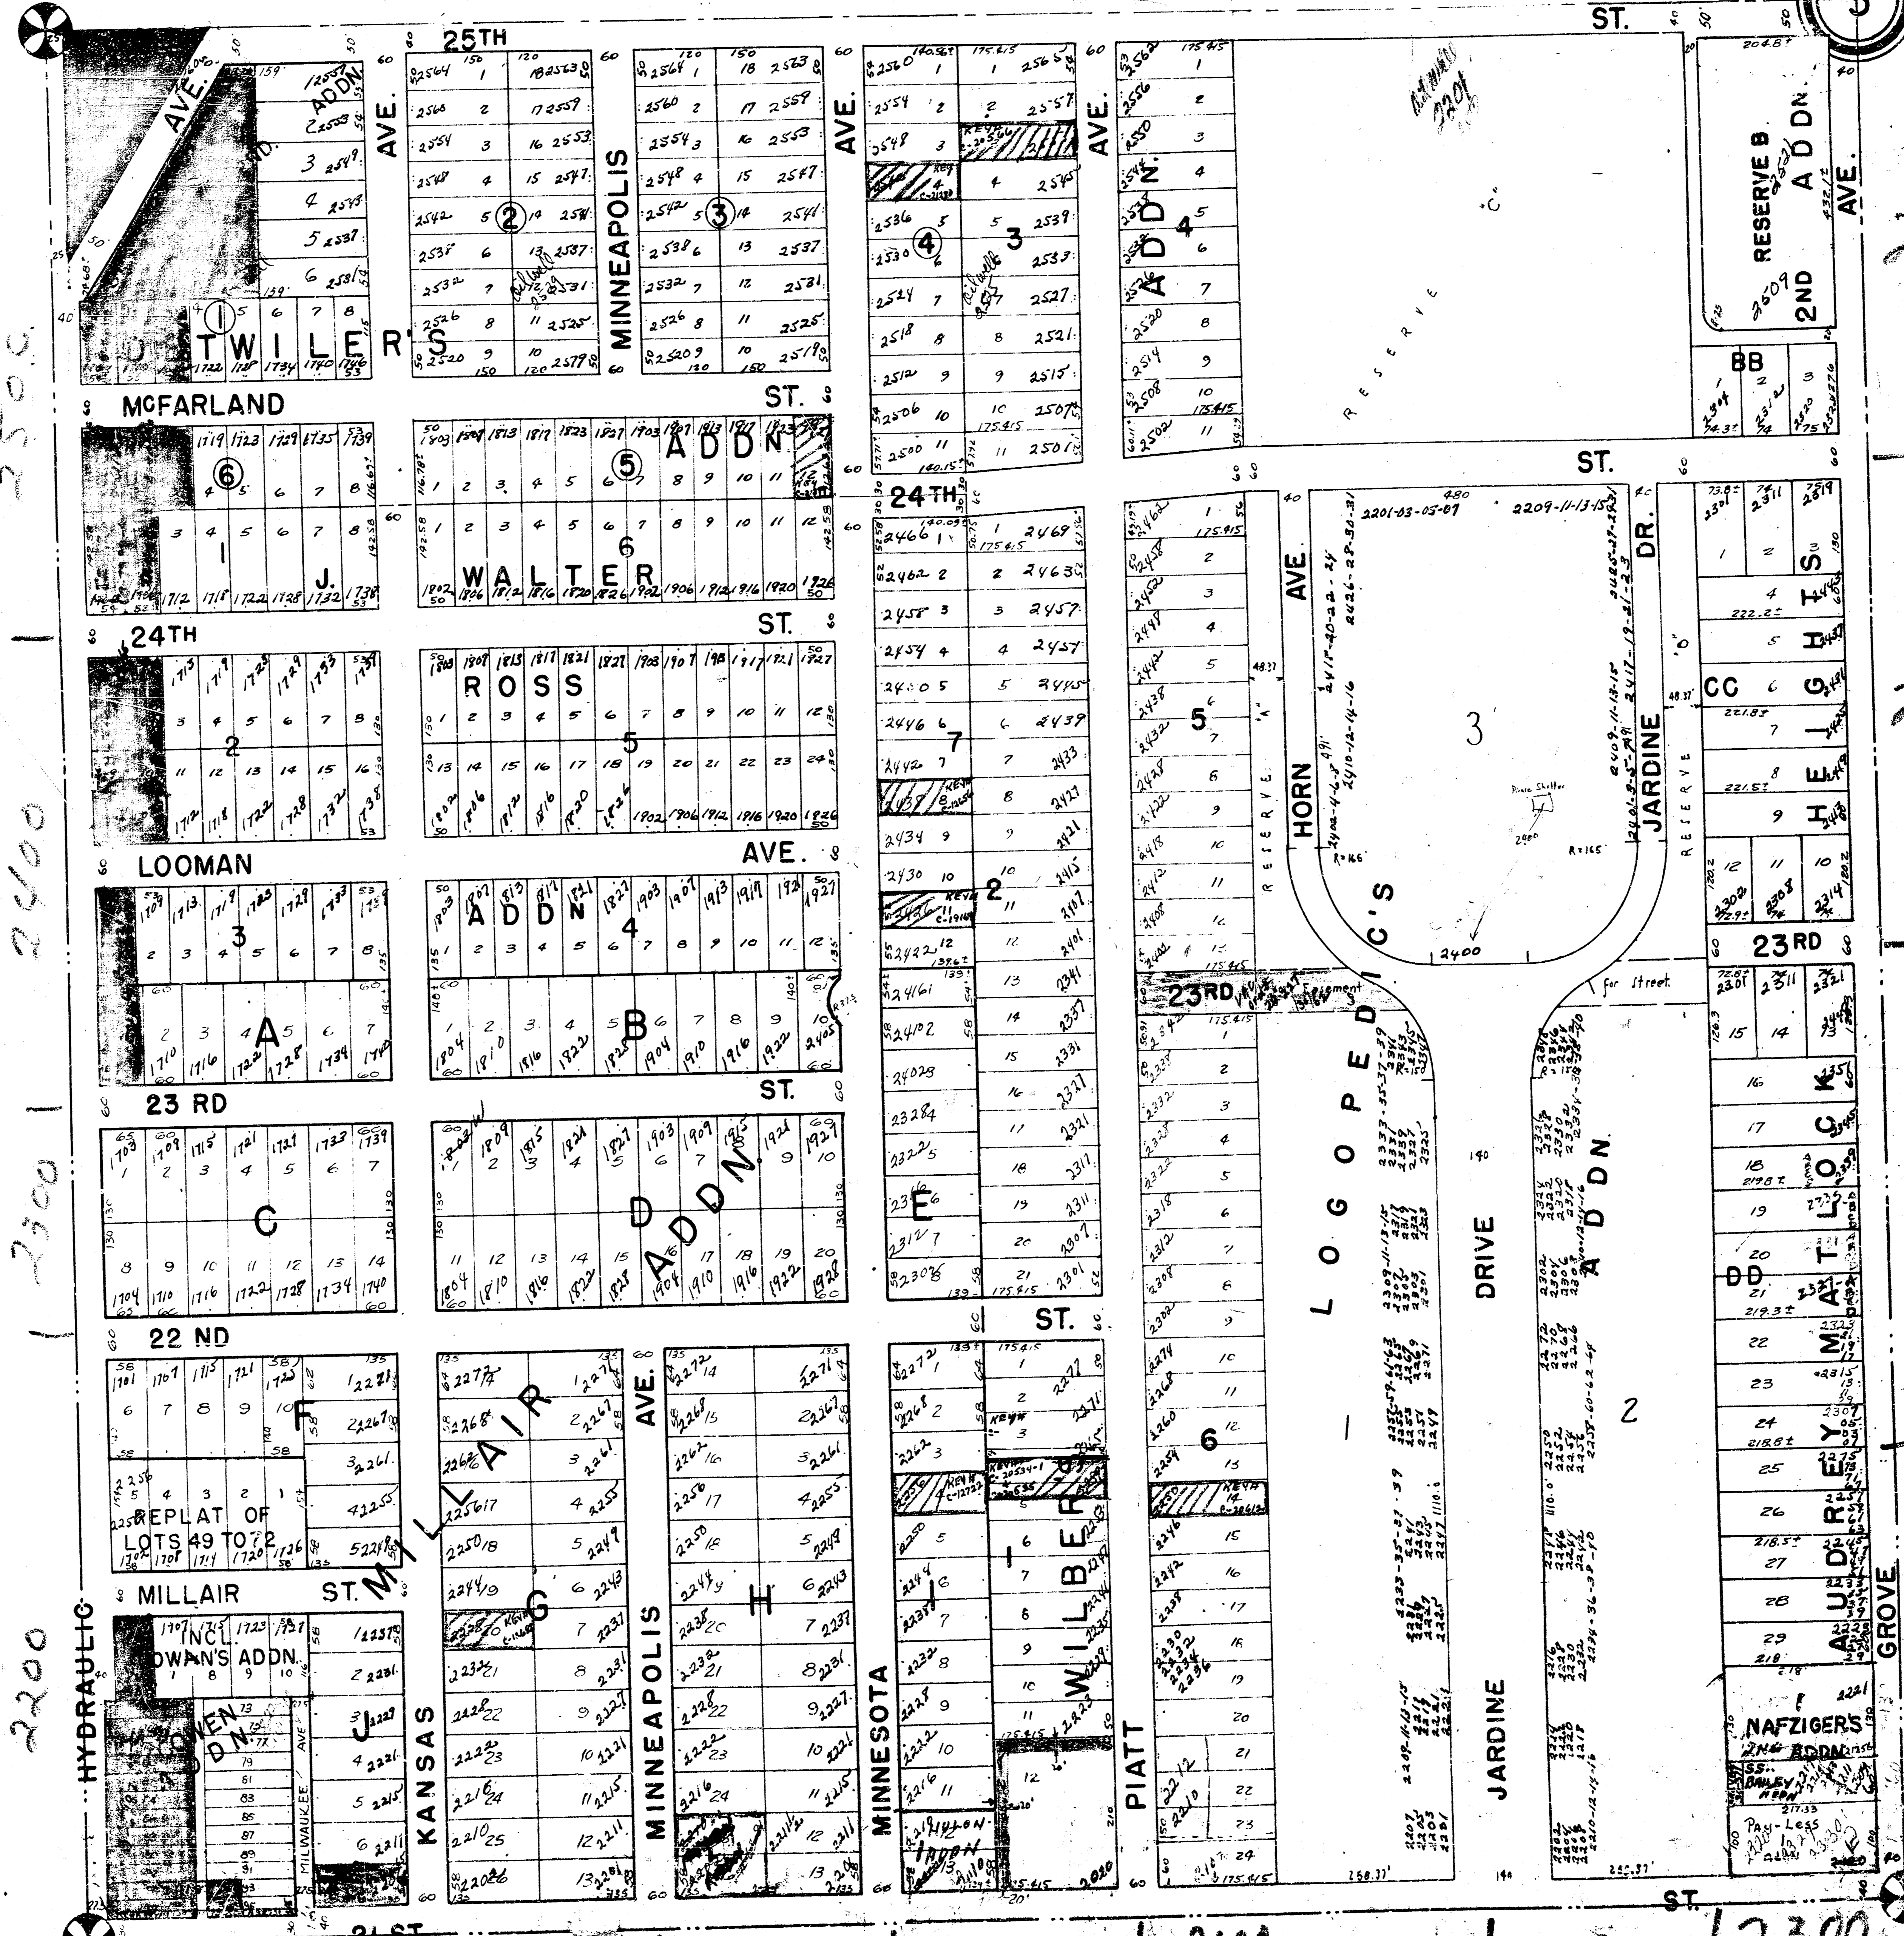

2500  
2400  
2300  
2200

1700 | 1800 | 1900 | 2000 | 2100 | 2200 | 2300

2500

2400

2300

2200