


N.E. 1/4 SEC. 15, TWP. 27, R. 1 E.

10-44

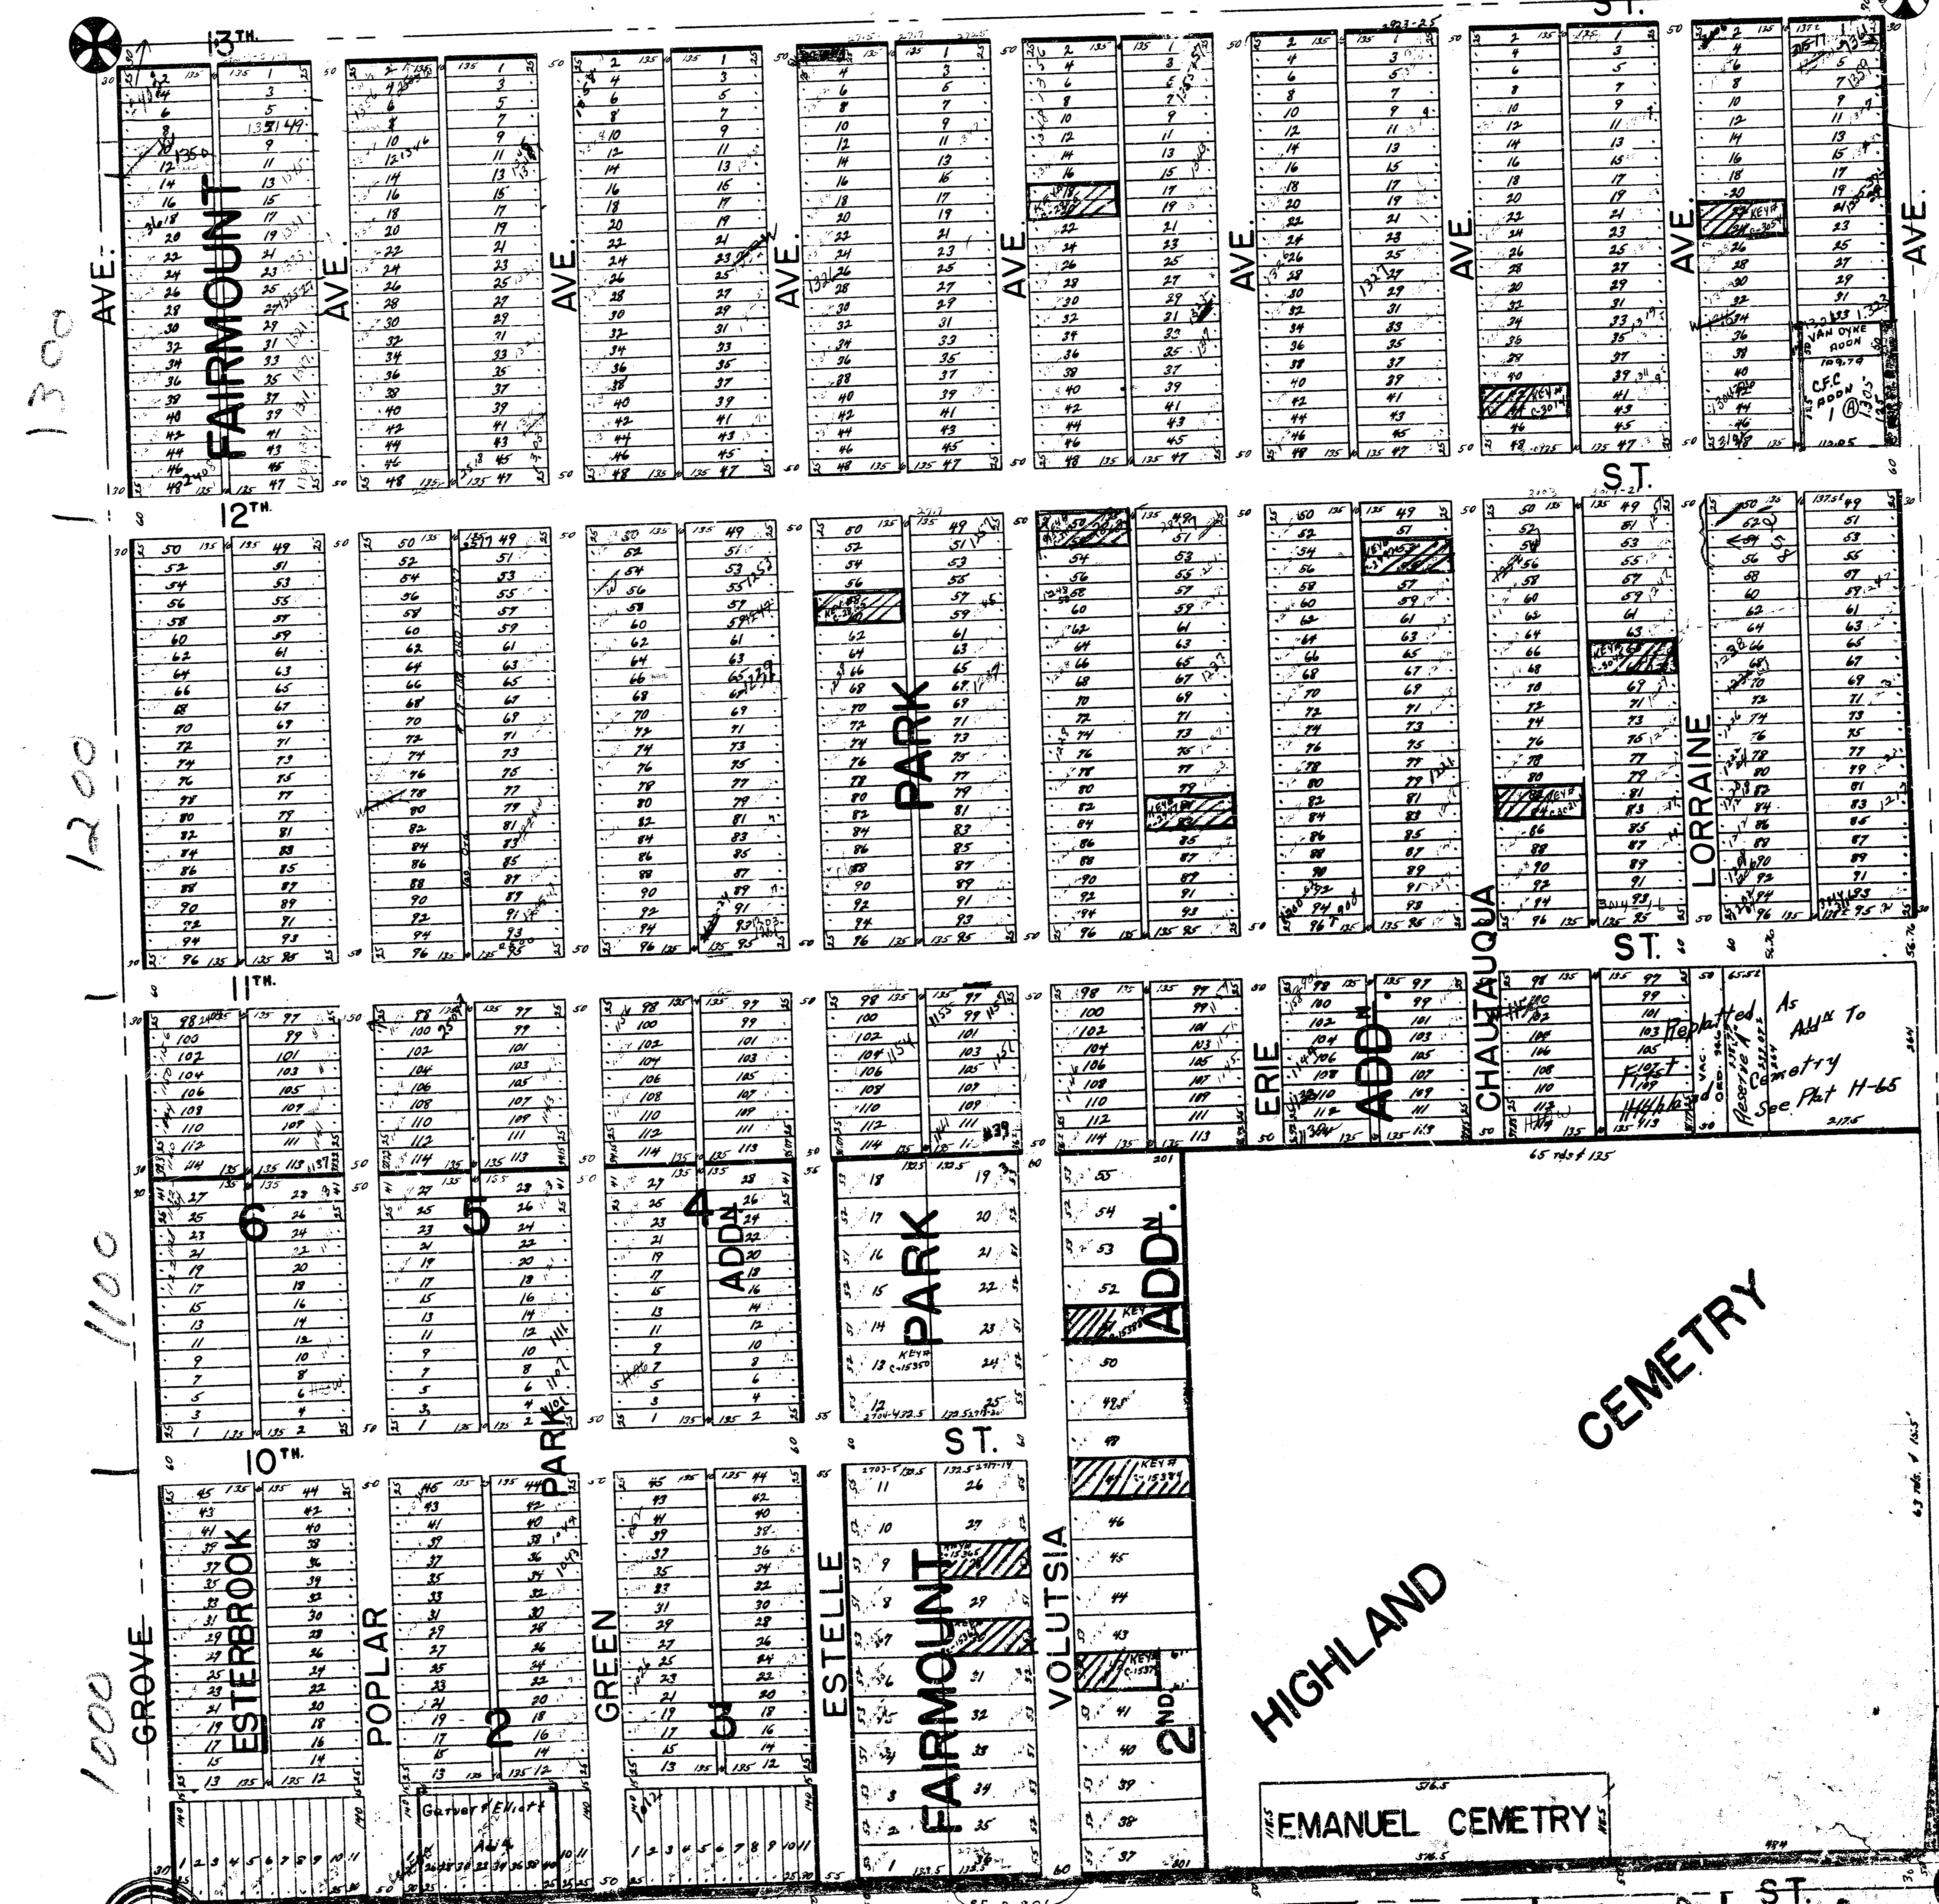

1300

1200

1100

1000

2400 | 2500 | 2600 | 2700 | 2800 | 2900 | 3000 | 3100

15

CEMETERY

HIGHLAND

EMANUEL CEMETRY

HILLSIDE