


NW 1/4 SEC. 23 TWP. 27, R.I.E.

10-51

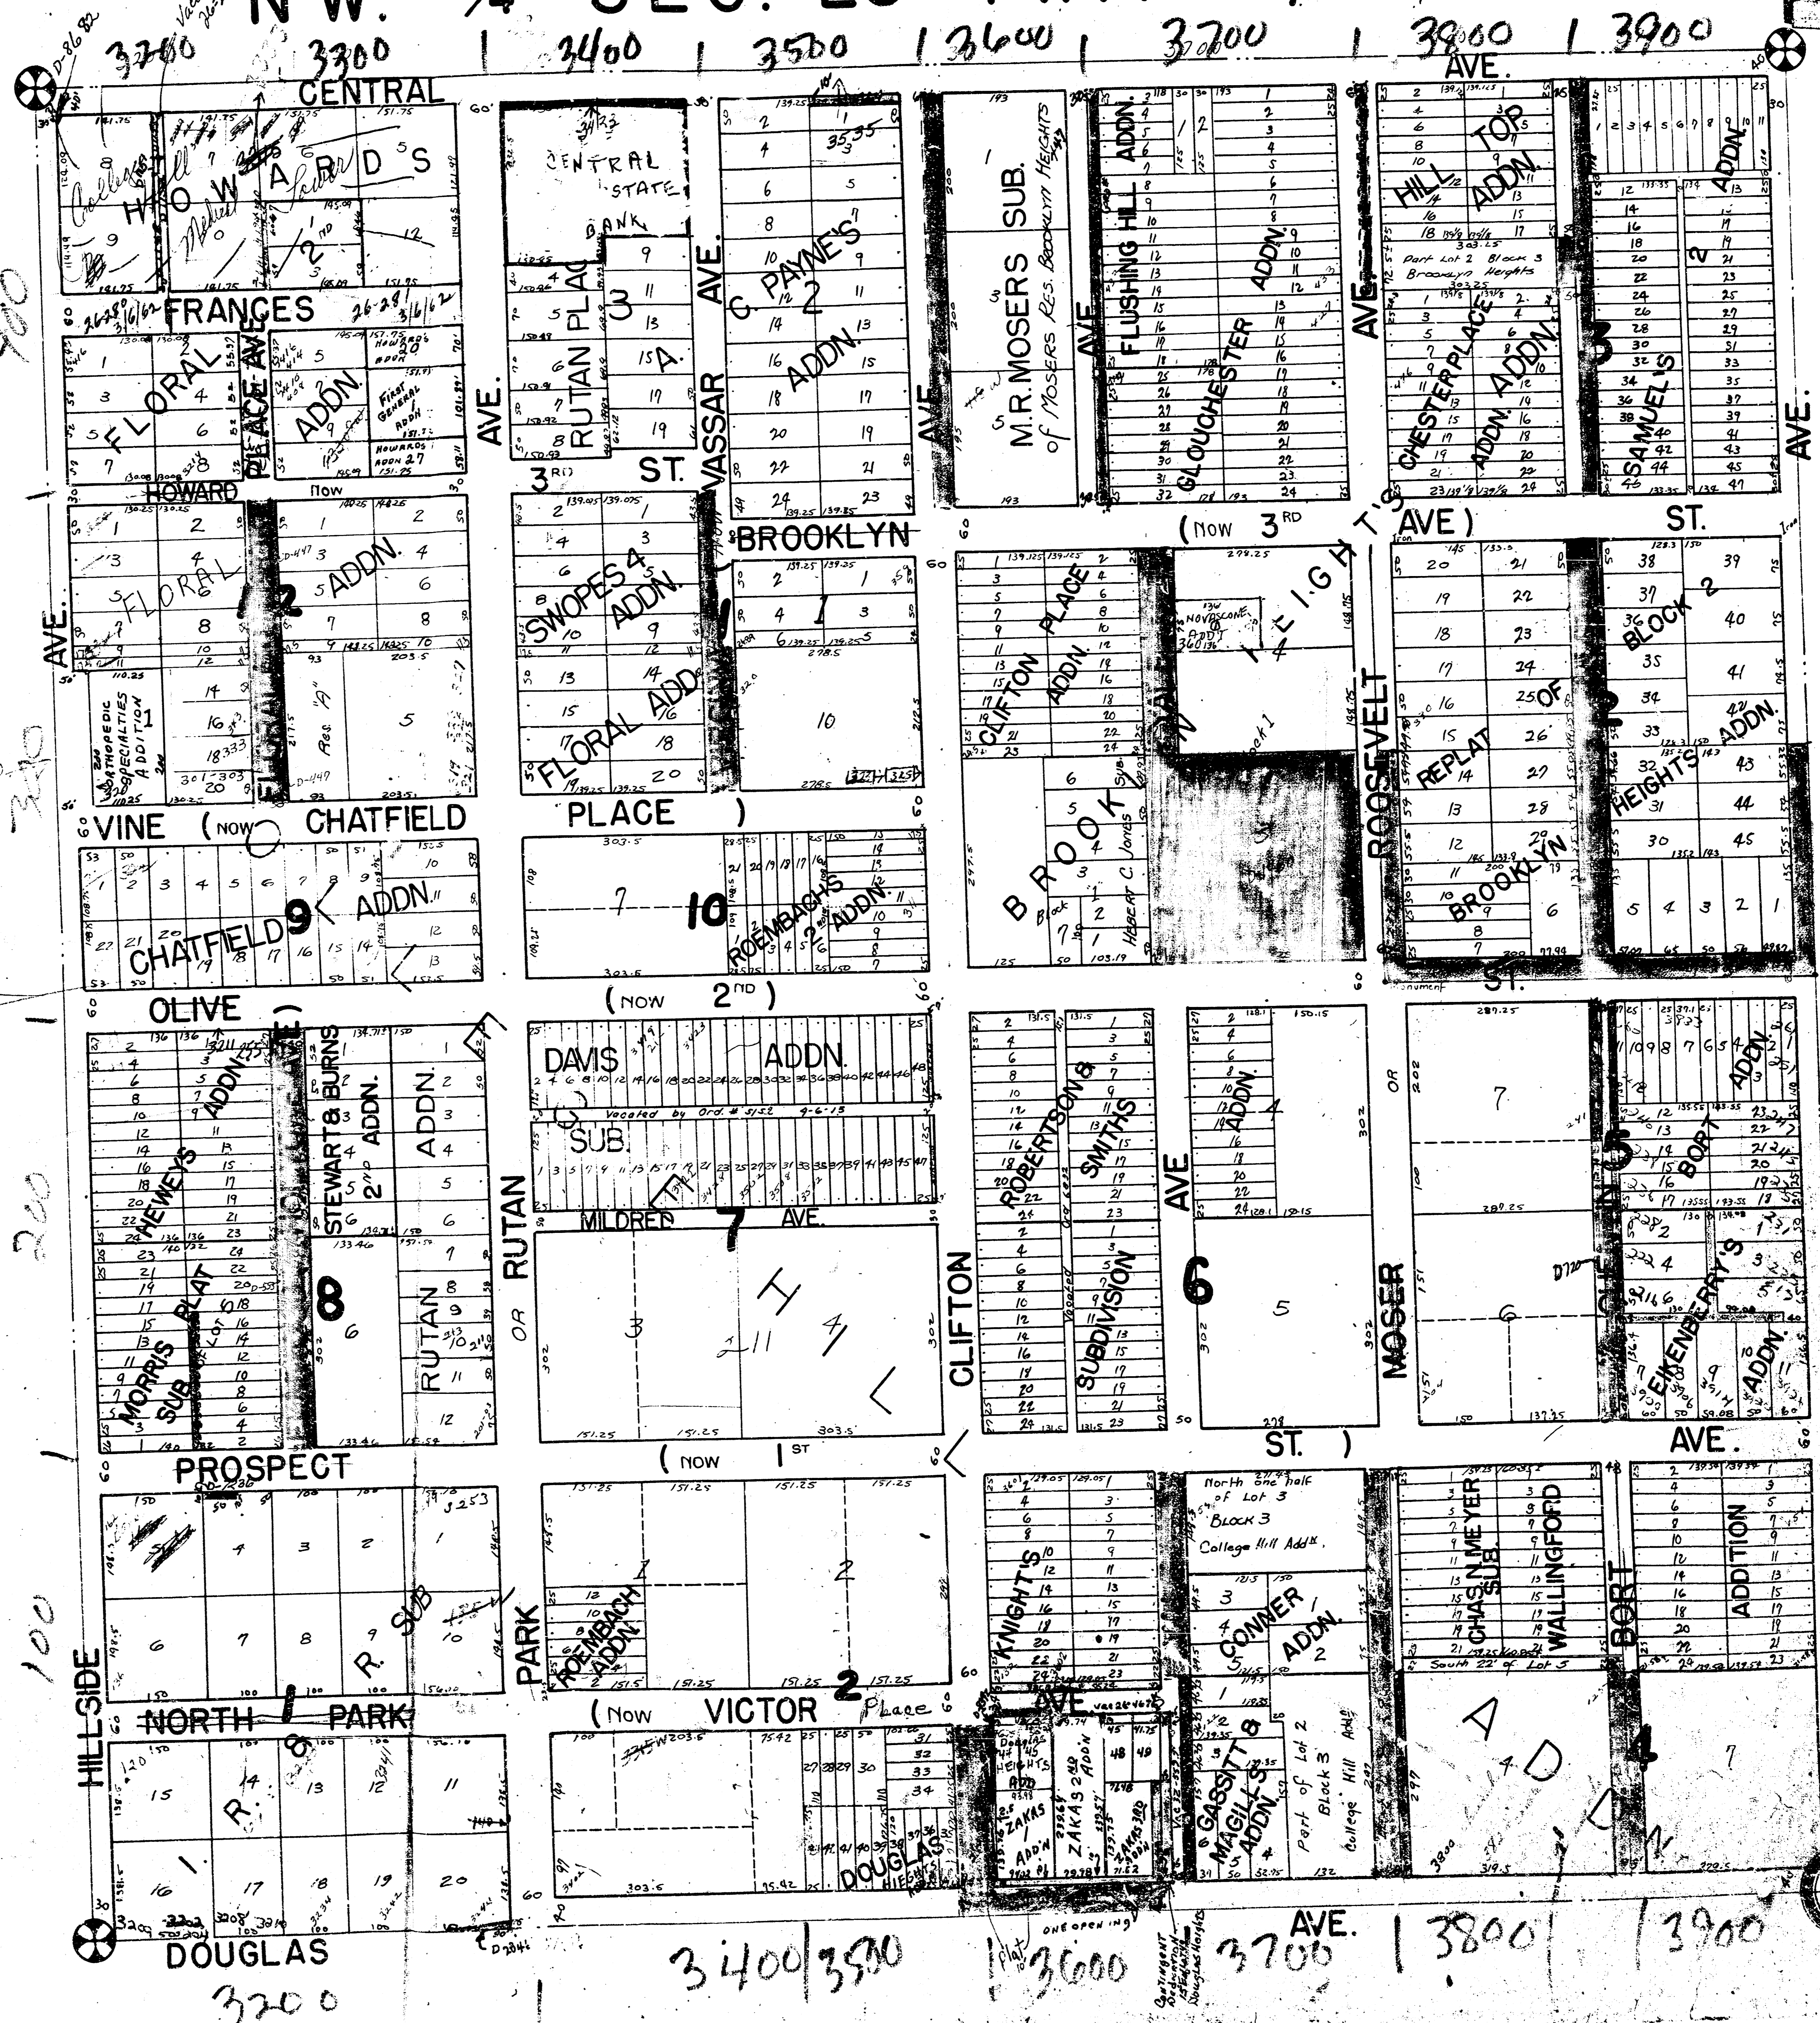

400

300

200

100

3400/3500

3600

3700 | 3800 | 3900

23