10-54

W. HALF S.W. QUAR. SEC. 23 TWP. 27 R.I.E.

10-54
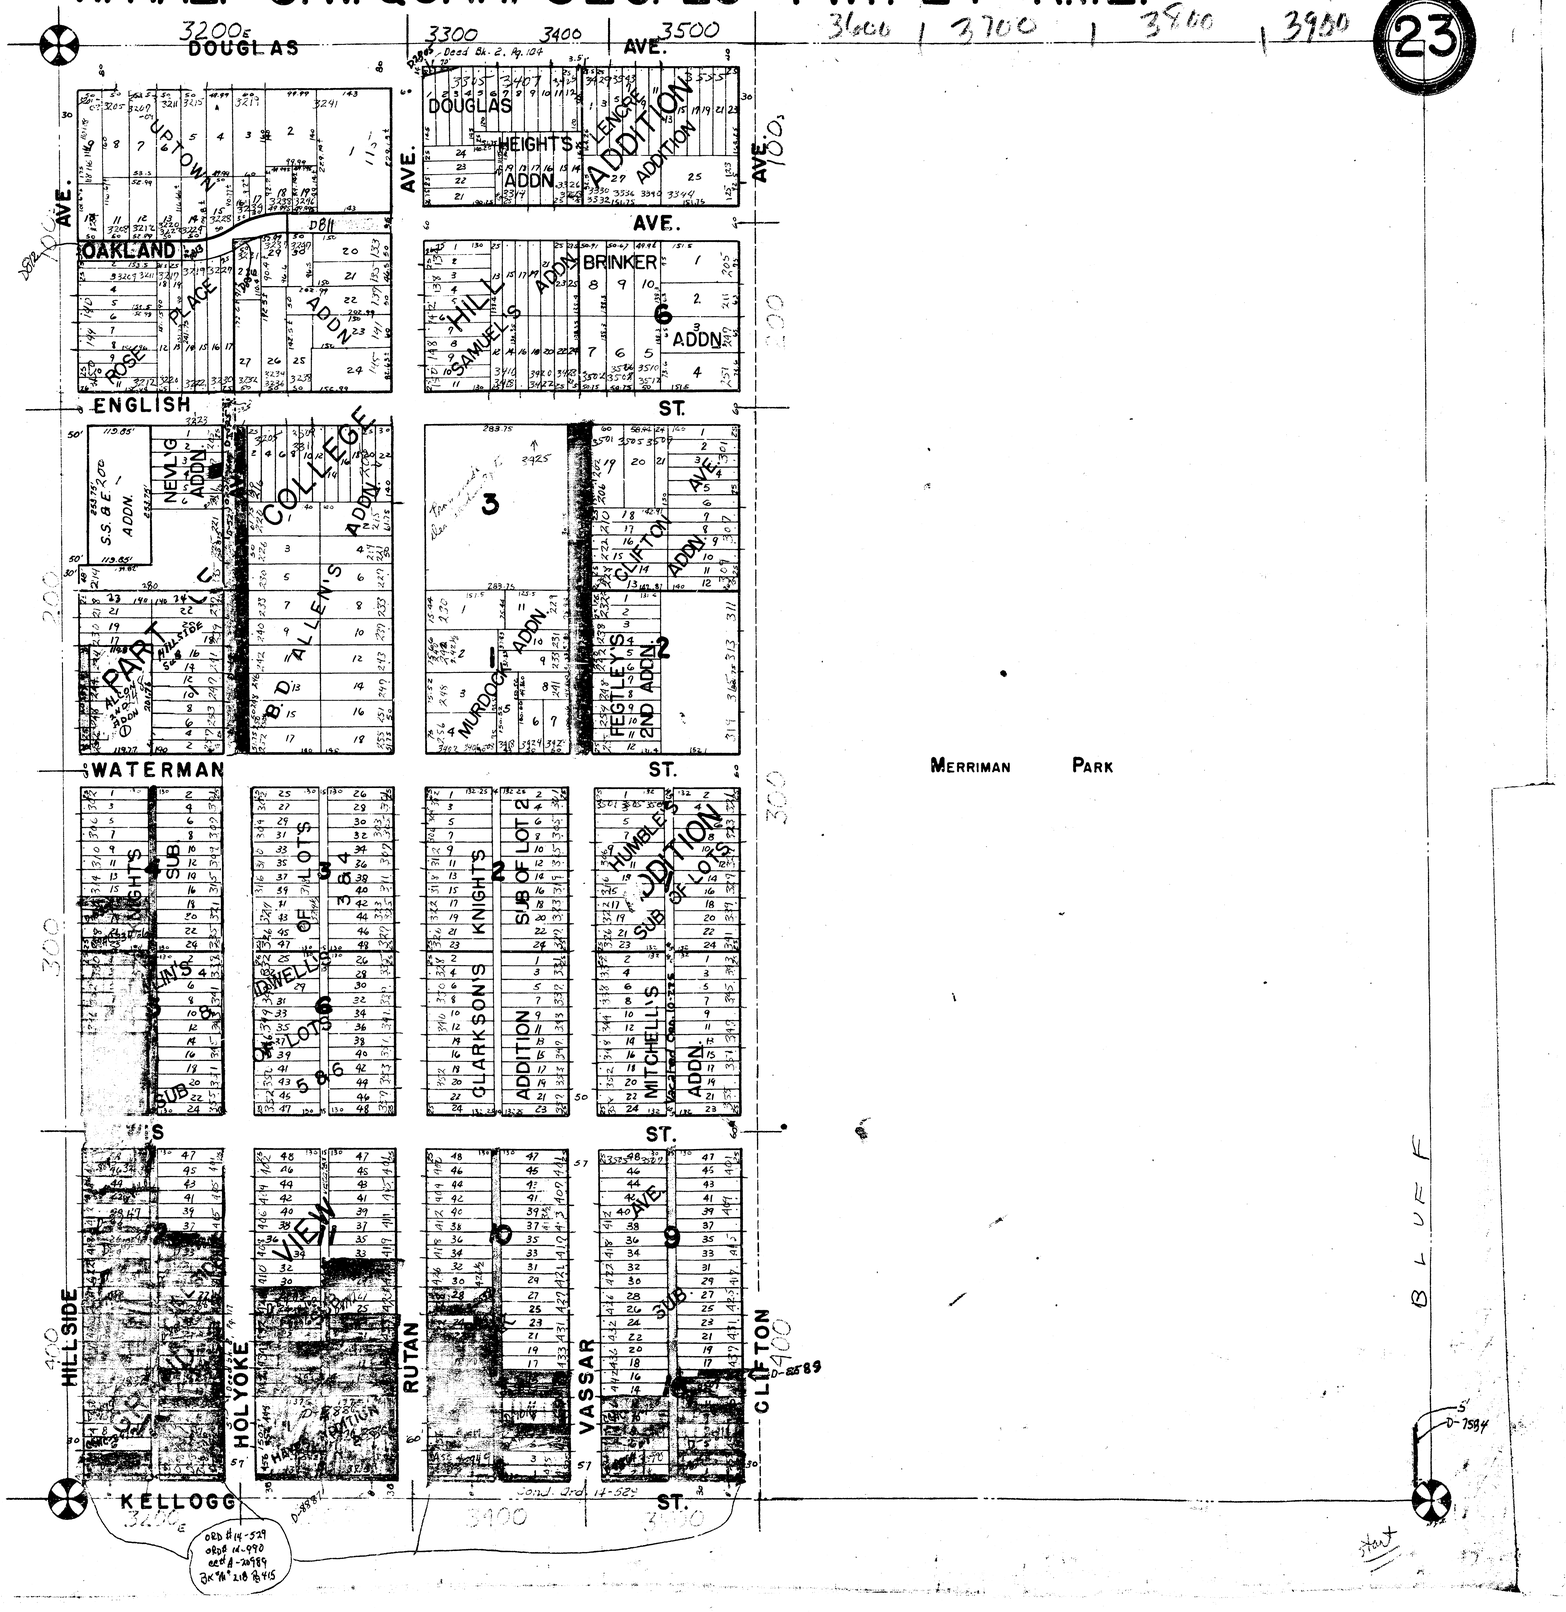
23