


10-62-436

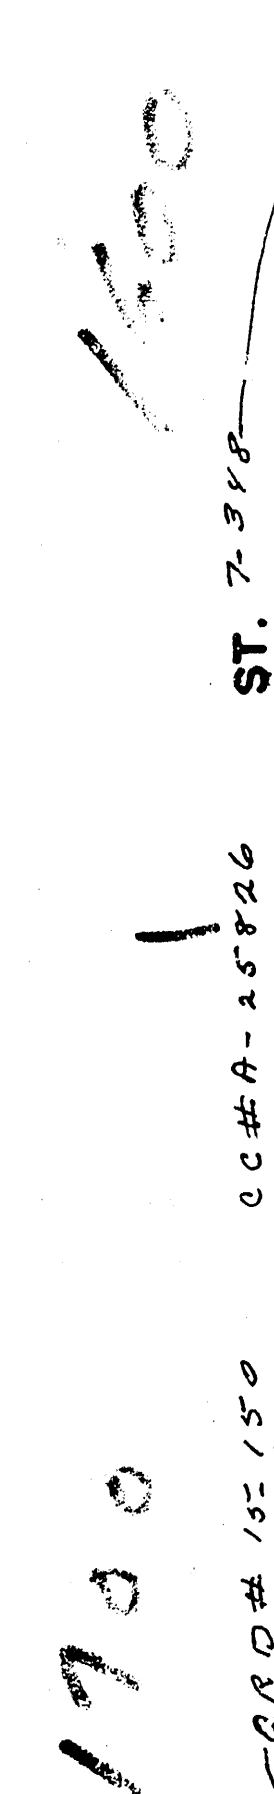

2700 1 4500 1 2000 300 3/10