


S.E. 1/4 SEC 20, TWP 27 S, R.1 W.

5-52

5-52

2-0

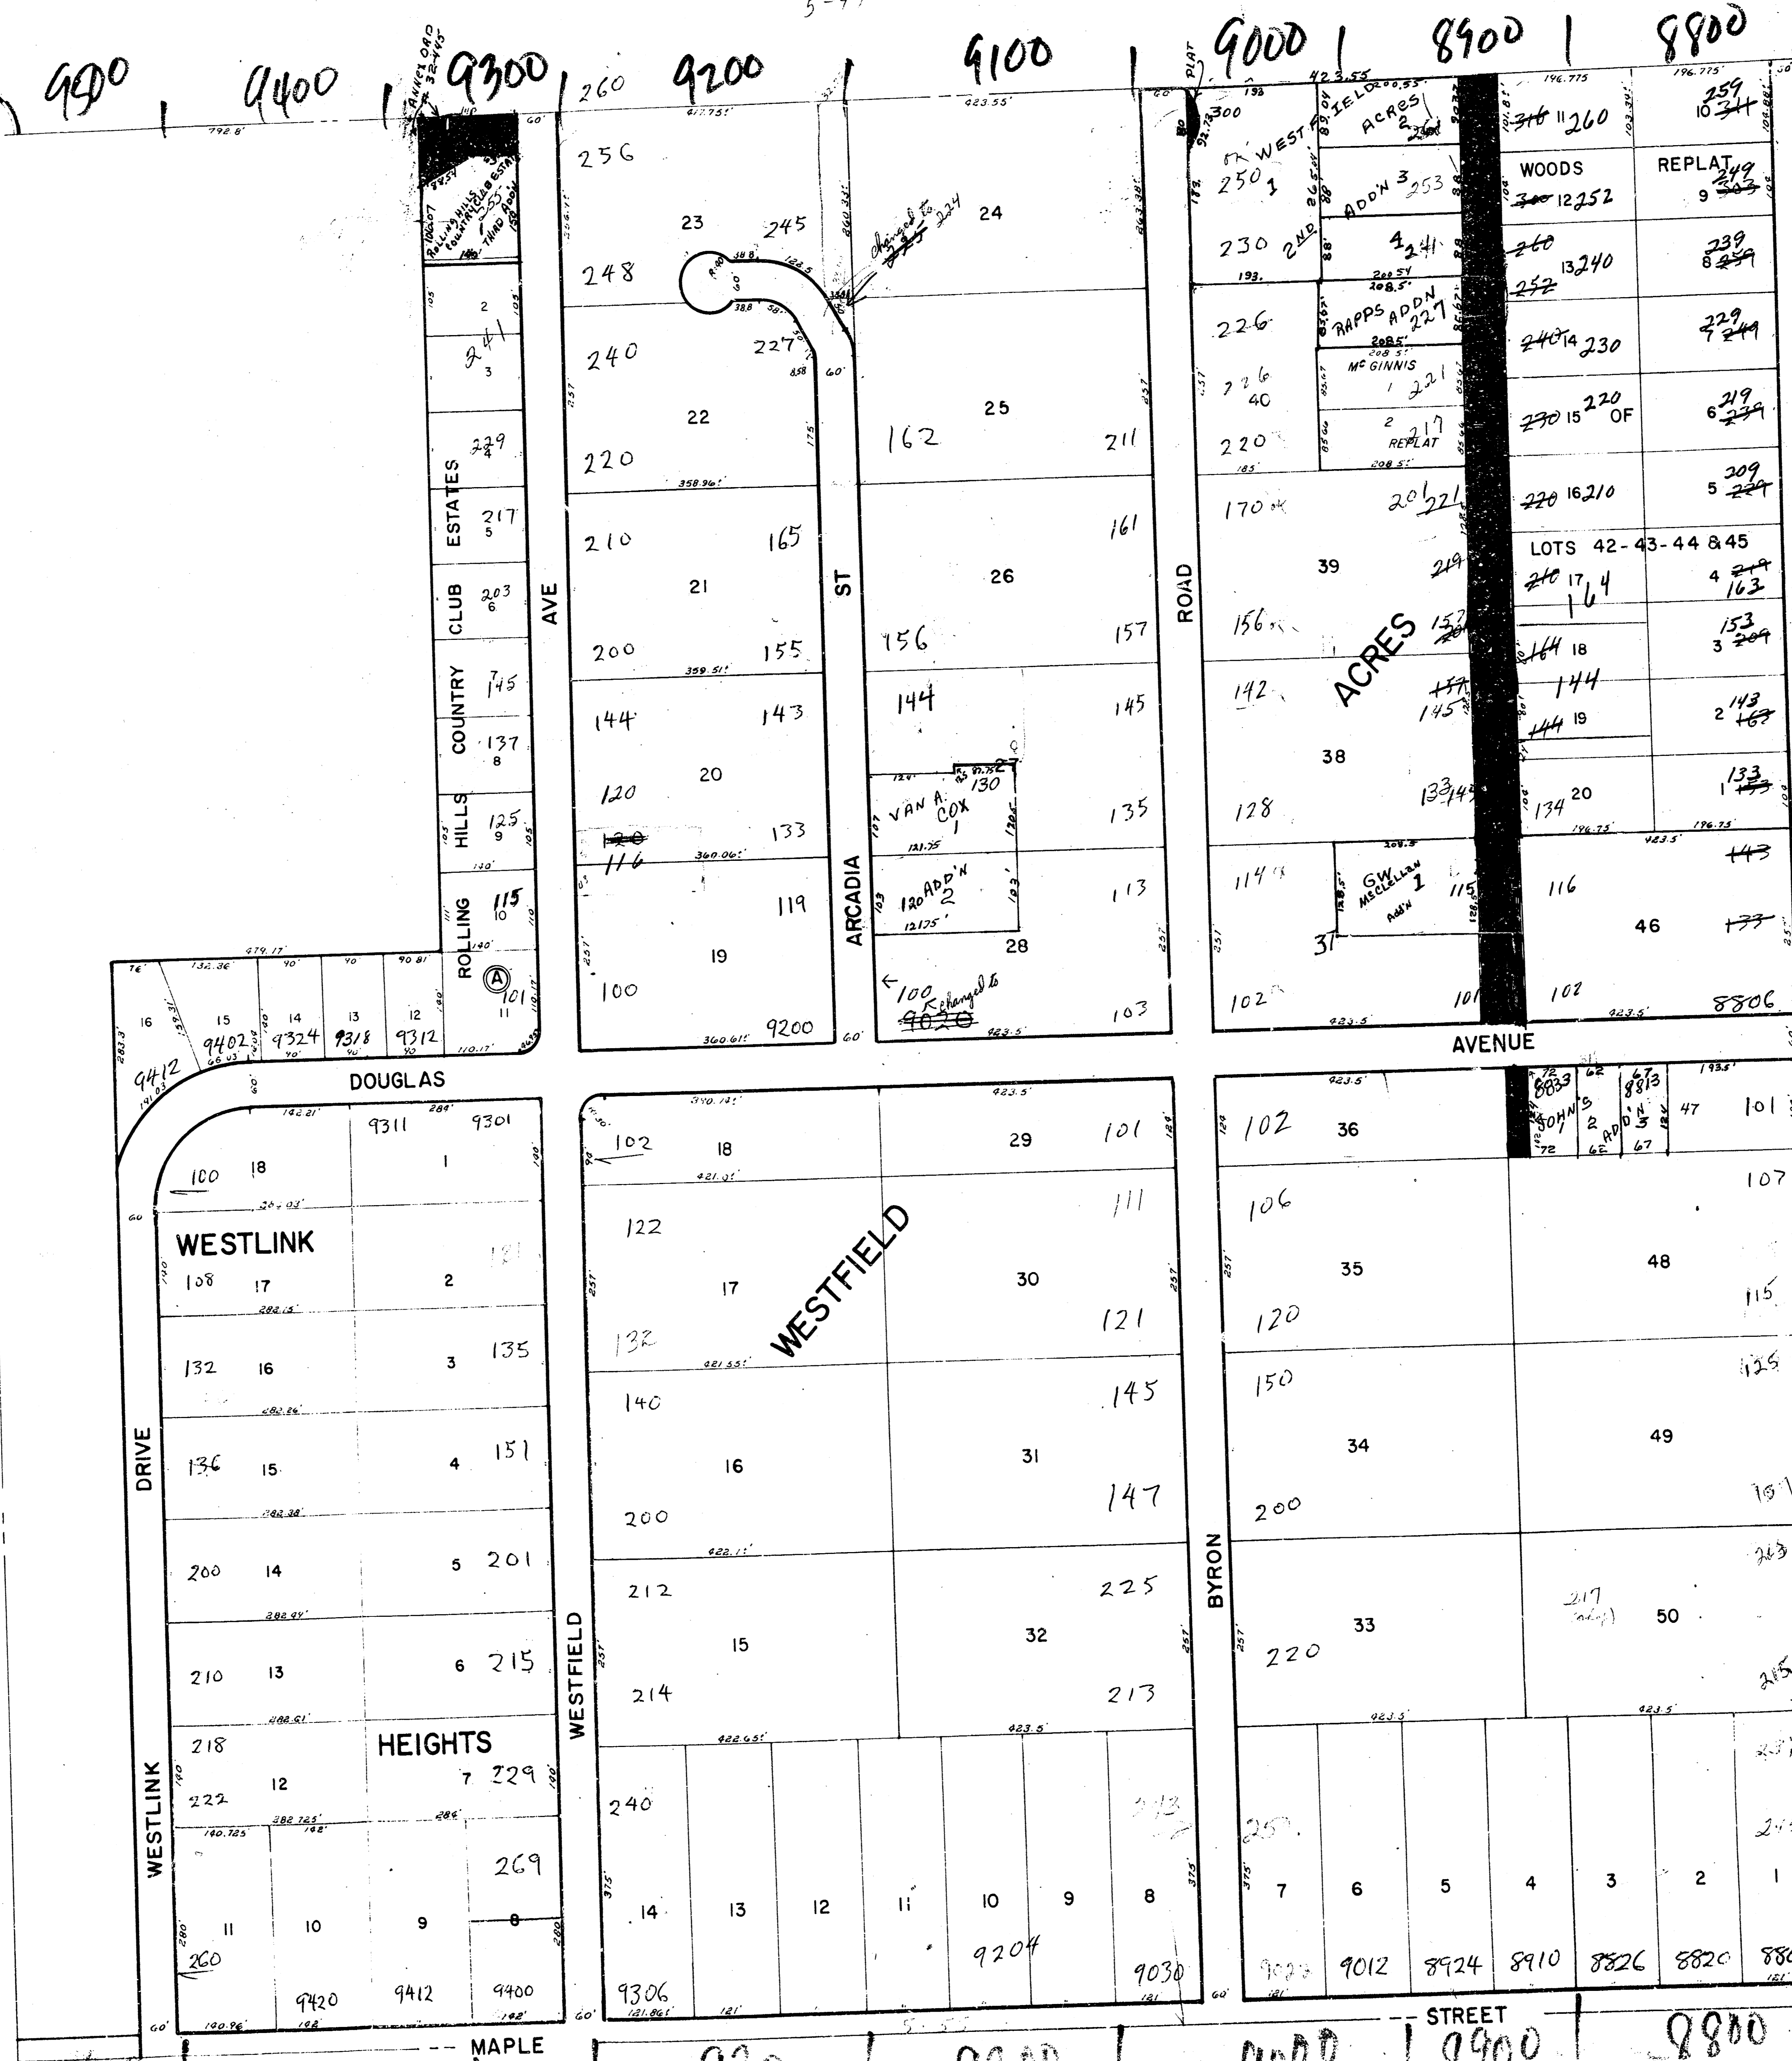


200

100

100

200

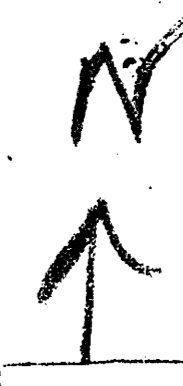

5-49

9400 | 9400 | 9300 | 9200 | 9100 | 9000 | 8900 | 8800

STREET

2