


N.W. 1/4 SEC. 5 TWP 27-S R.I.E.

8-33

See County

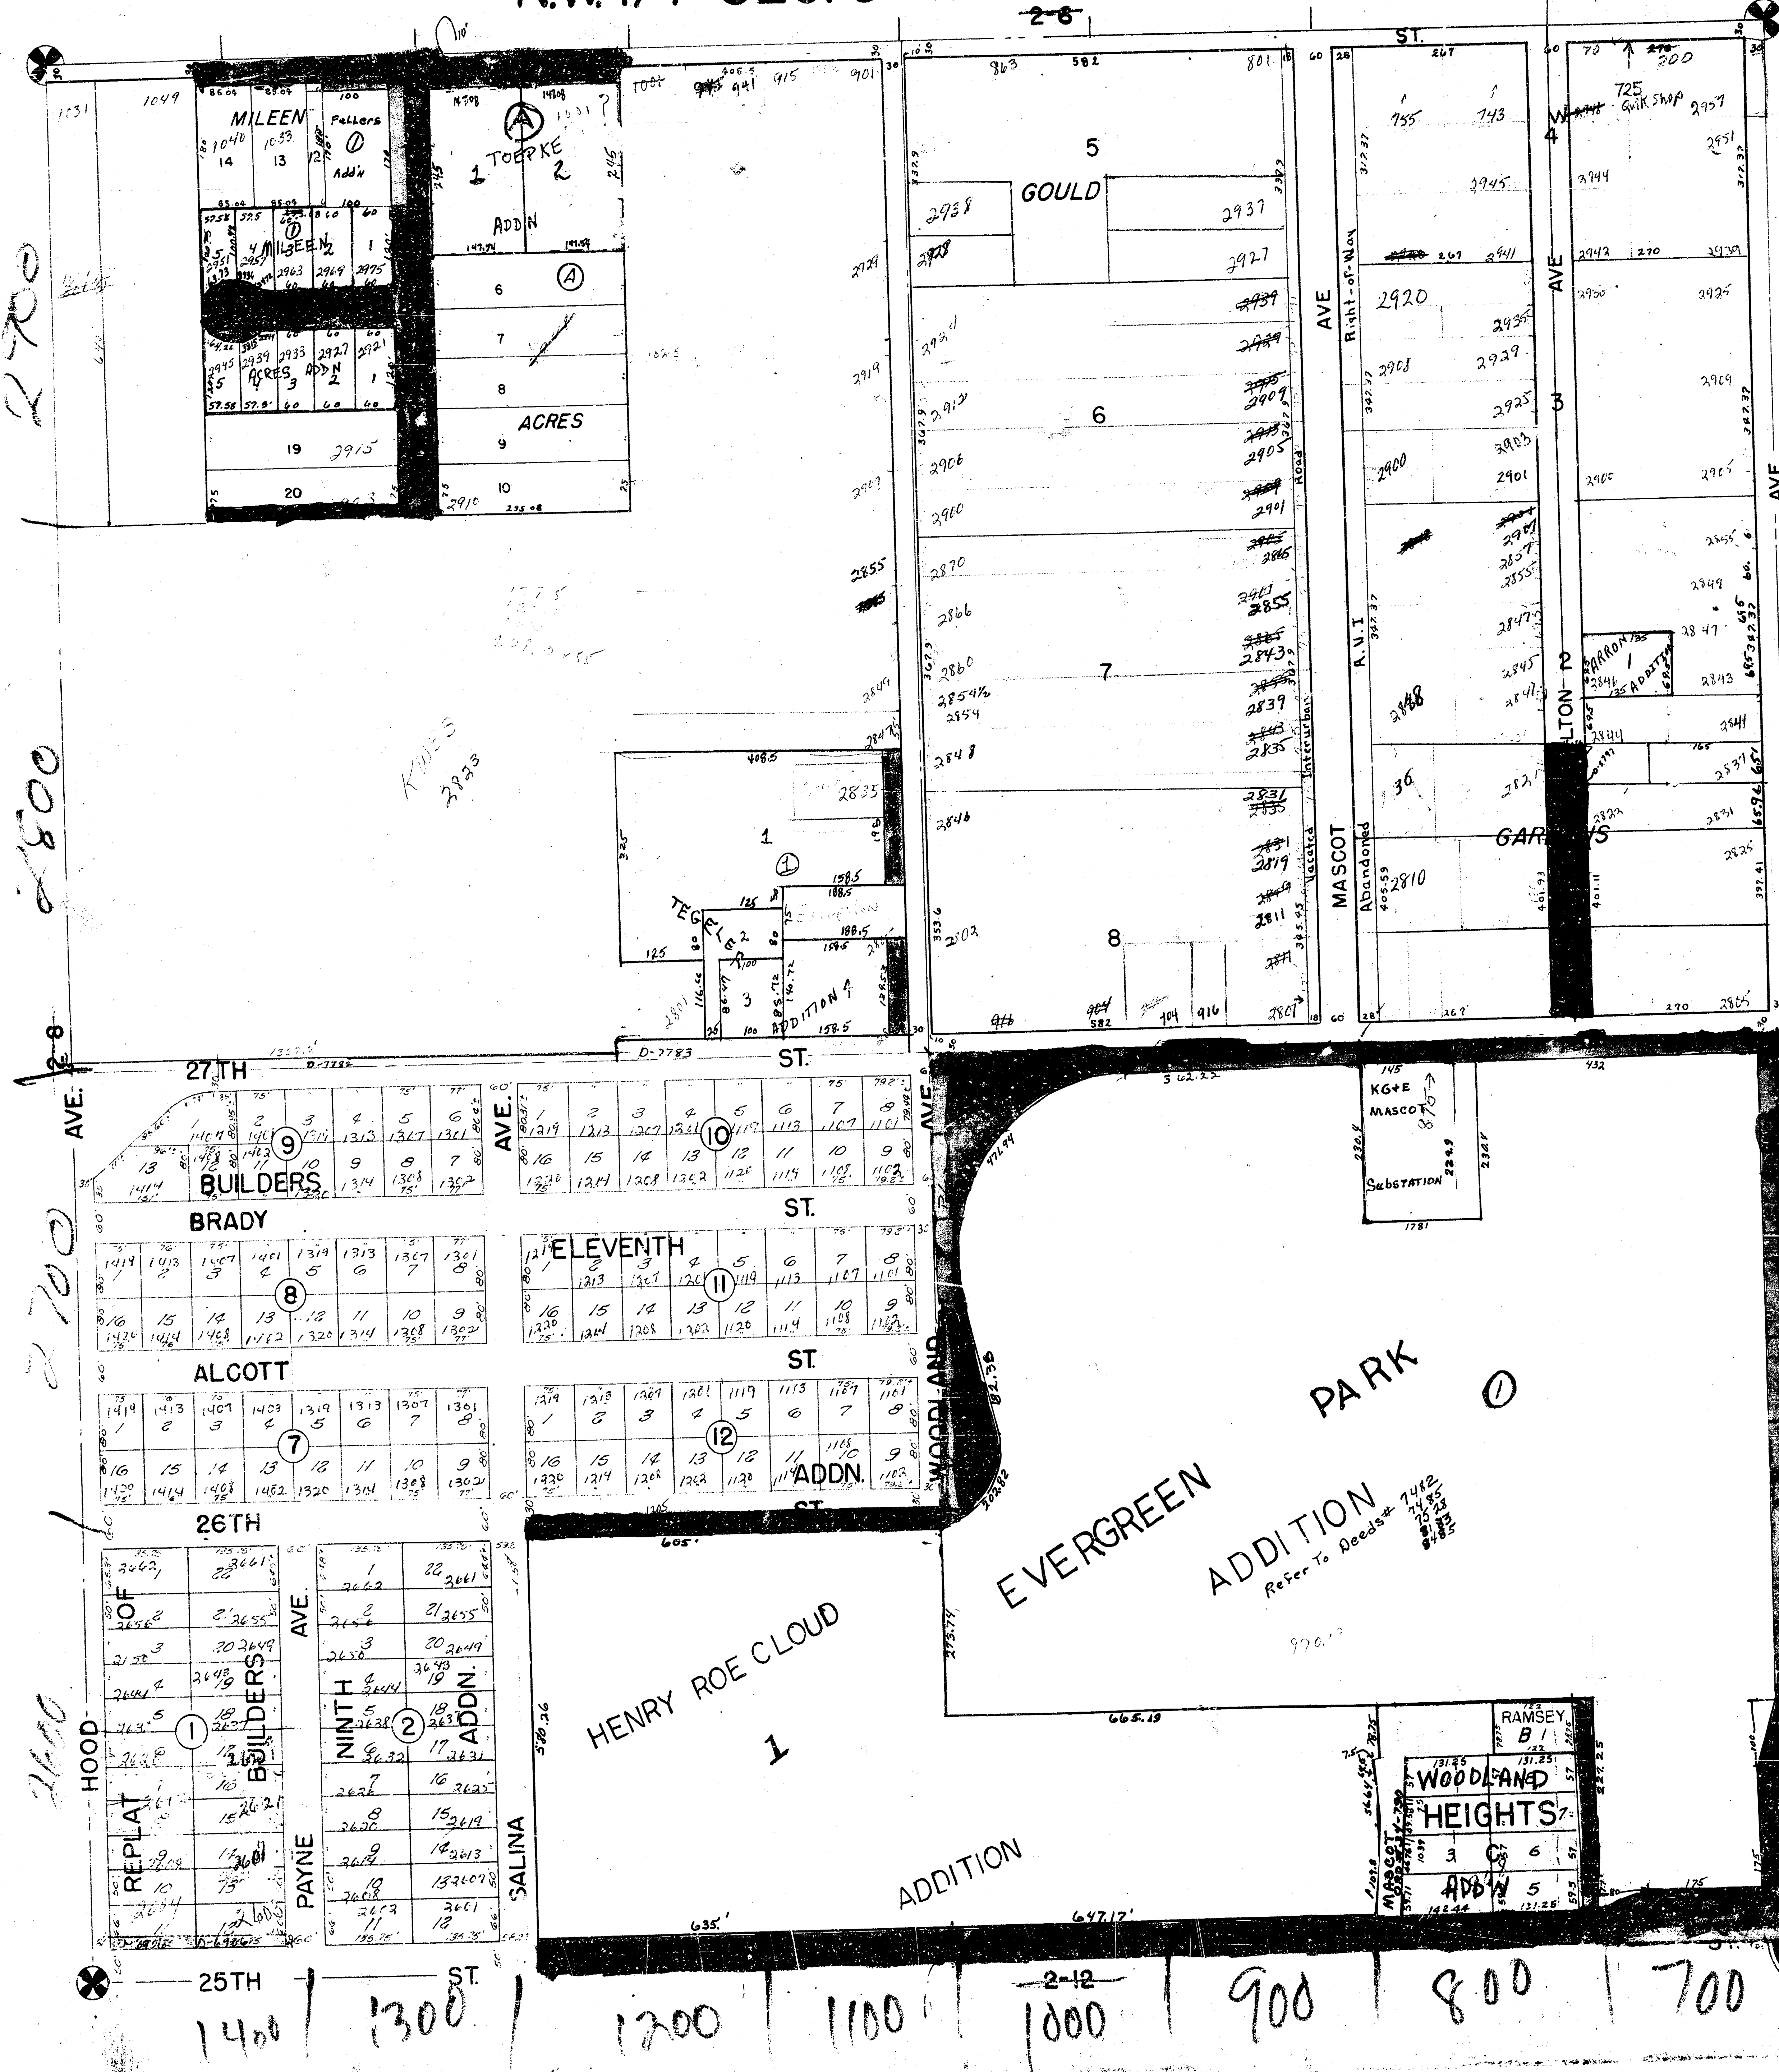

2700

2800

2900

3000

1400 1300 1200 1100 1000 900 800 700