


S.E. 1/4 SEC. 6 TWP. 27S. R.1E.

8-35

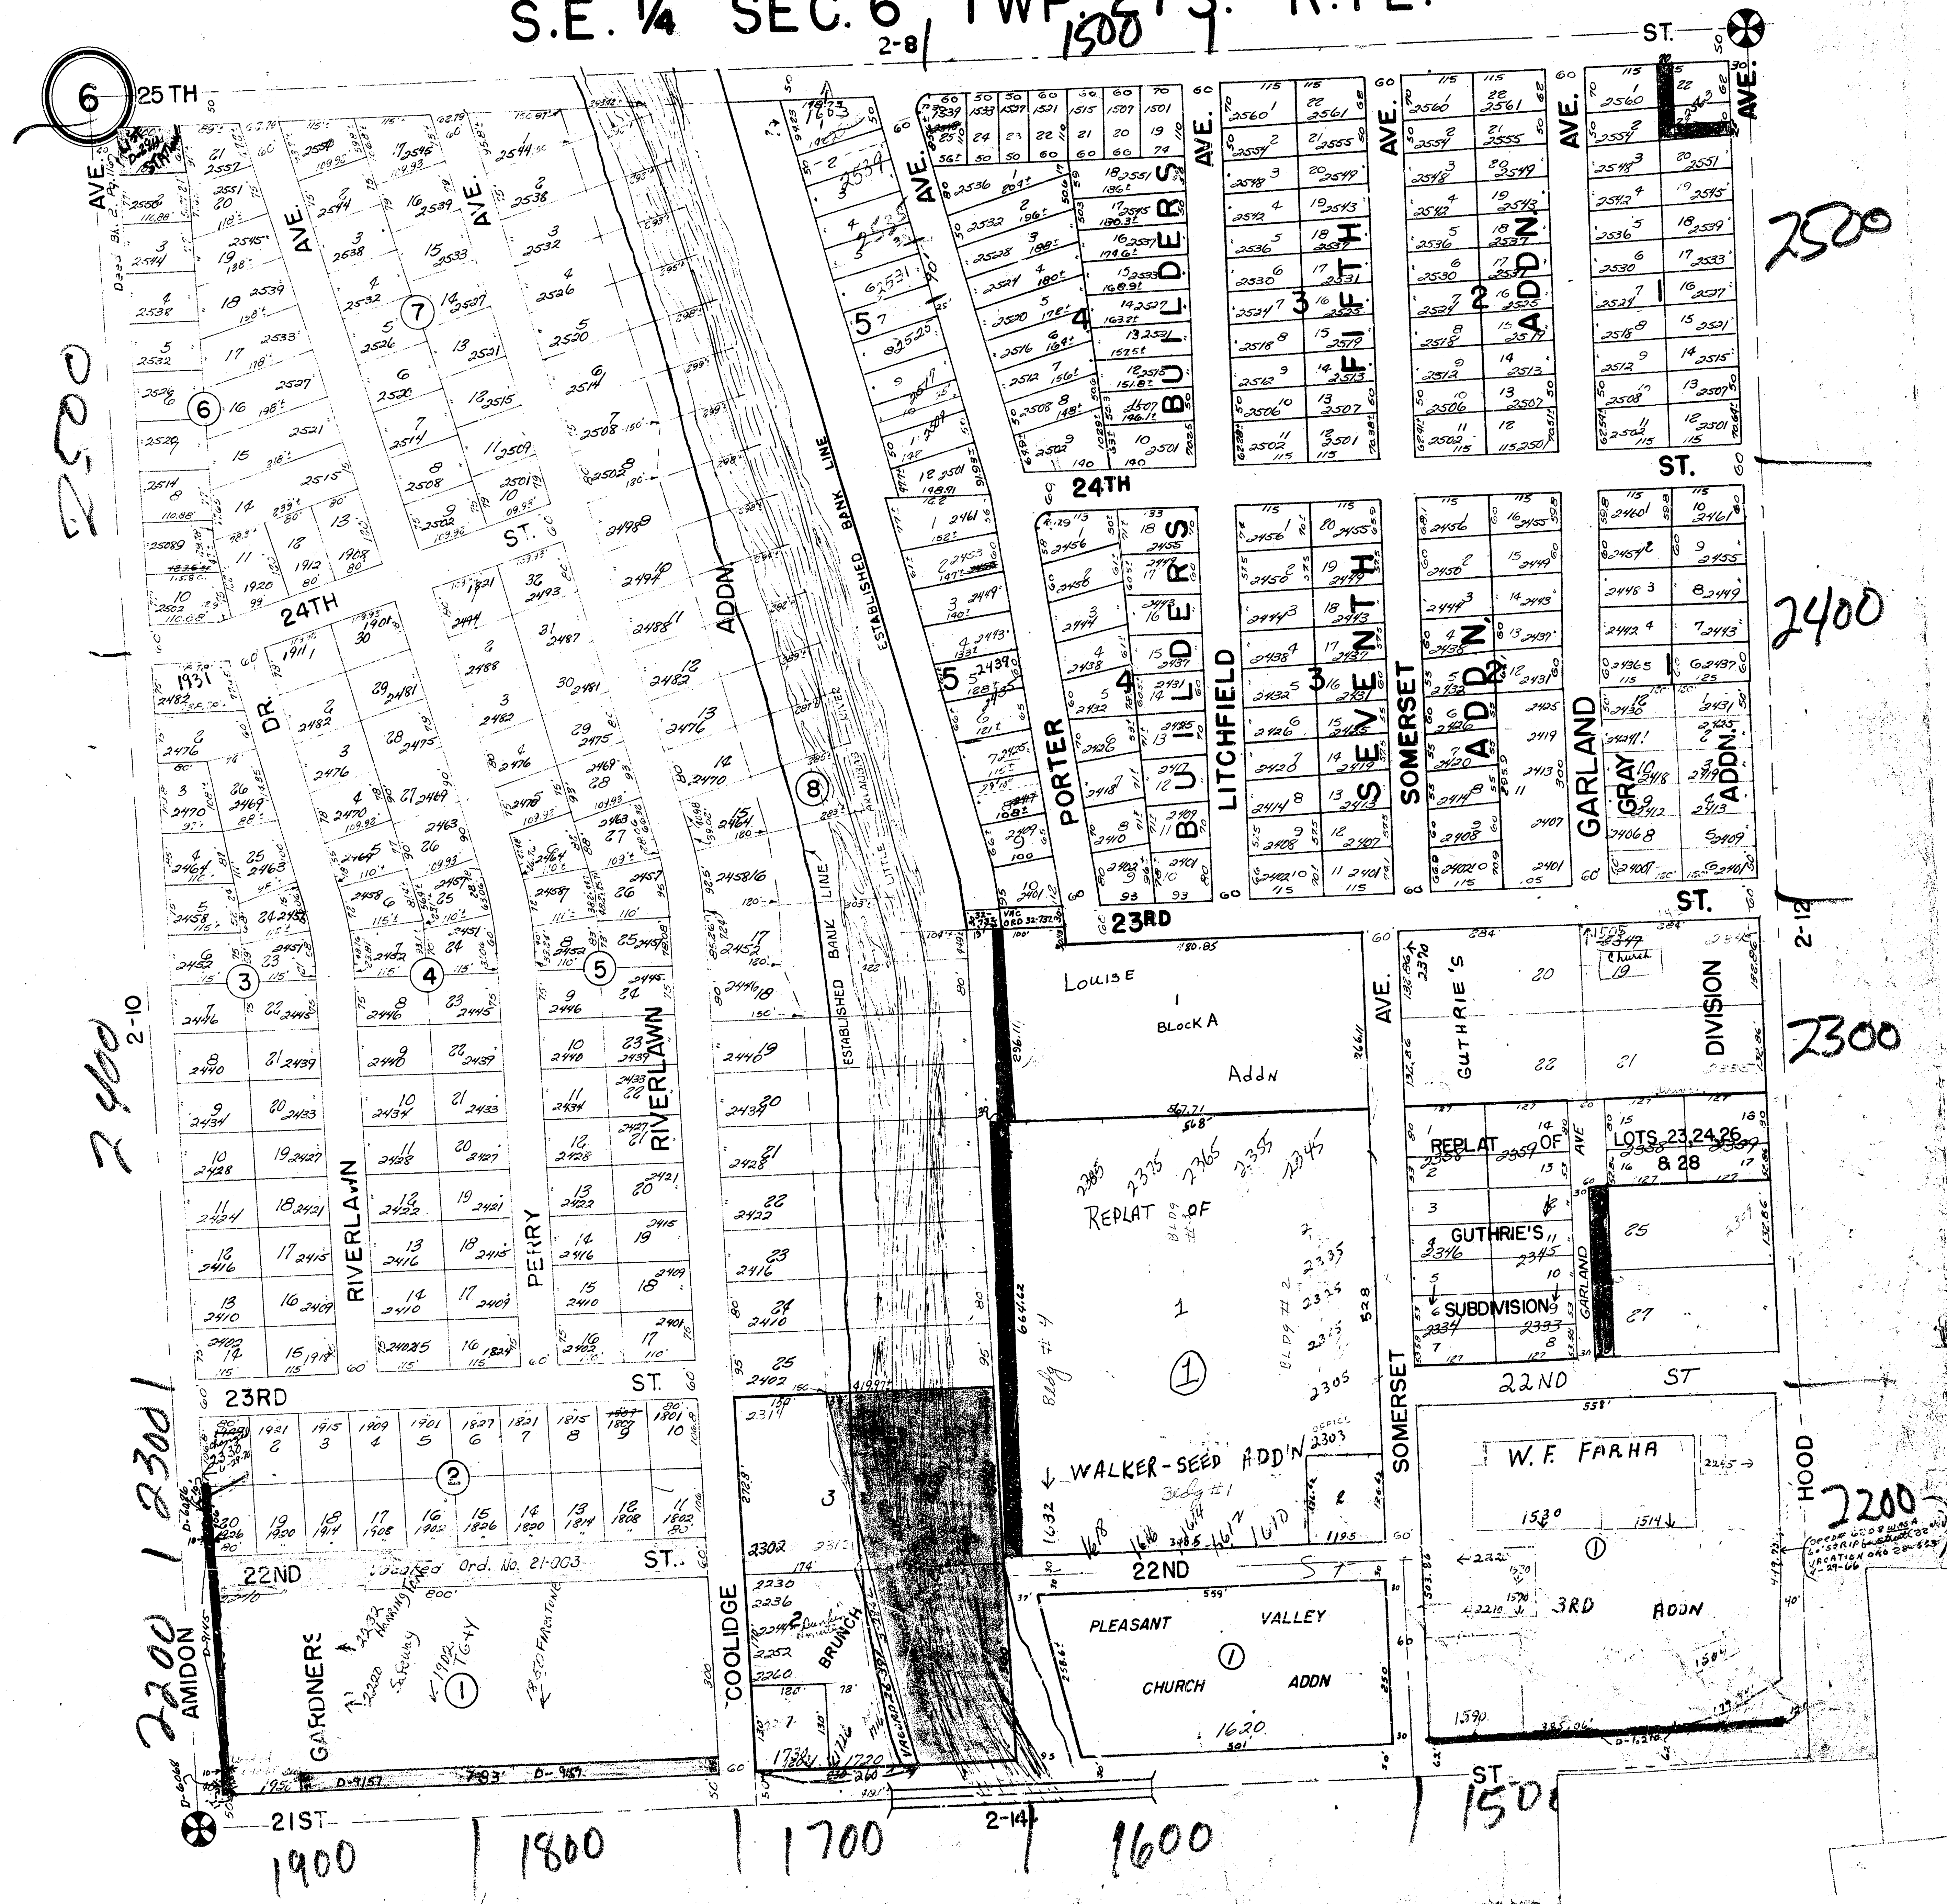

2500

2500

2400

2300

2200

2200 1 2300 1

1900

1800

1700

2-14

1600

1500