


NW 1/4 SEC. 20 TWP. 27 S. R. 1 E.

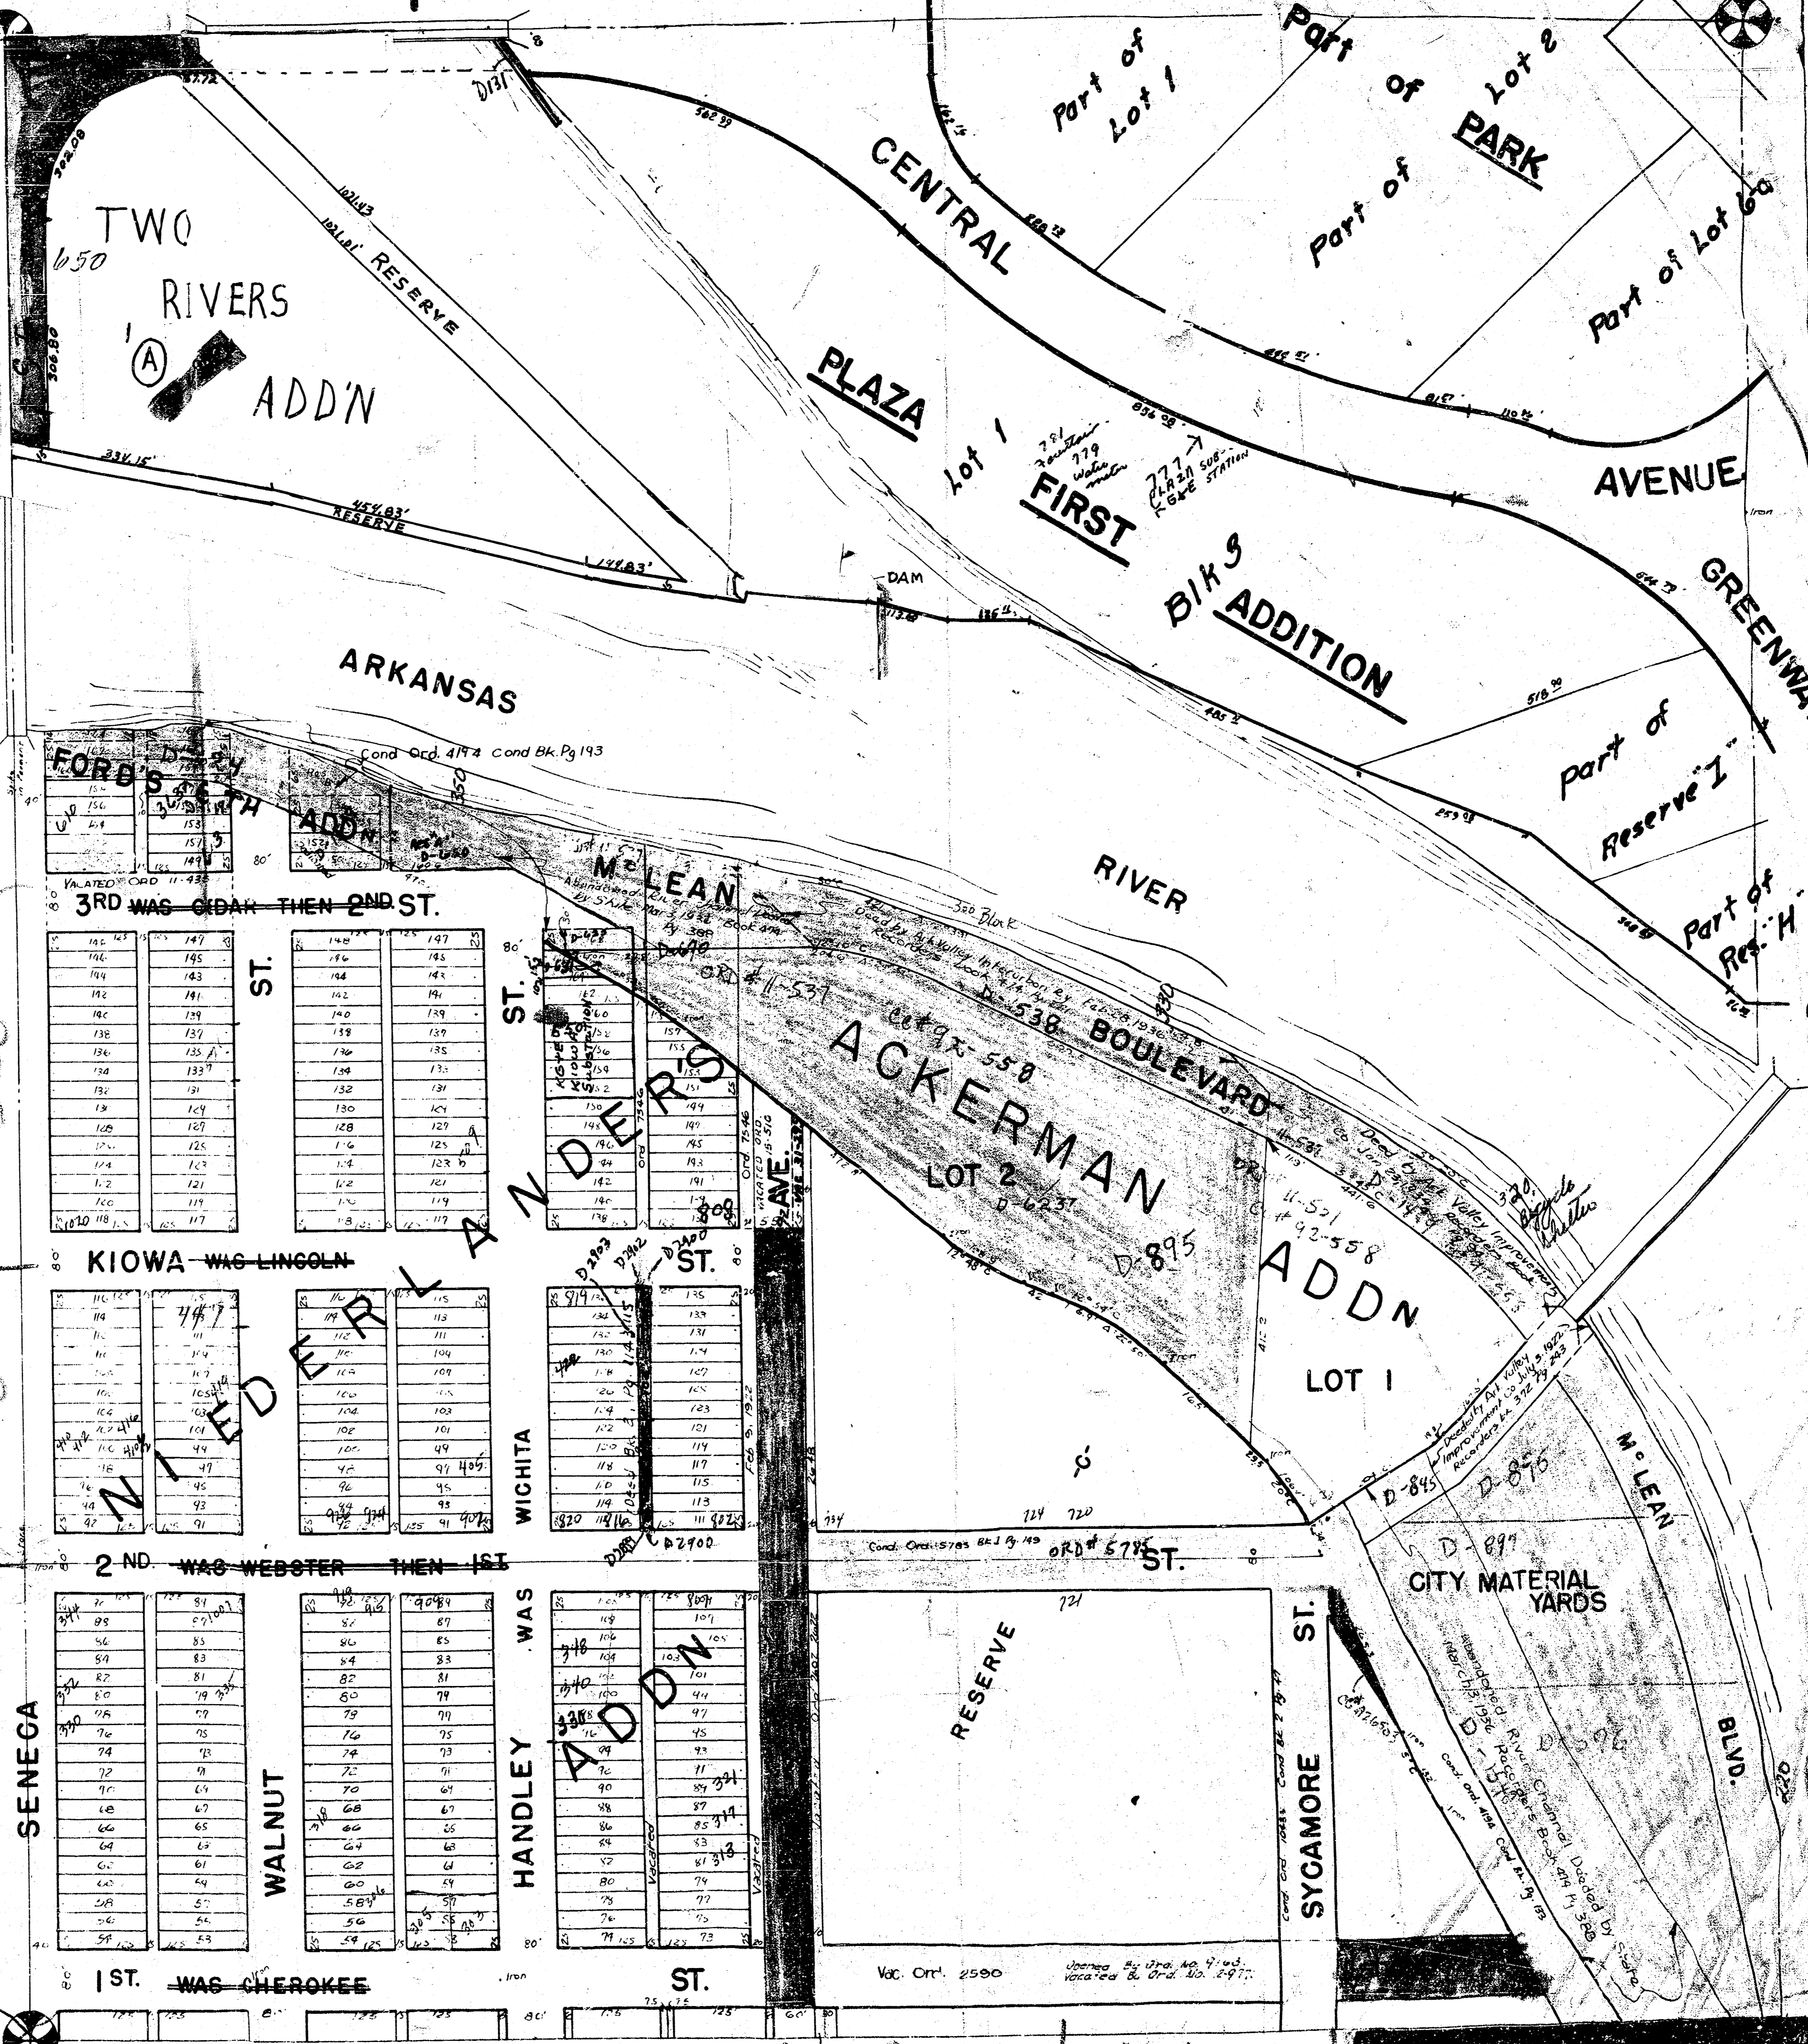

TWO RIVERS
ADDN

FORD'S
ADDN
3RD WAS CEDAR THEN 2ND ST.


KIOWA WAS LINCOLN


2ND WAS WEBSTER THEN 1ST


1ST WAS CHEROKEE ST.


SENEGA

WALNUT

HANDLEY WAS

SYCAMORE ST.

ACKERMAN
LOT 2
LOT 1

CITY MATERIAL YARDS

CENTRAL PLAZA

BIK'S ADDITION

AVENUE

GREENWAY

ARKANSAS RIVER

McLEAN

Part of Reserve 'I'

Part of Res. 'H'

Part of Lot 1

Part of Lot 2

Part of Lot 6a

lot 1

FIRST

























































































































































































































