


N.W. 1/4 SEC. 8 TWP. 28 S. R1E.

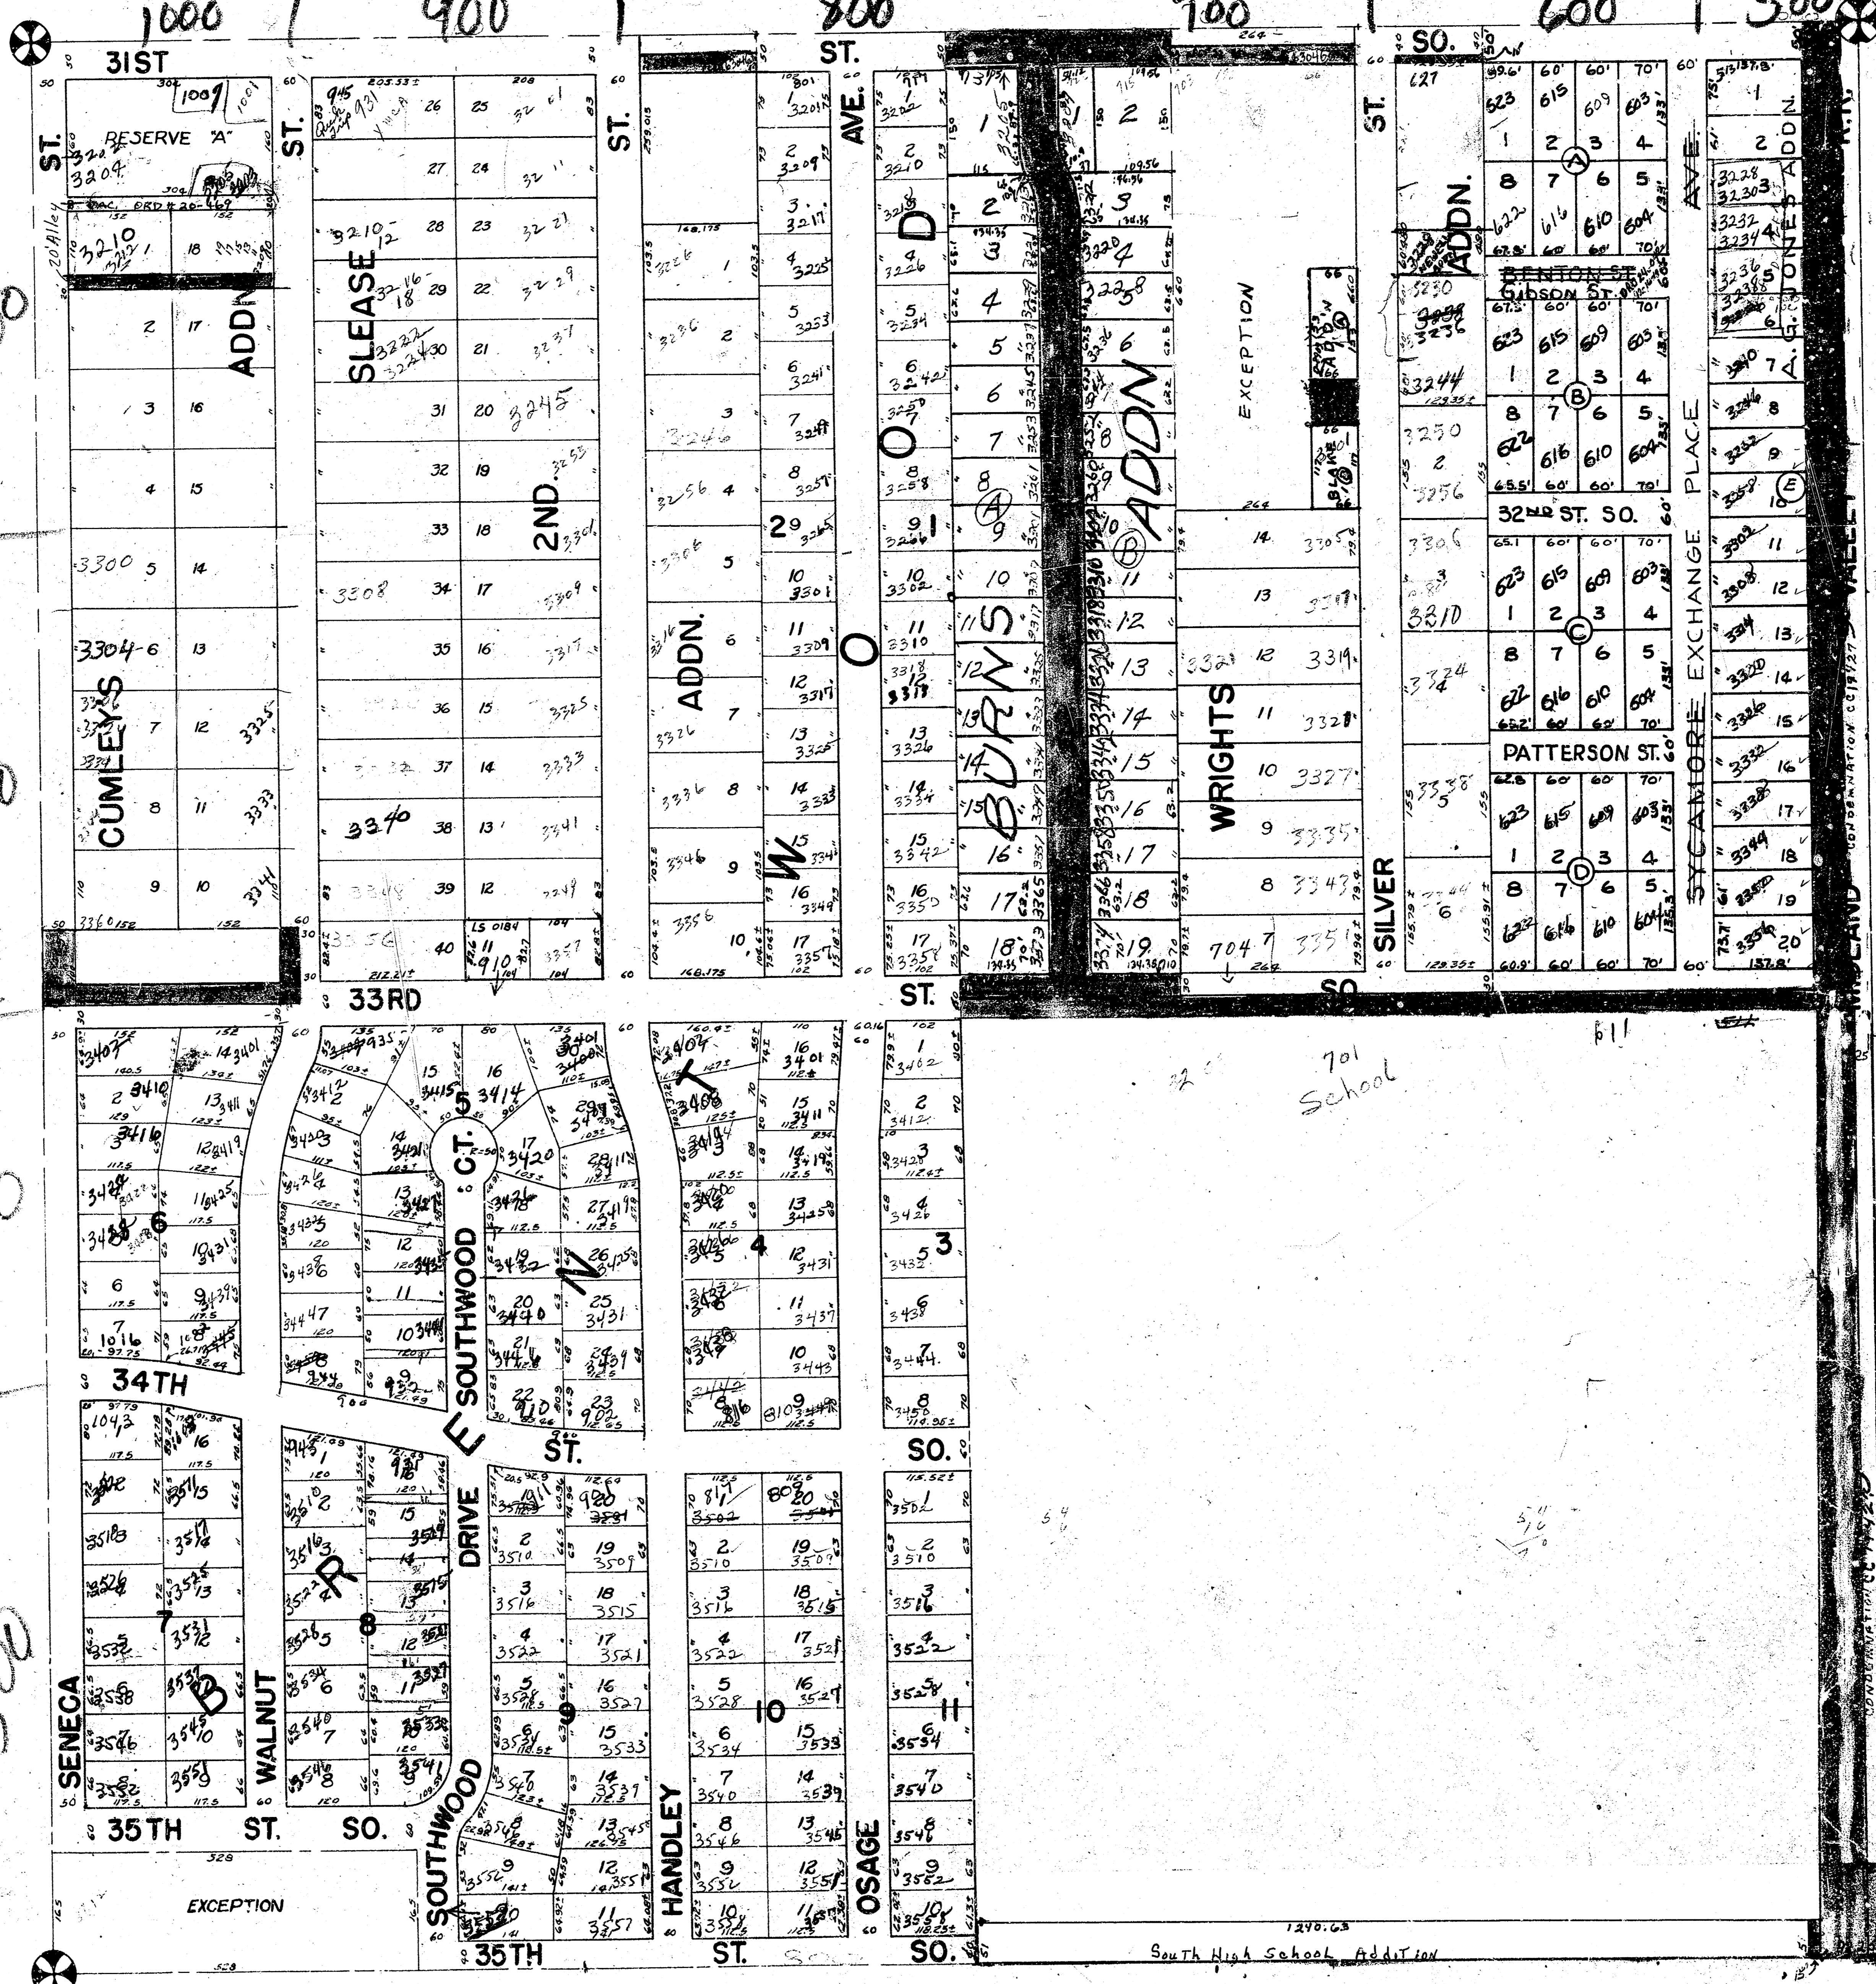

3200

3300

3400

3500

701 School

South High School Addition

8-75

See 15 of plat stand in north east of this plat

Mid-Valley R.R. crossing agreement in 1/2 sec. file