


N.W. 1/4 SEC. 33, TWP. 26 S, R. 1 E.

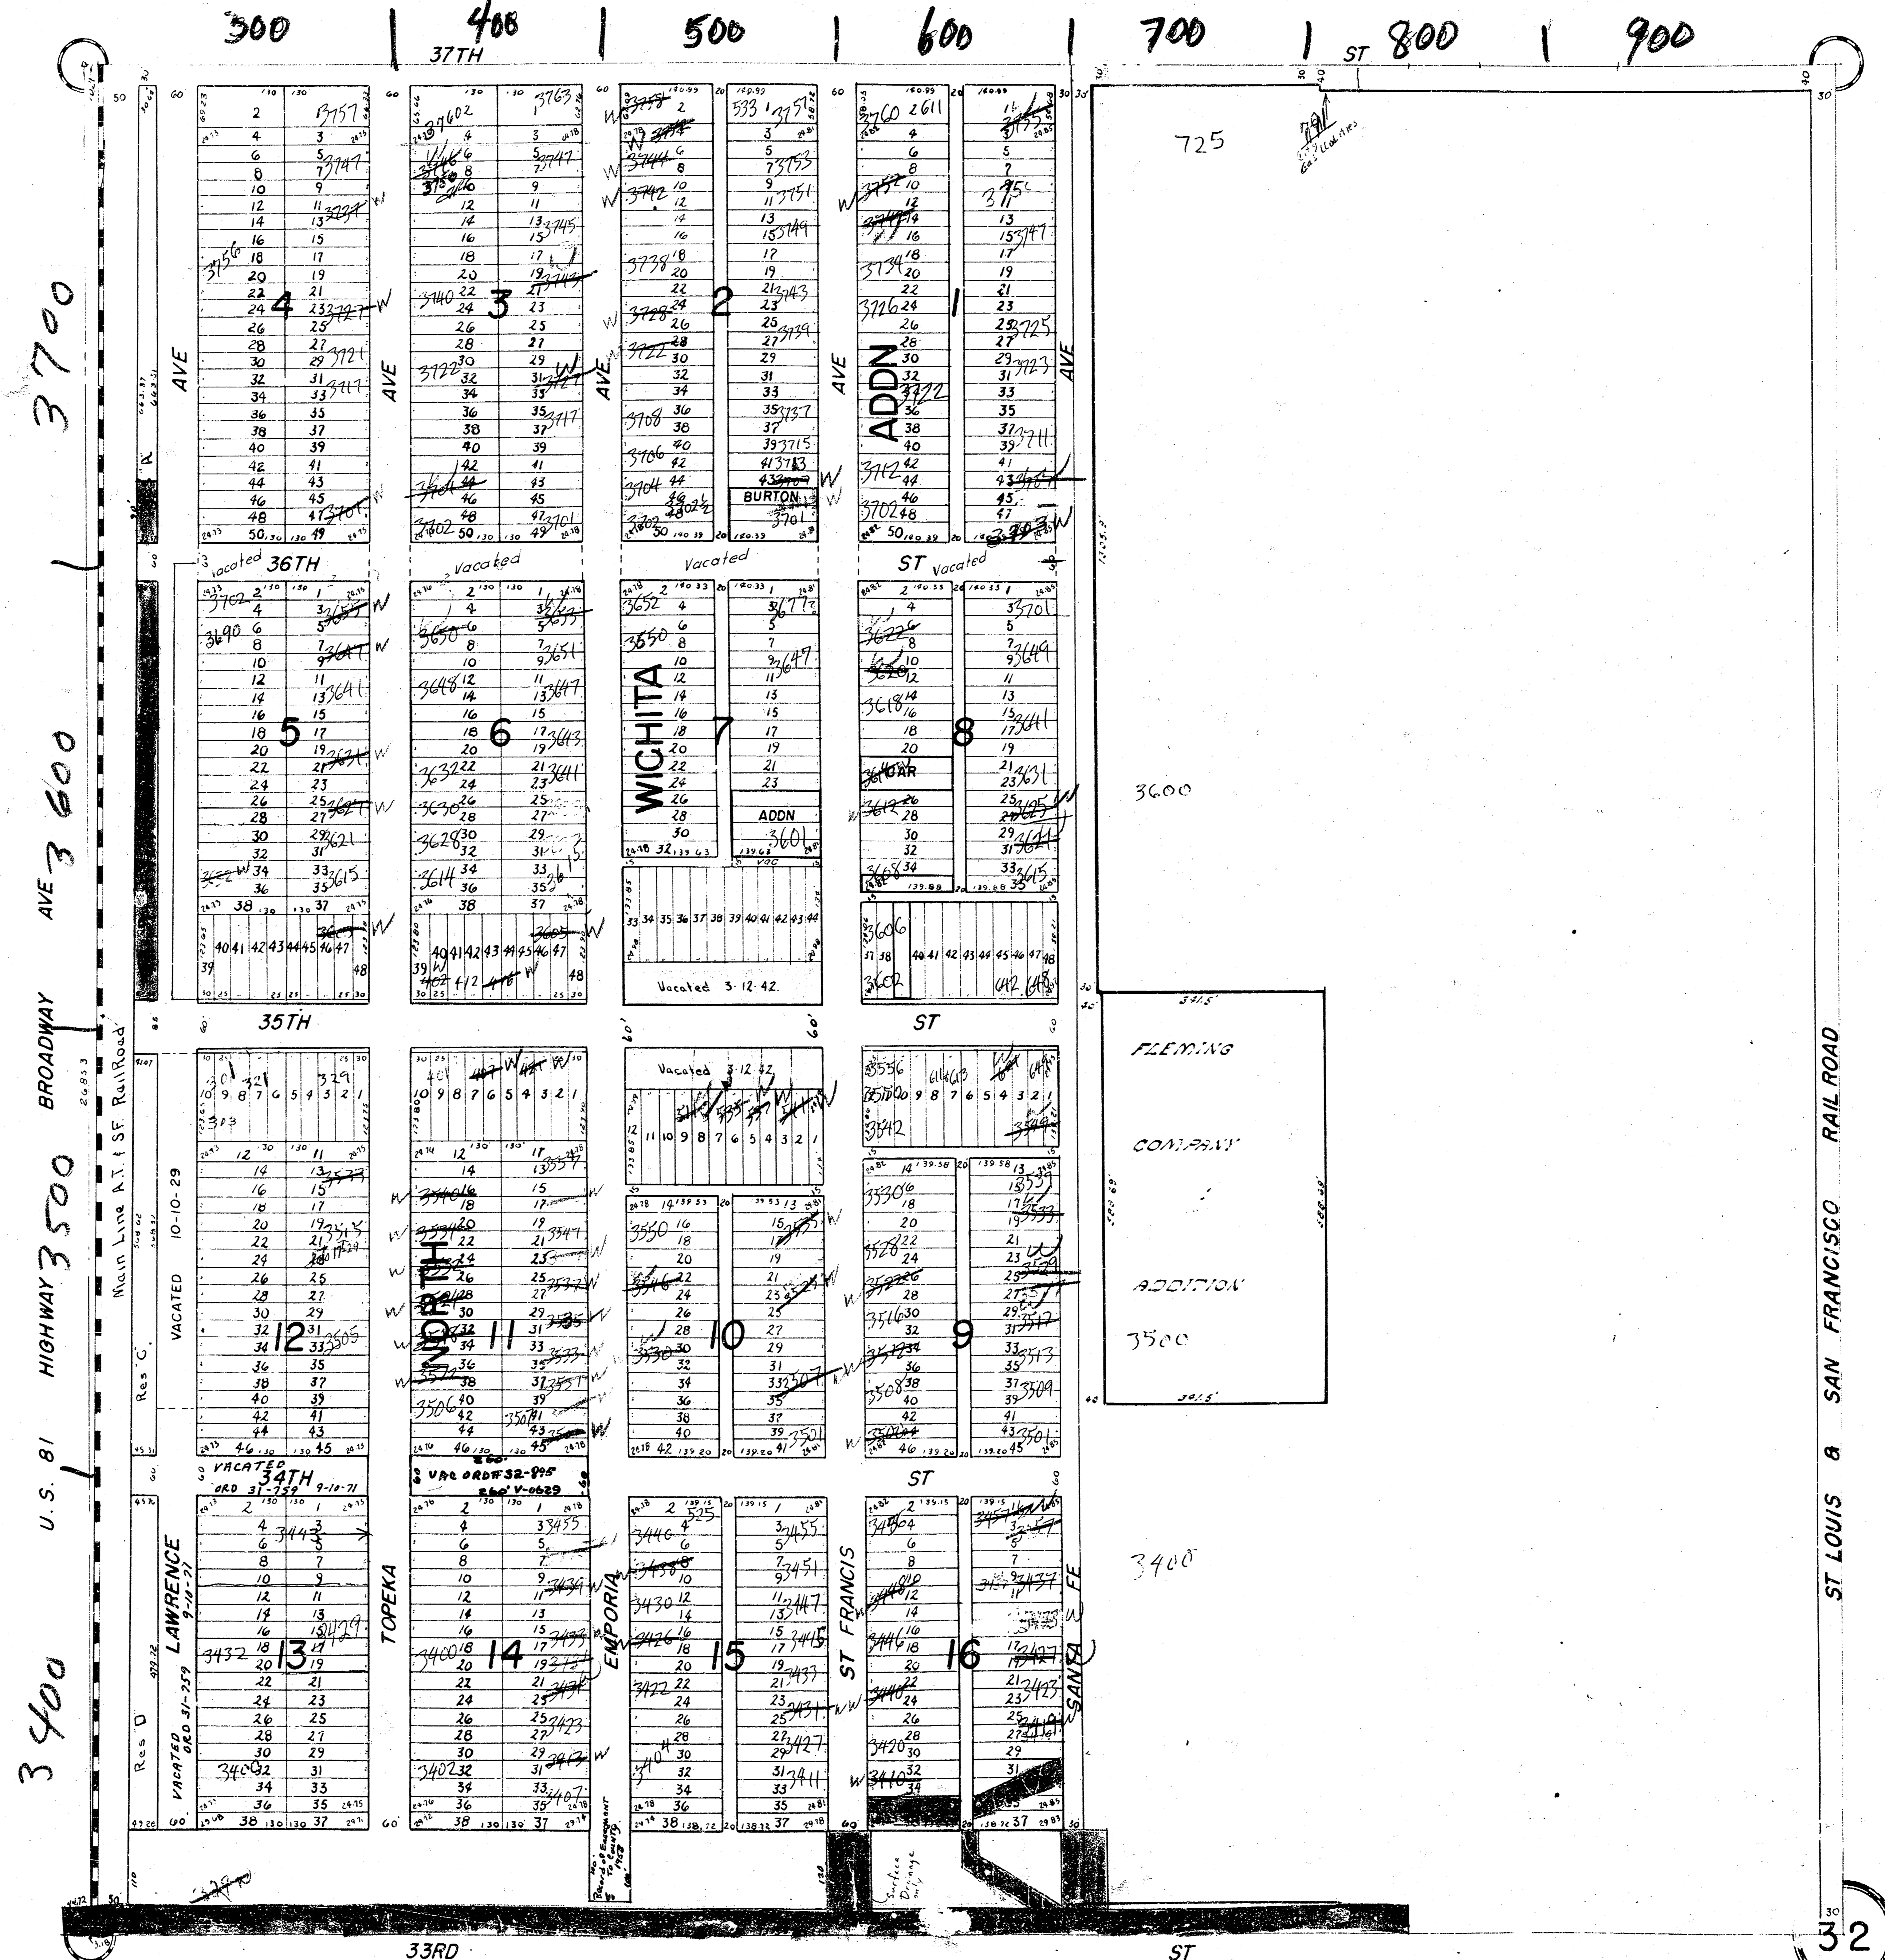

3700
 3600
 3500
 3400

33RD

ST

32