


S. E. 1/4 SEC. 4 T. 27S. R. 1E.

9-36

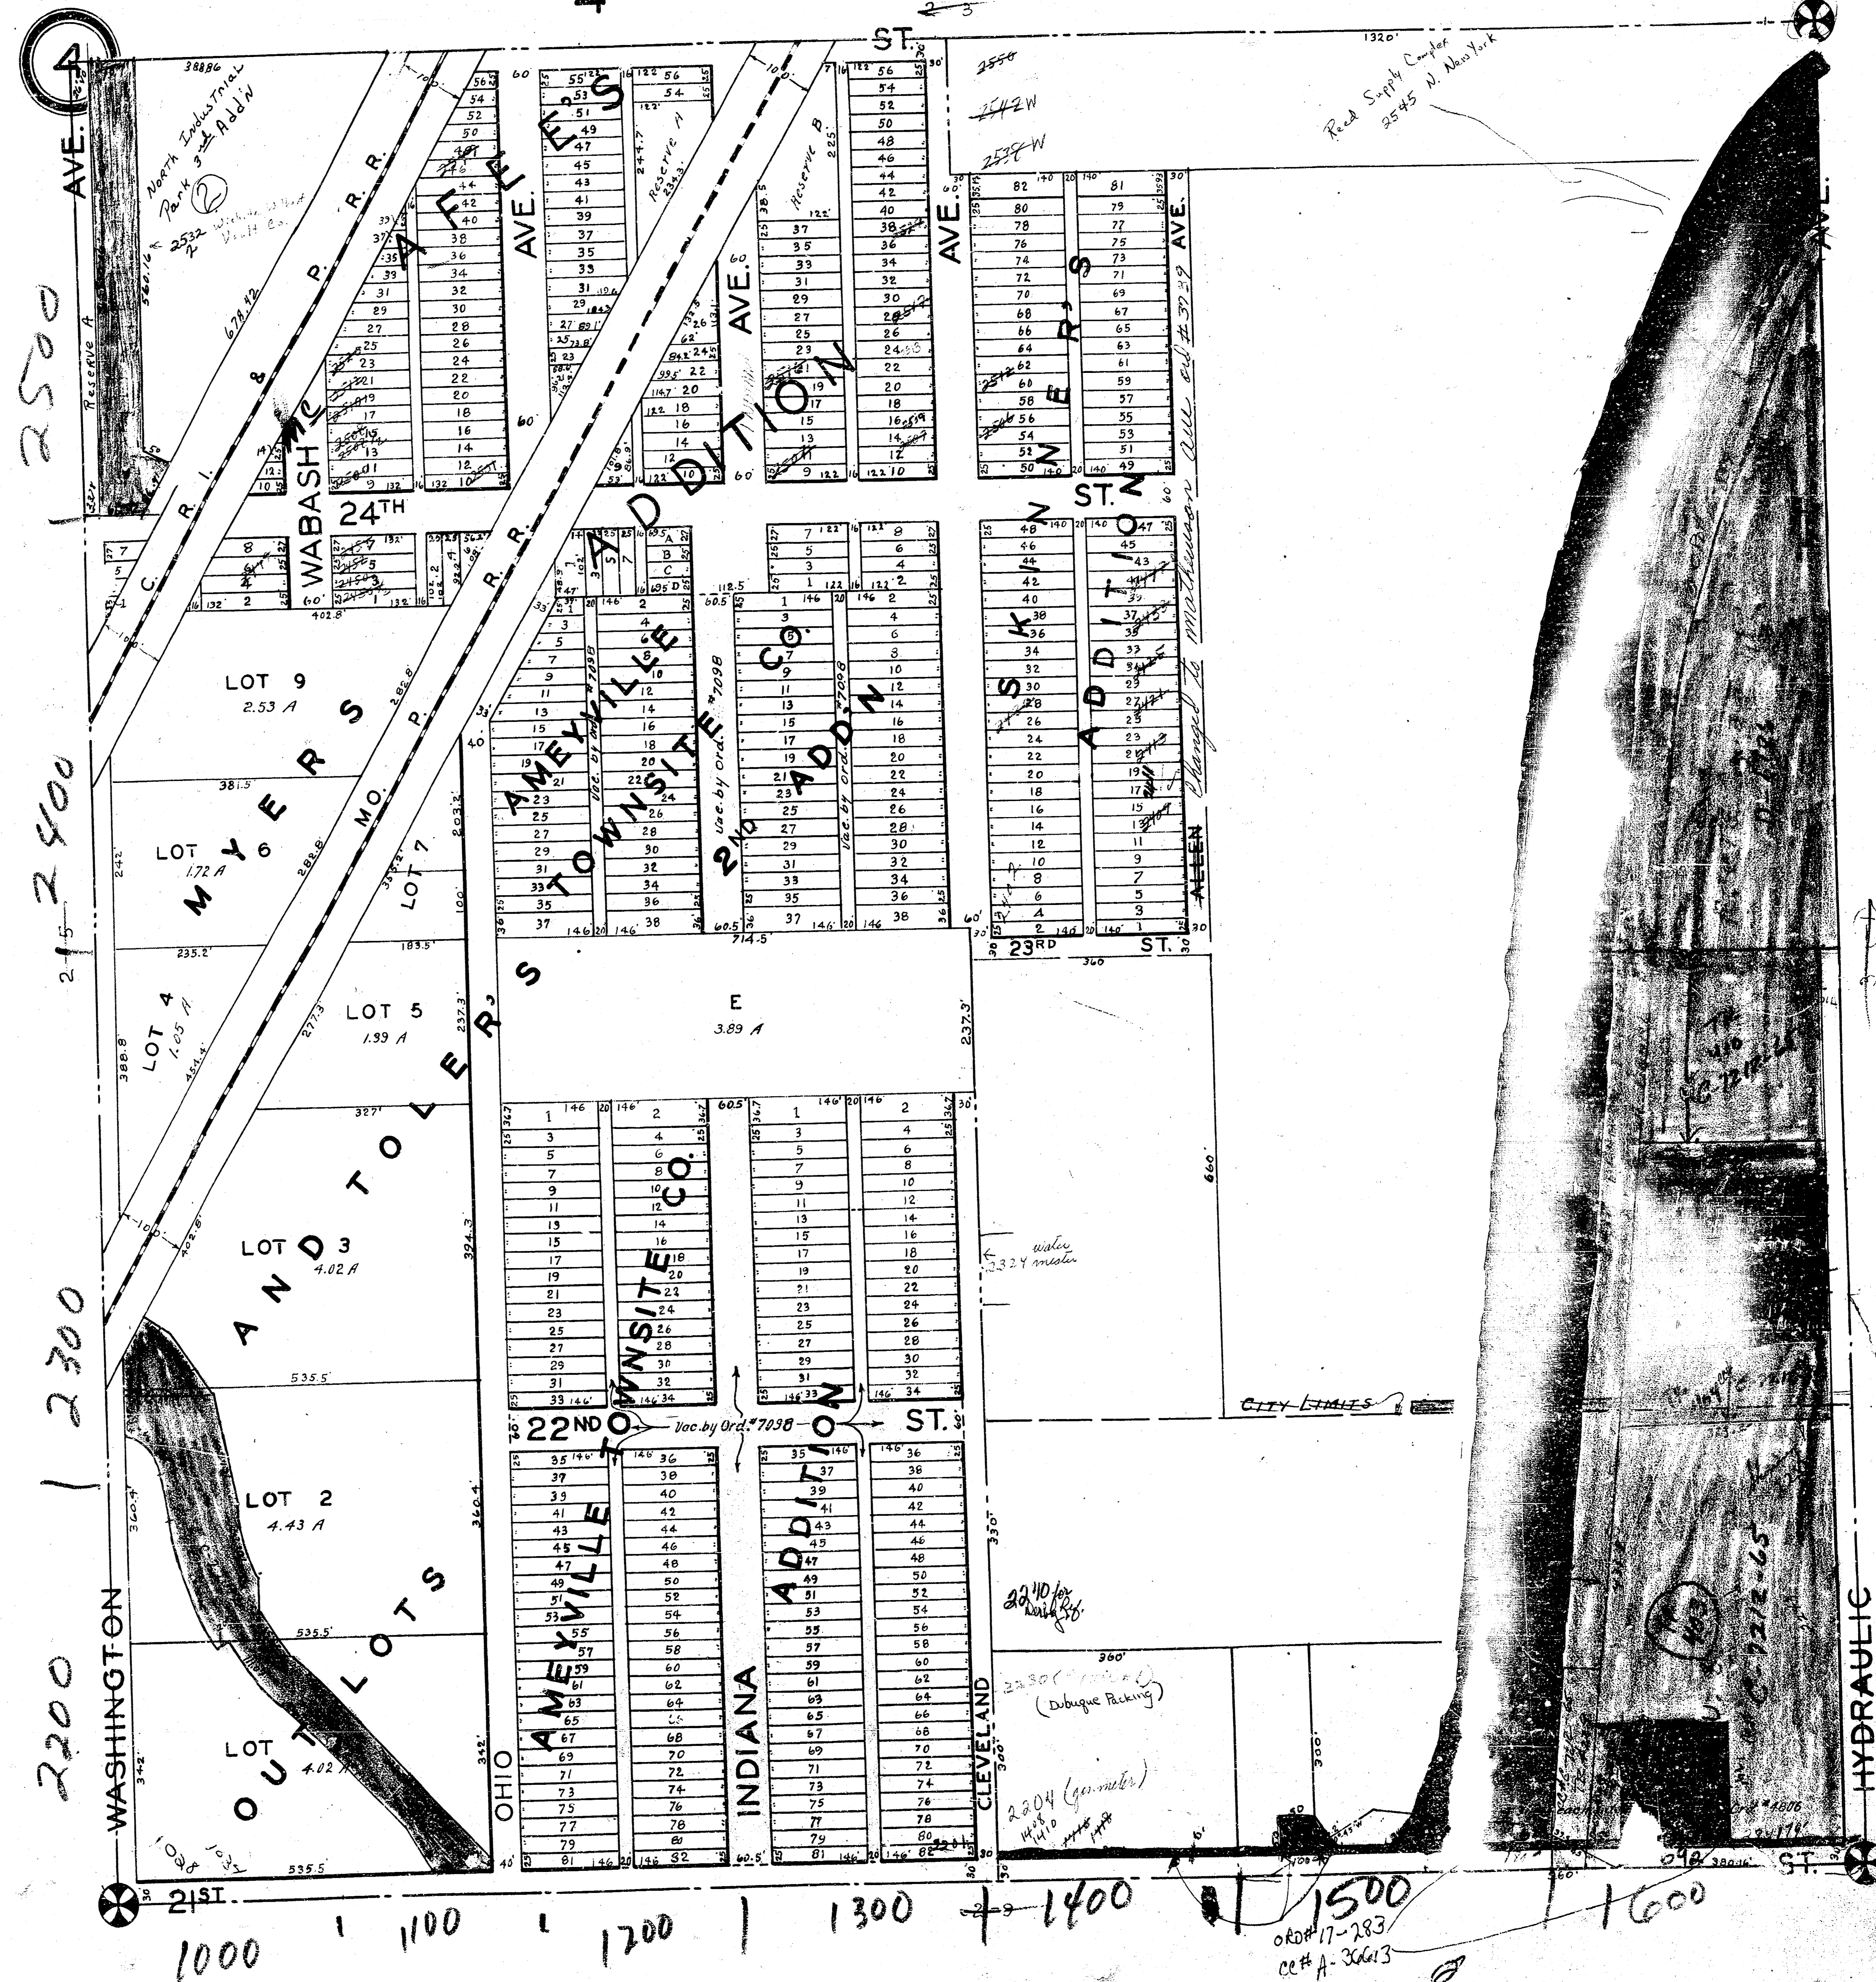

2500

215-2400

2300

2200

1000

1100

1200

1300

1400

1500

1600

OKD#17-283
CE#A-30613