


# S.W. 1/4 SEC. 9 TWP. 27 R.1E.

9-41

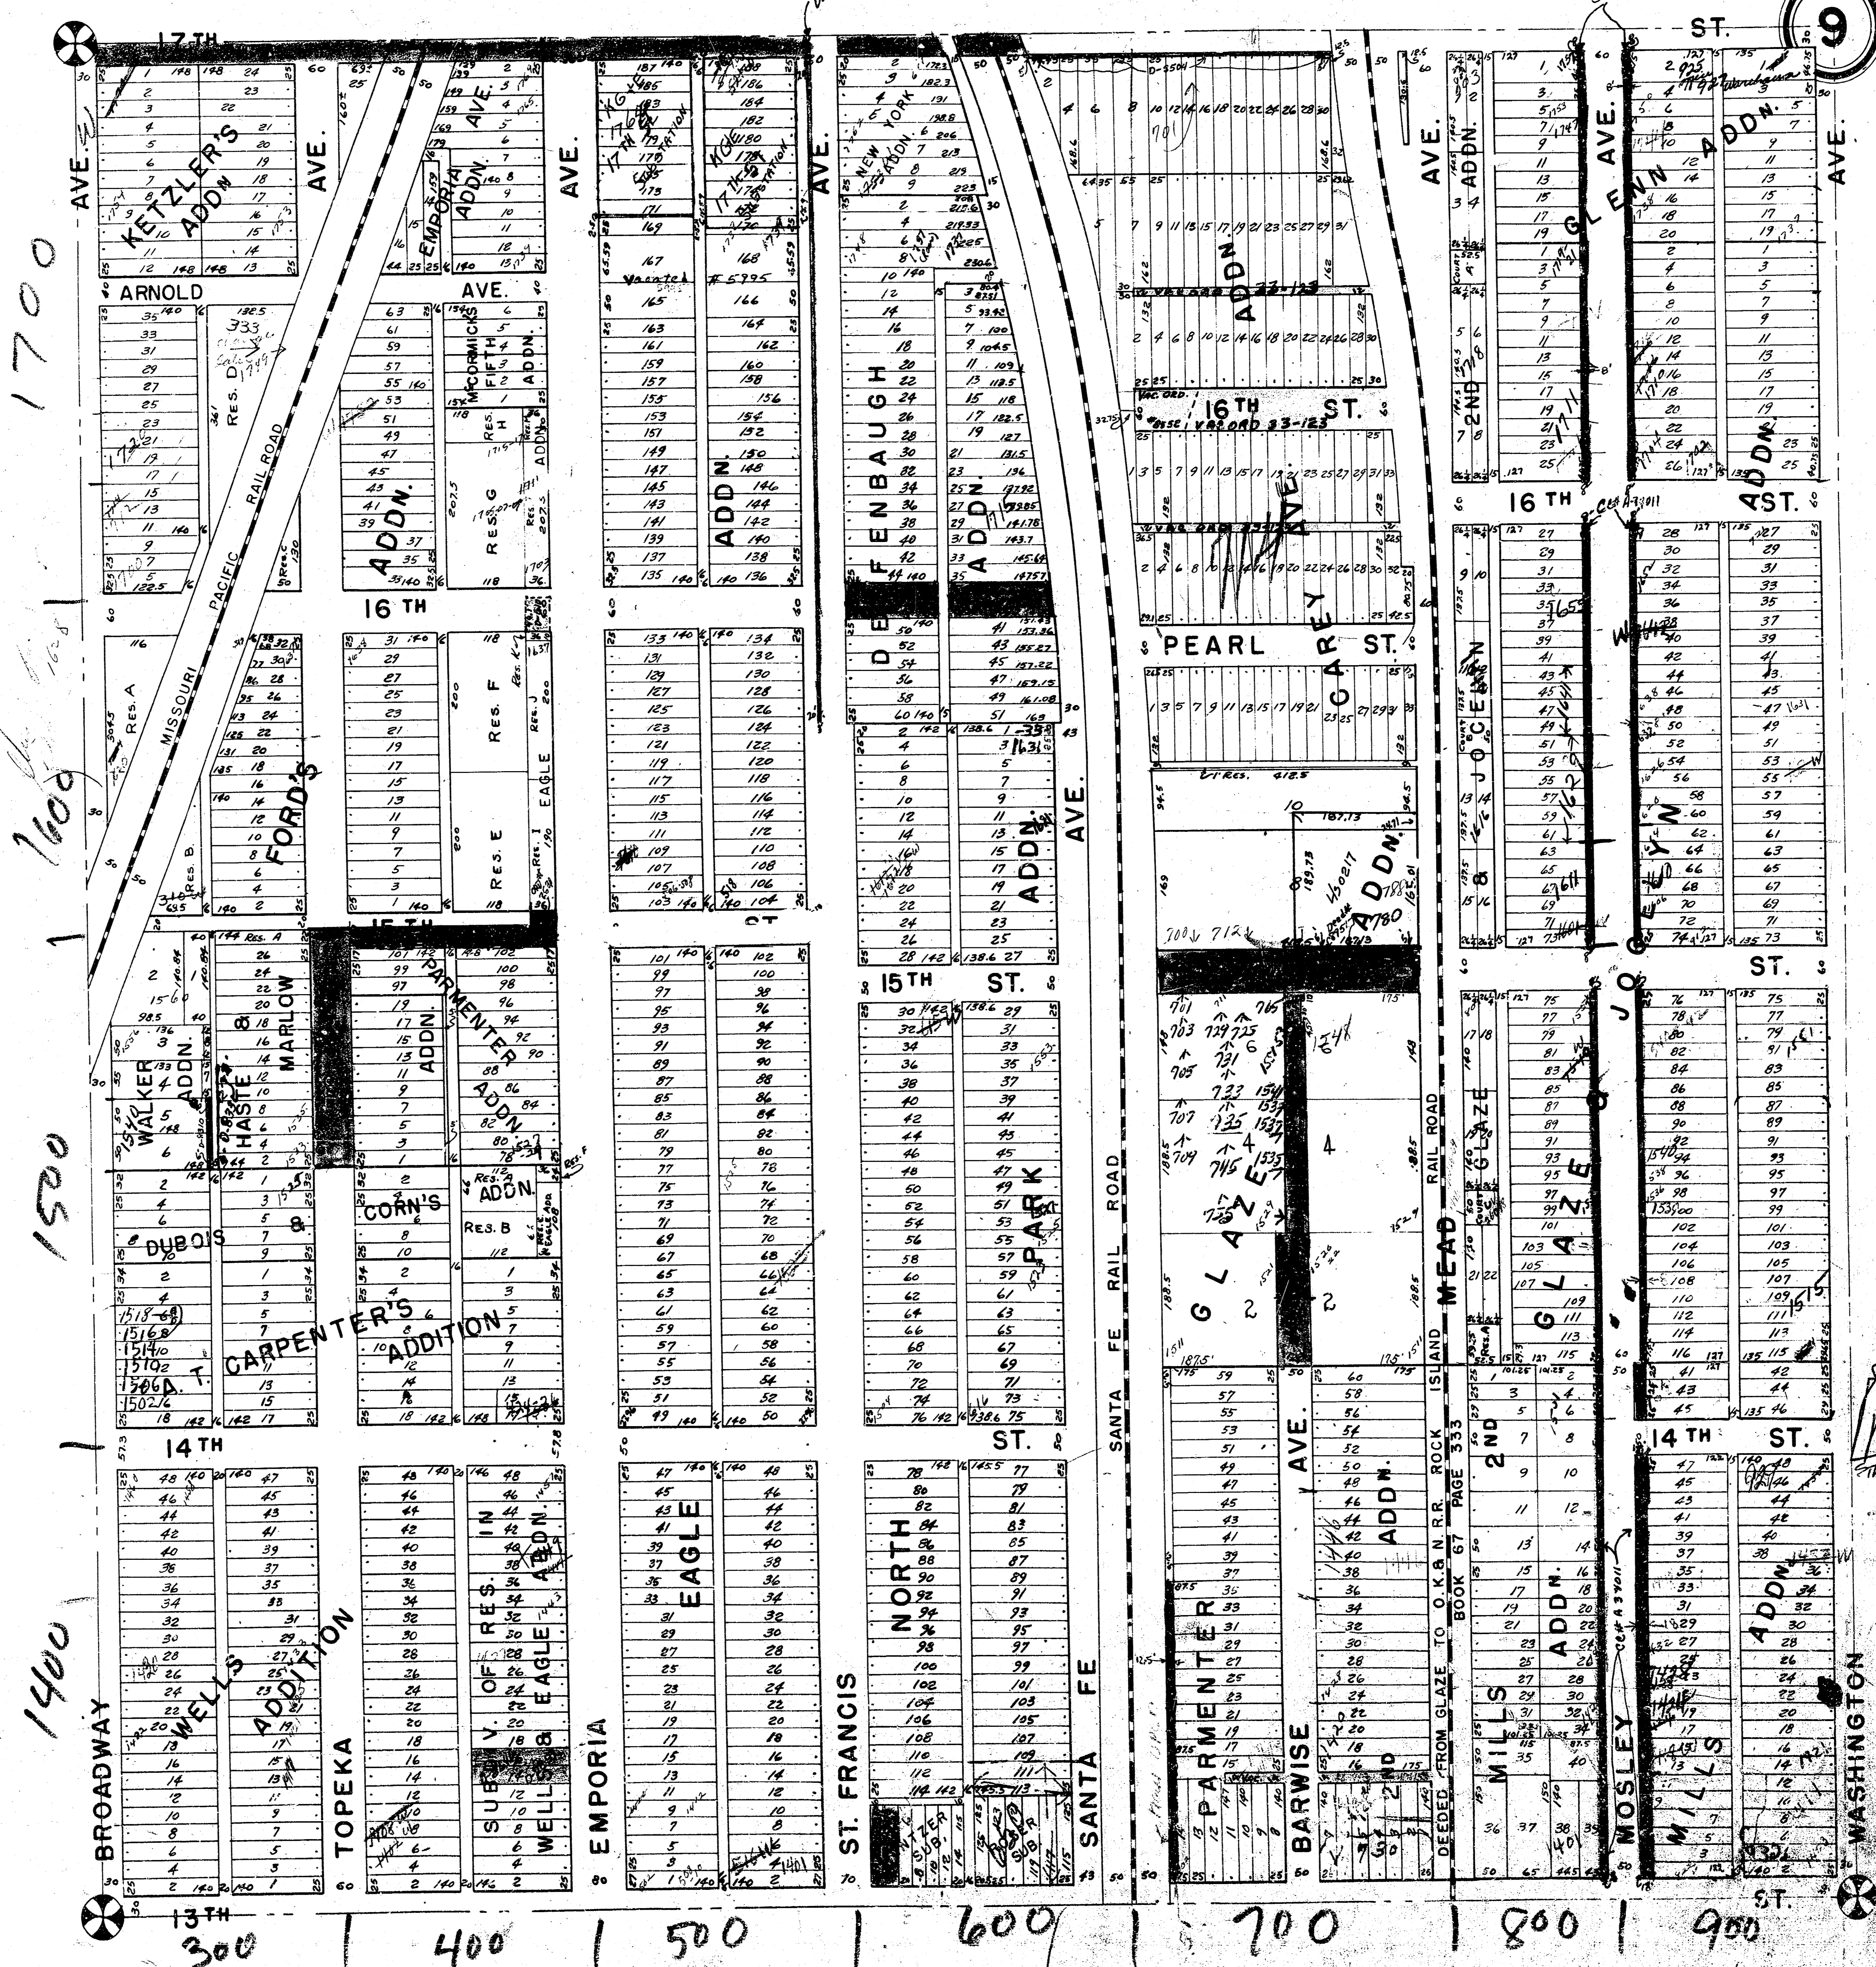

1700

1600

1500

1400

300

400

500

600

700

800

900

9

START

WASHINGTON