


S. E. 1/4 SEC. 9 T. 27 S. R. 1 E.

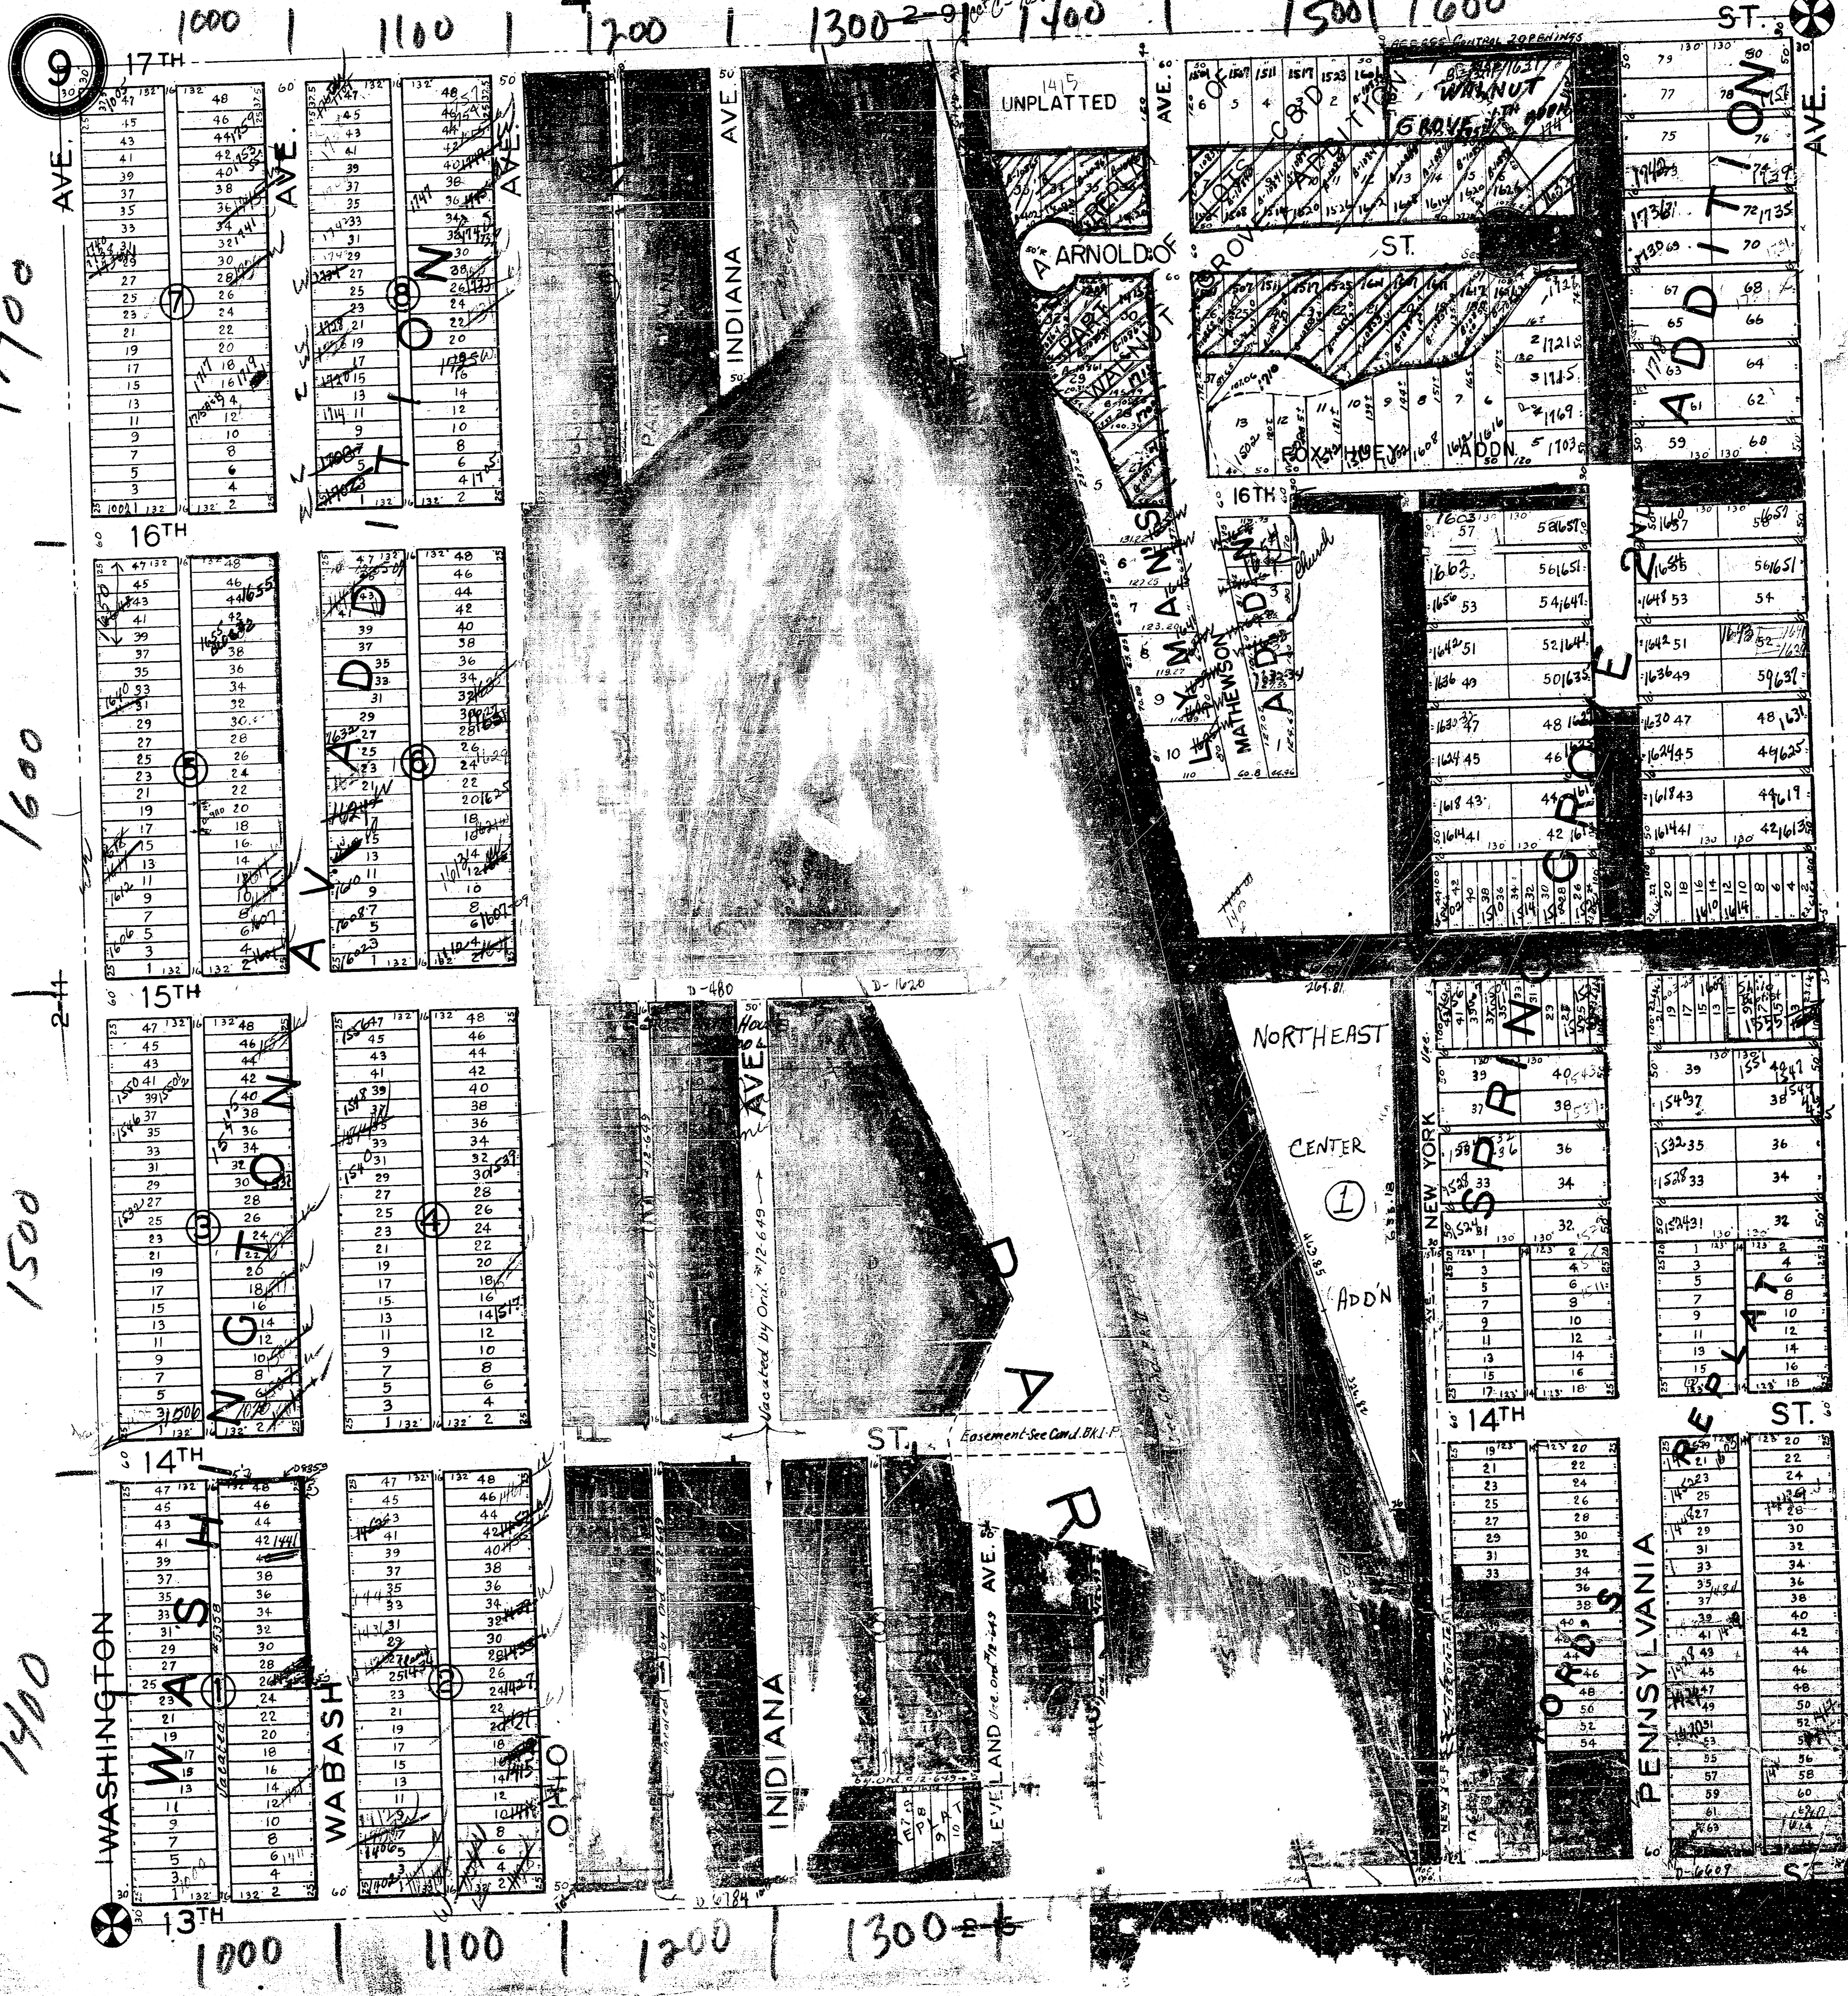

1700
1600
1500
1400

1000 | 1100 | 1200 | 1300 | 1400 | 1500 | 1600

1000 | 1100 | 1200 | 1300

3-4