S.W. 1/4 SEC. 16 TWP. 27 R.I.E
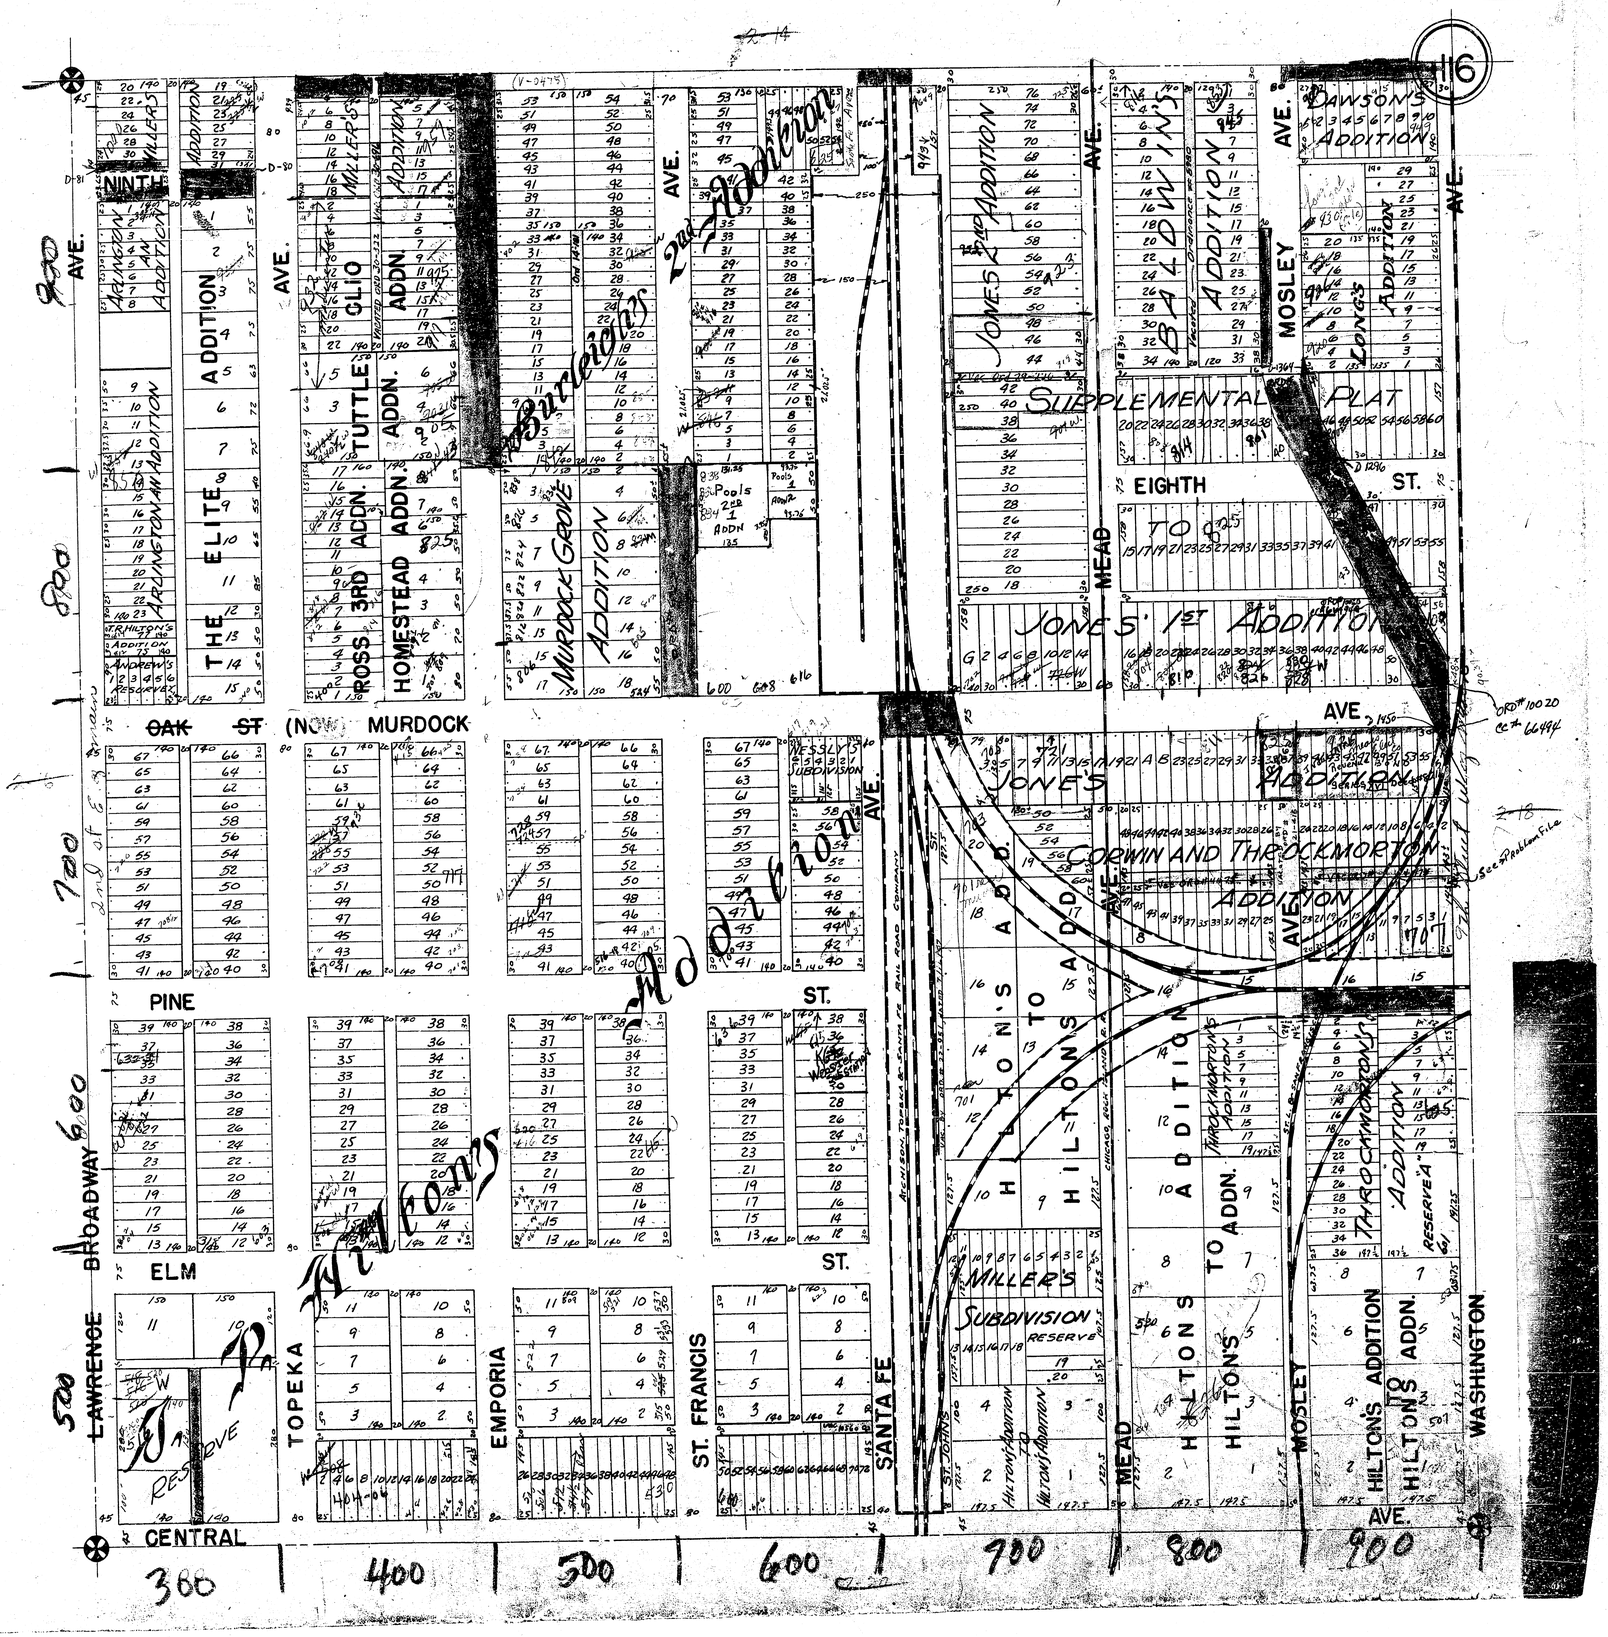
9-47