


SE. 1/4, SEC. 16, TWP. 27, R. 1 E.

9-48

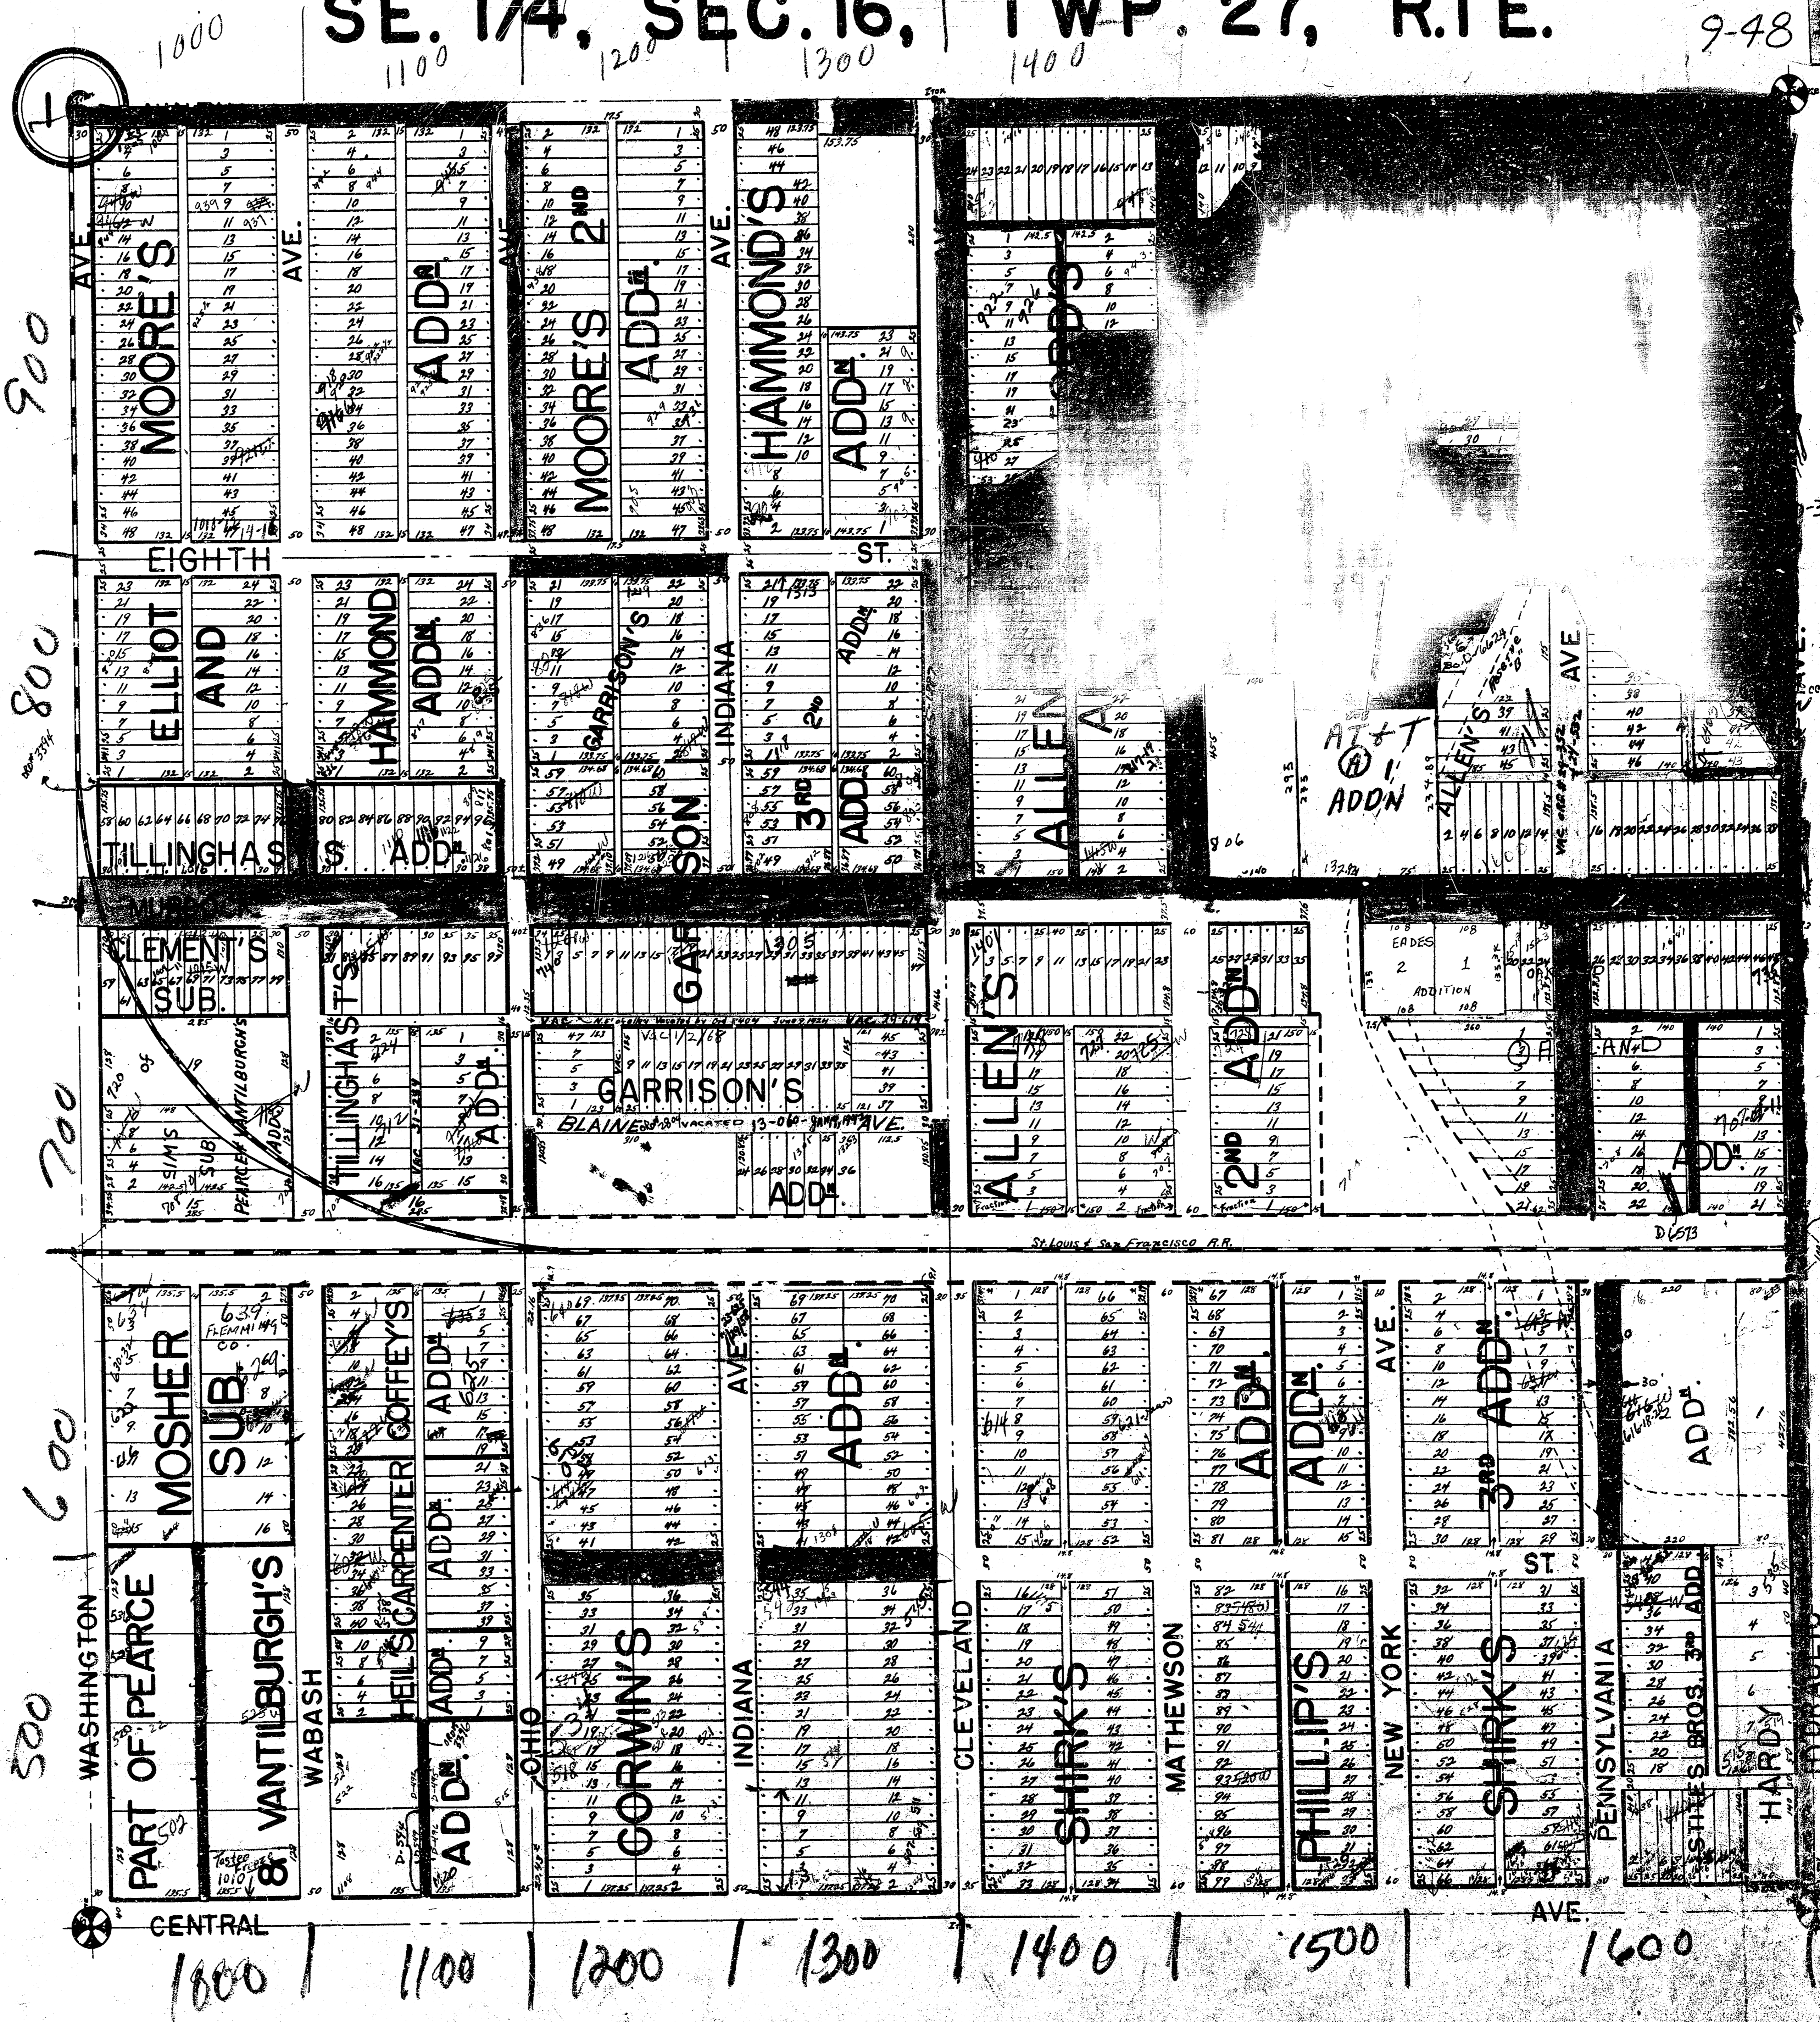

900

800

700

600

500

1000

1100

1200

1300

1400

1000

1100

1200

1300

1400

1500

1600