


Deed BK M 185 P 506
C6# A-14905
ORD# 14-052

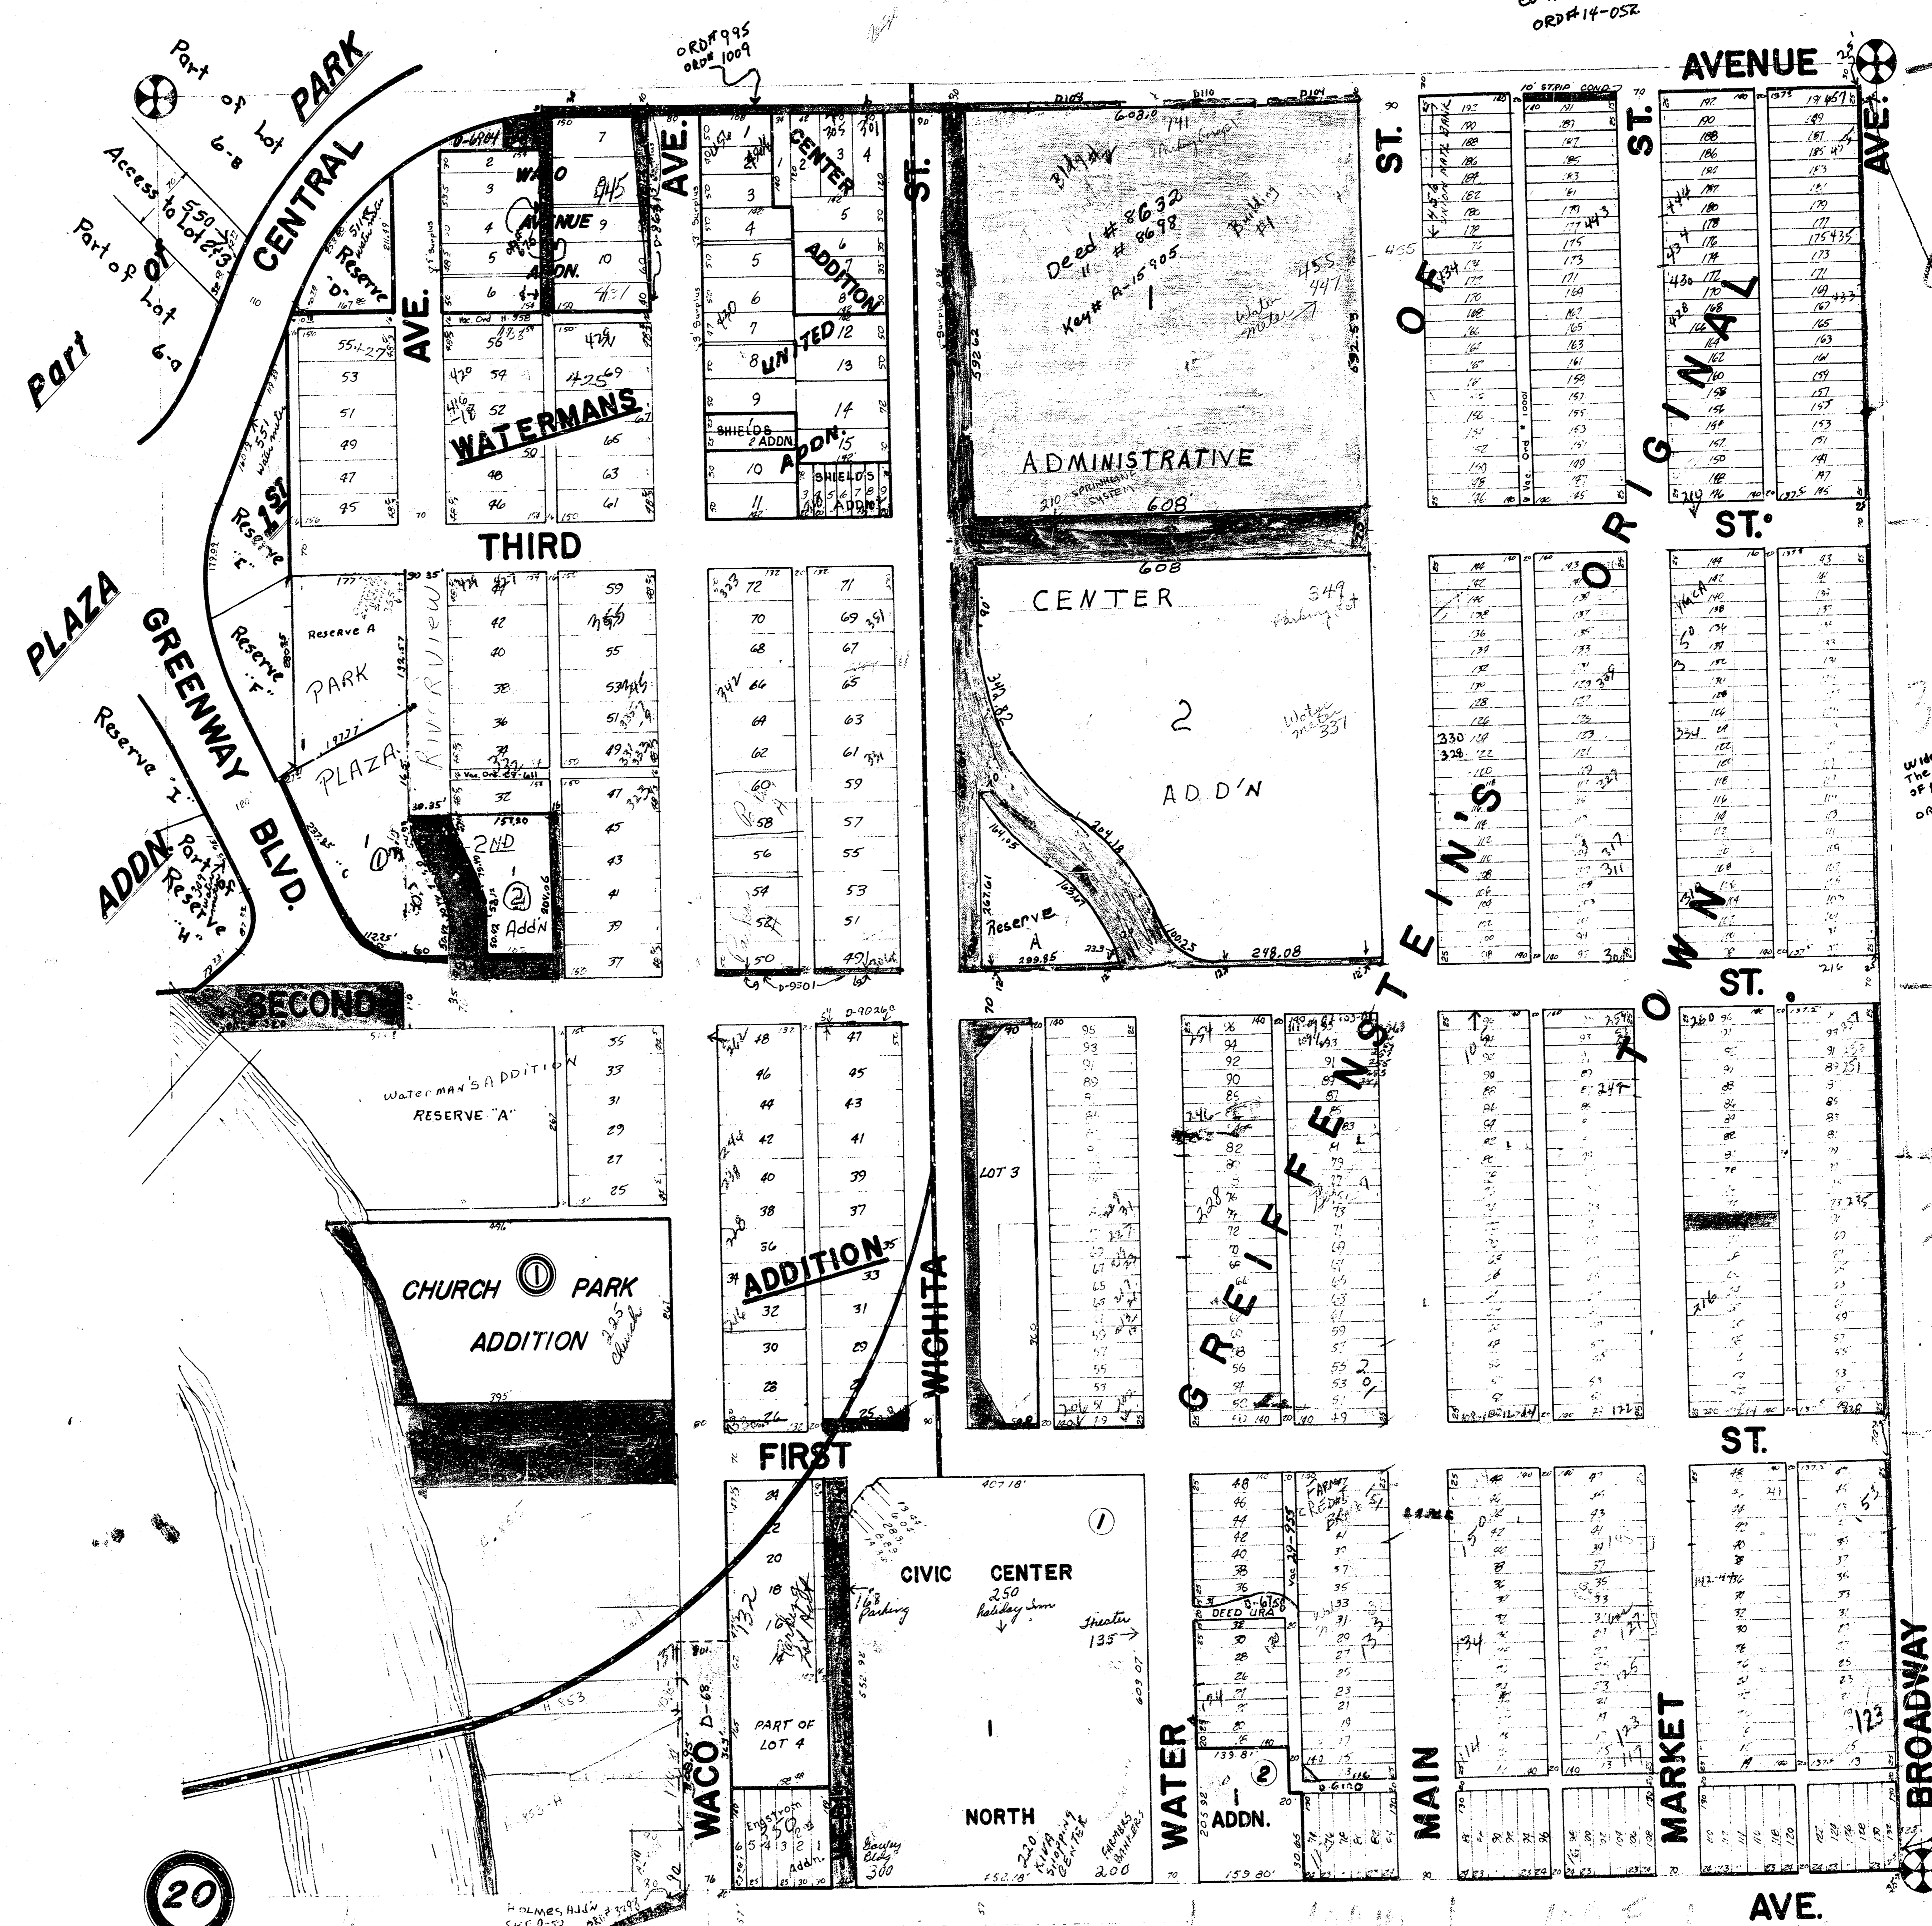

WIDENING OF BROADWAY
THE N.W. CORNER OF THE E. 20'S
OF NE 1/4 SEC. 20
ORD# 231, Feb 12, 1880

20

DUGLAS