


S.W. 1/4 SEC. 21, TWP. 27, R.1.E.

9-53
900

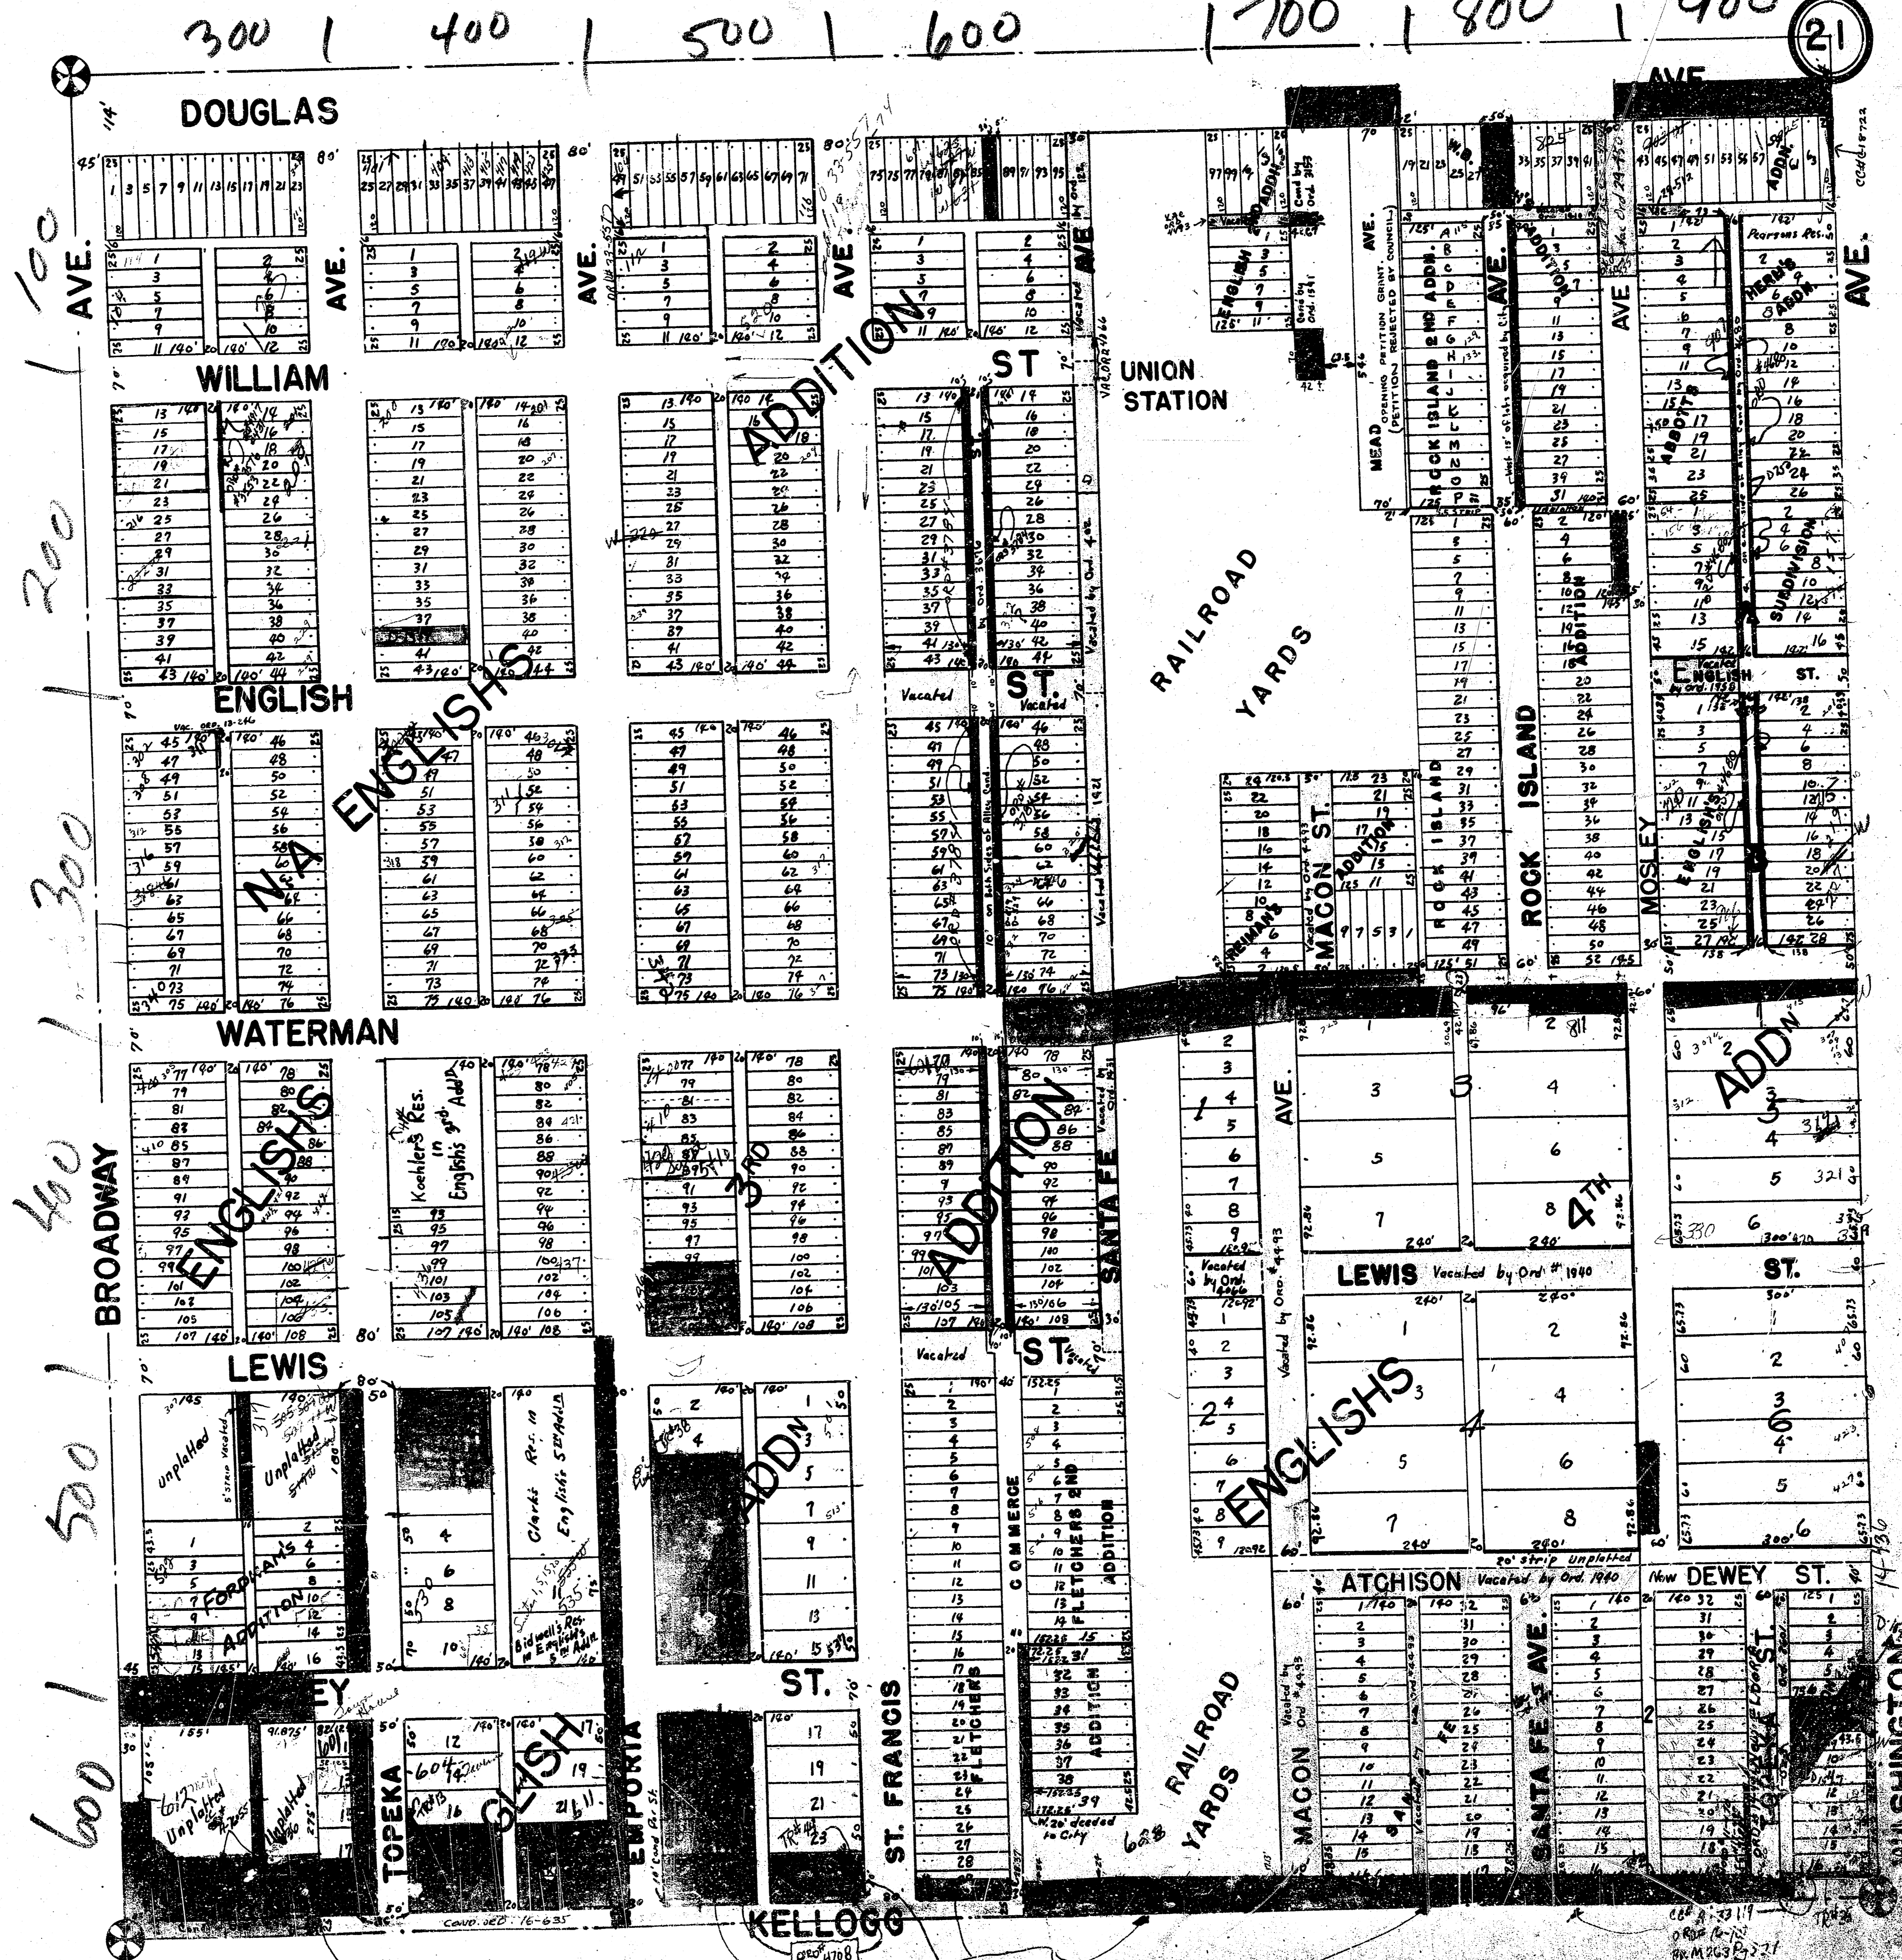

300 | 400 | 500 | 600 | 700 | 800 | 900

100 | 200 | 300 | 400 | 500 | 600

21

ORD 16-685
