


SW. 1/4 SEC. 28 TWP. 27 R. 1 E.

9-59

28

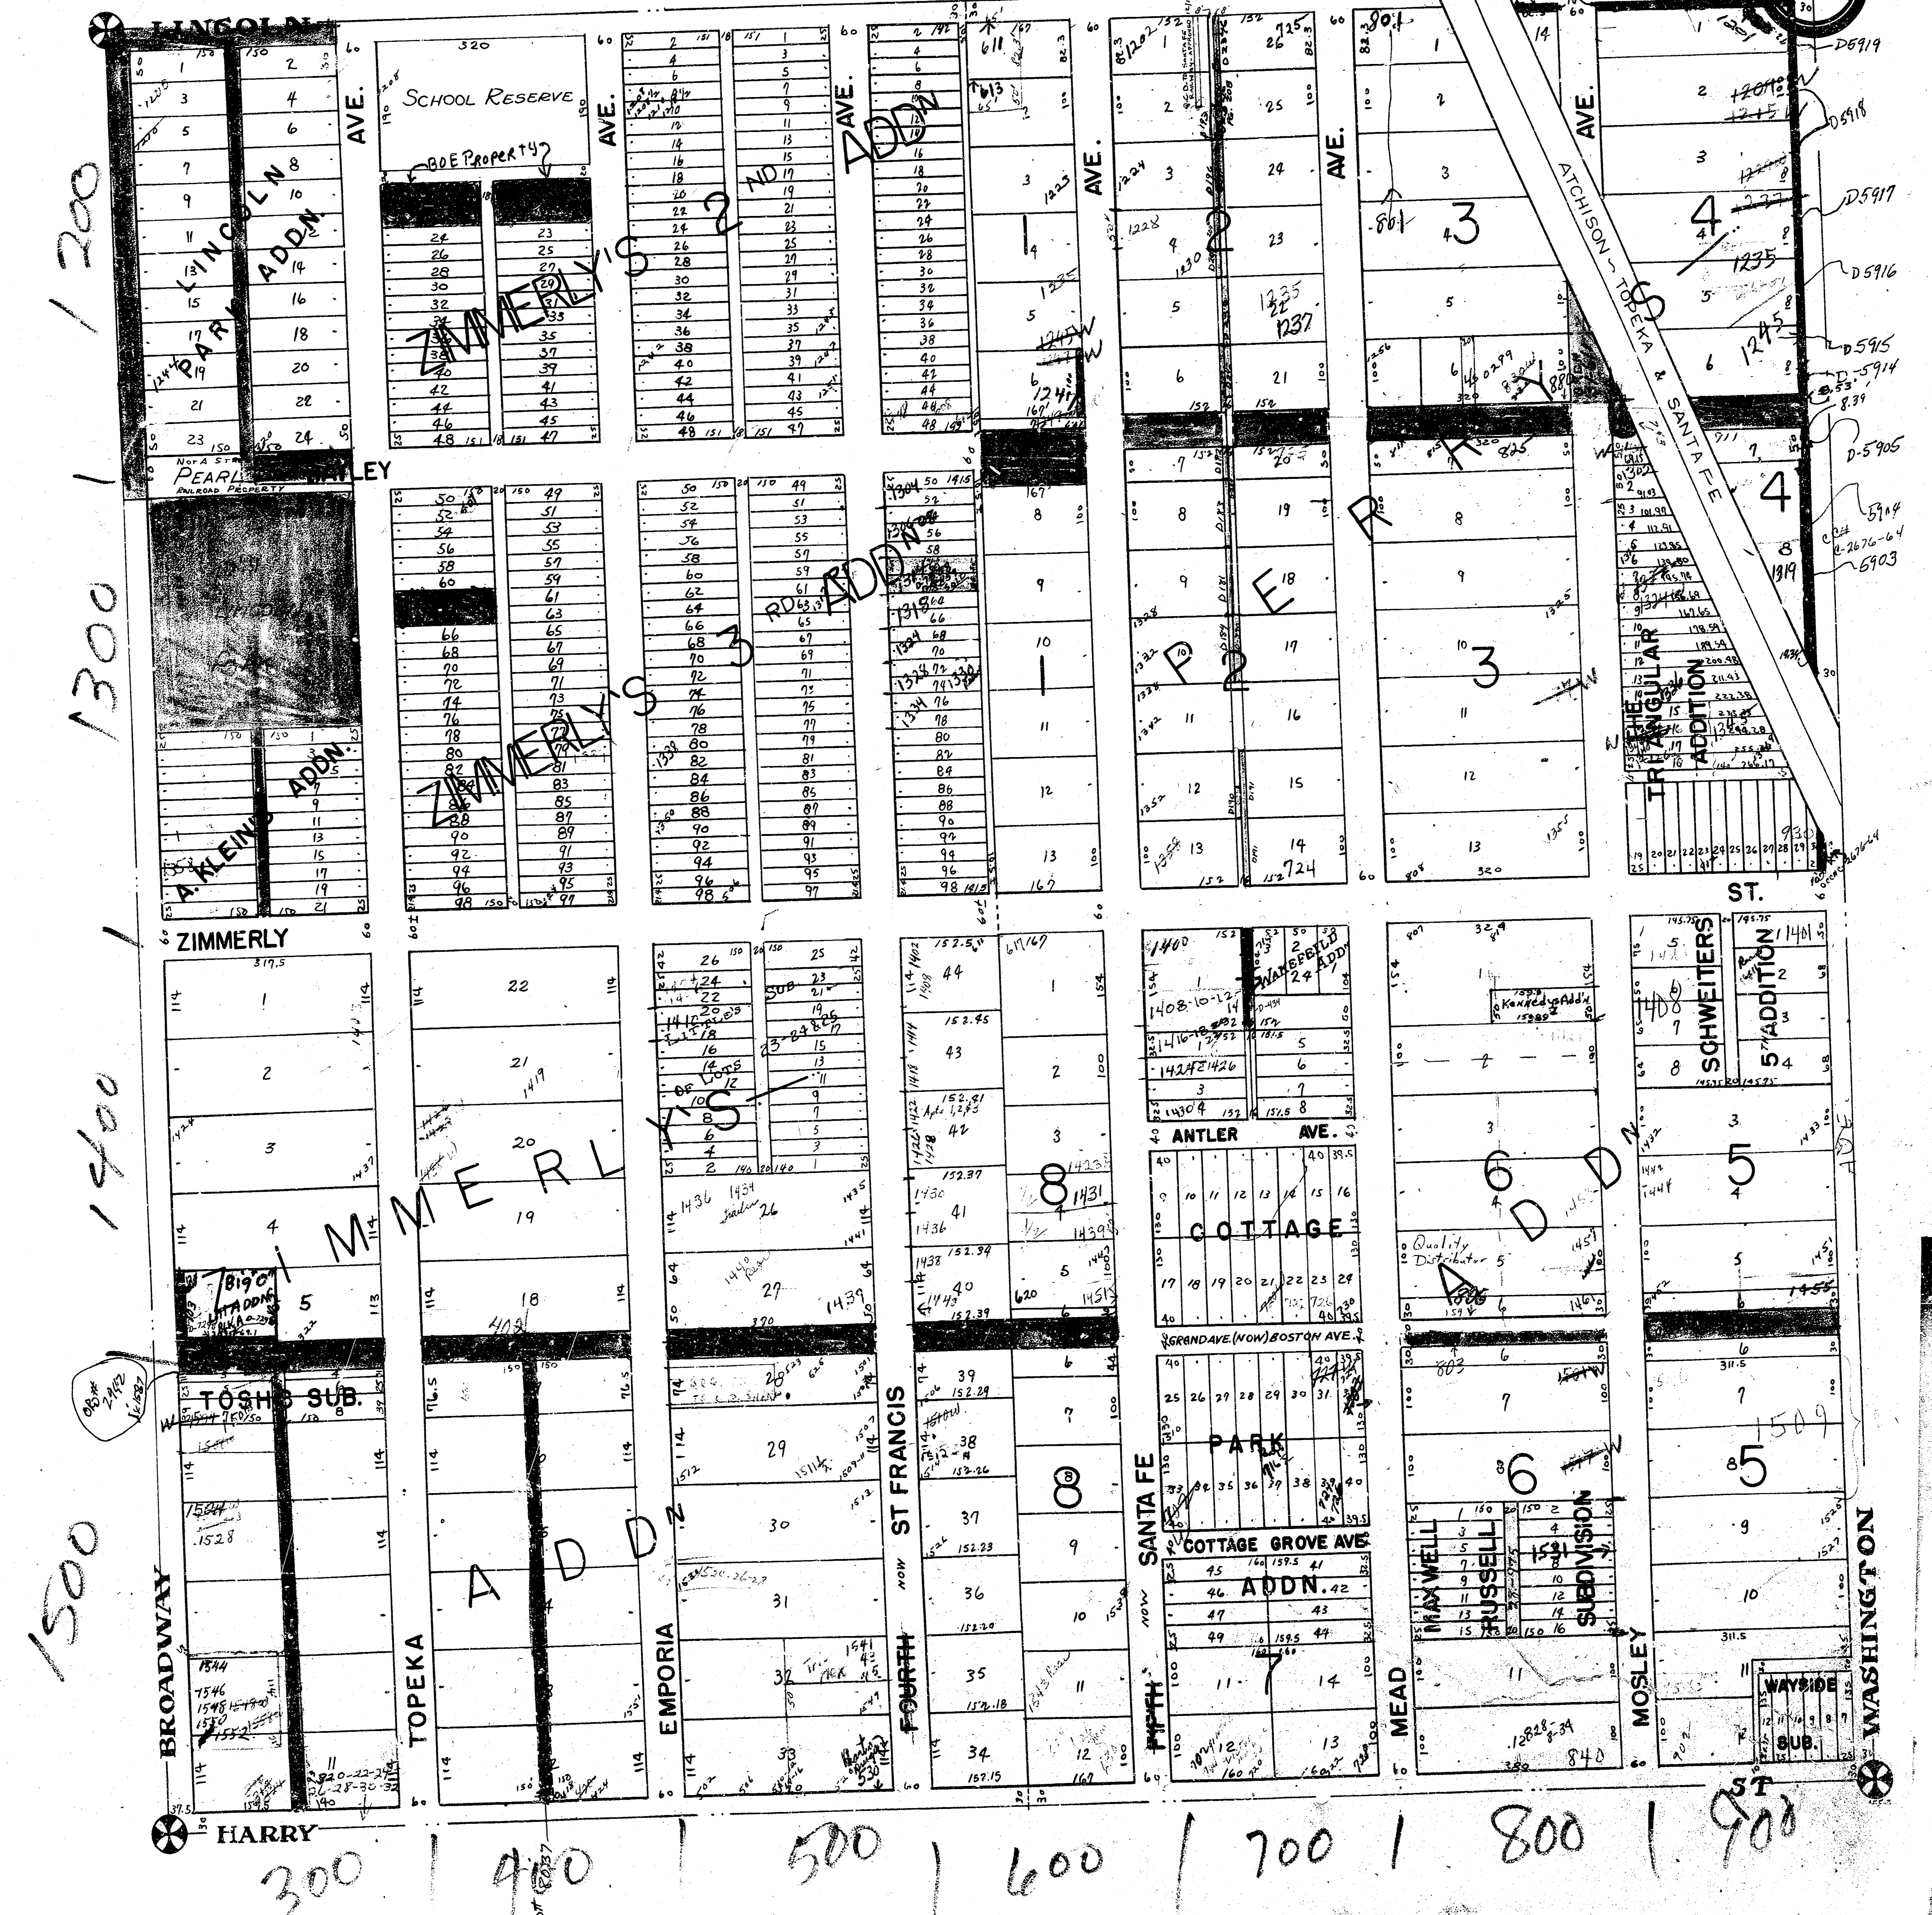

1200
1300
1400
1500

300 | 400 | 500 | 600 | 700 | 800 | 900