


NE. 1/4 SEC. 33 TWP. 27 S. R. 1 E

9-63

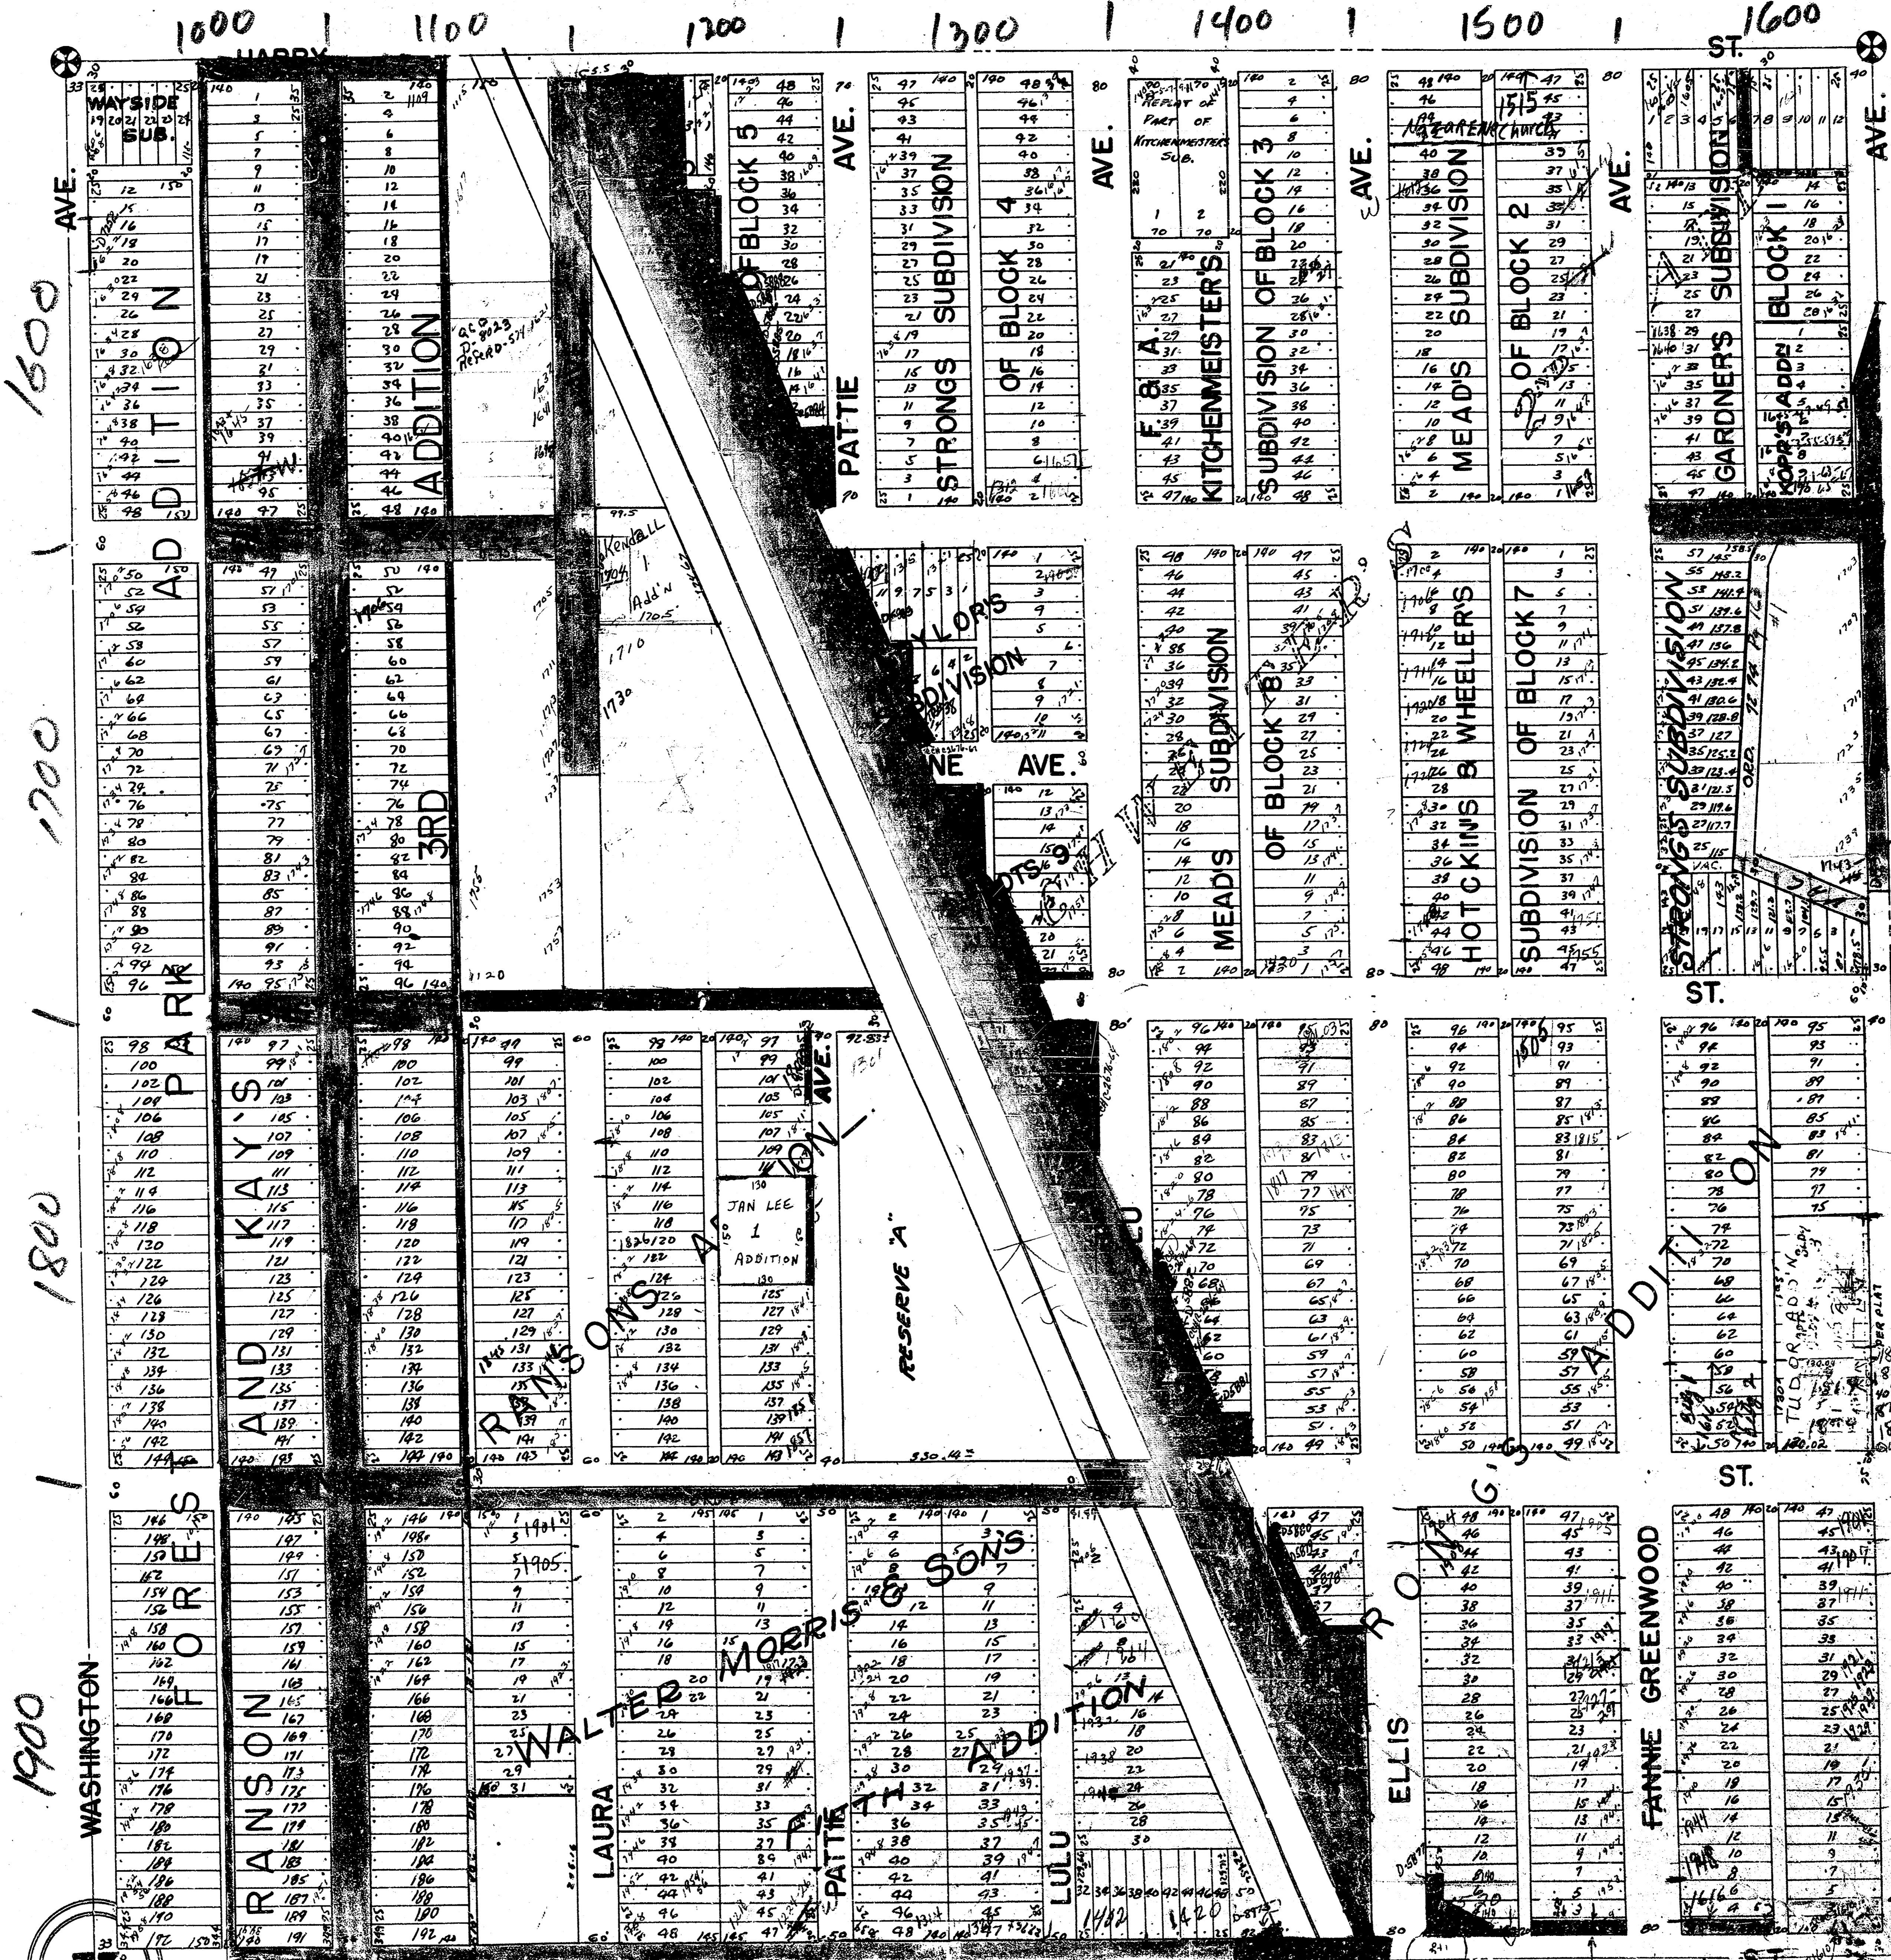

1600
1700
1800
1900

33

D-5876 0-9630