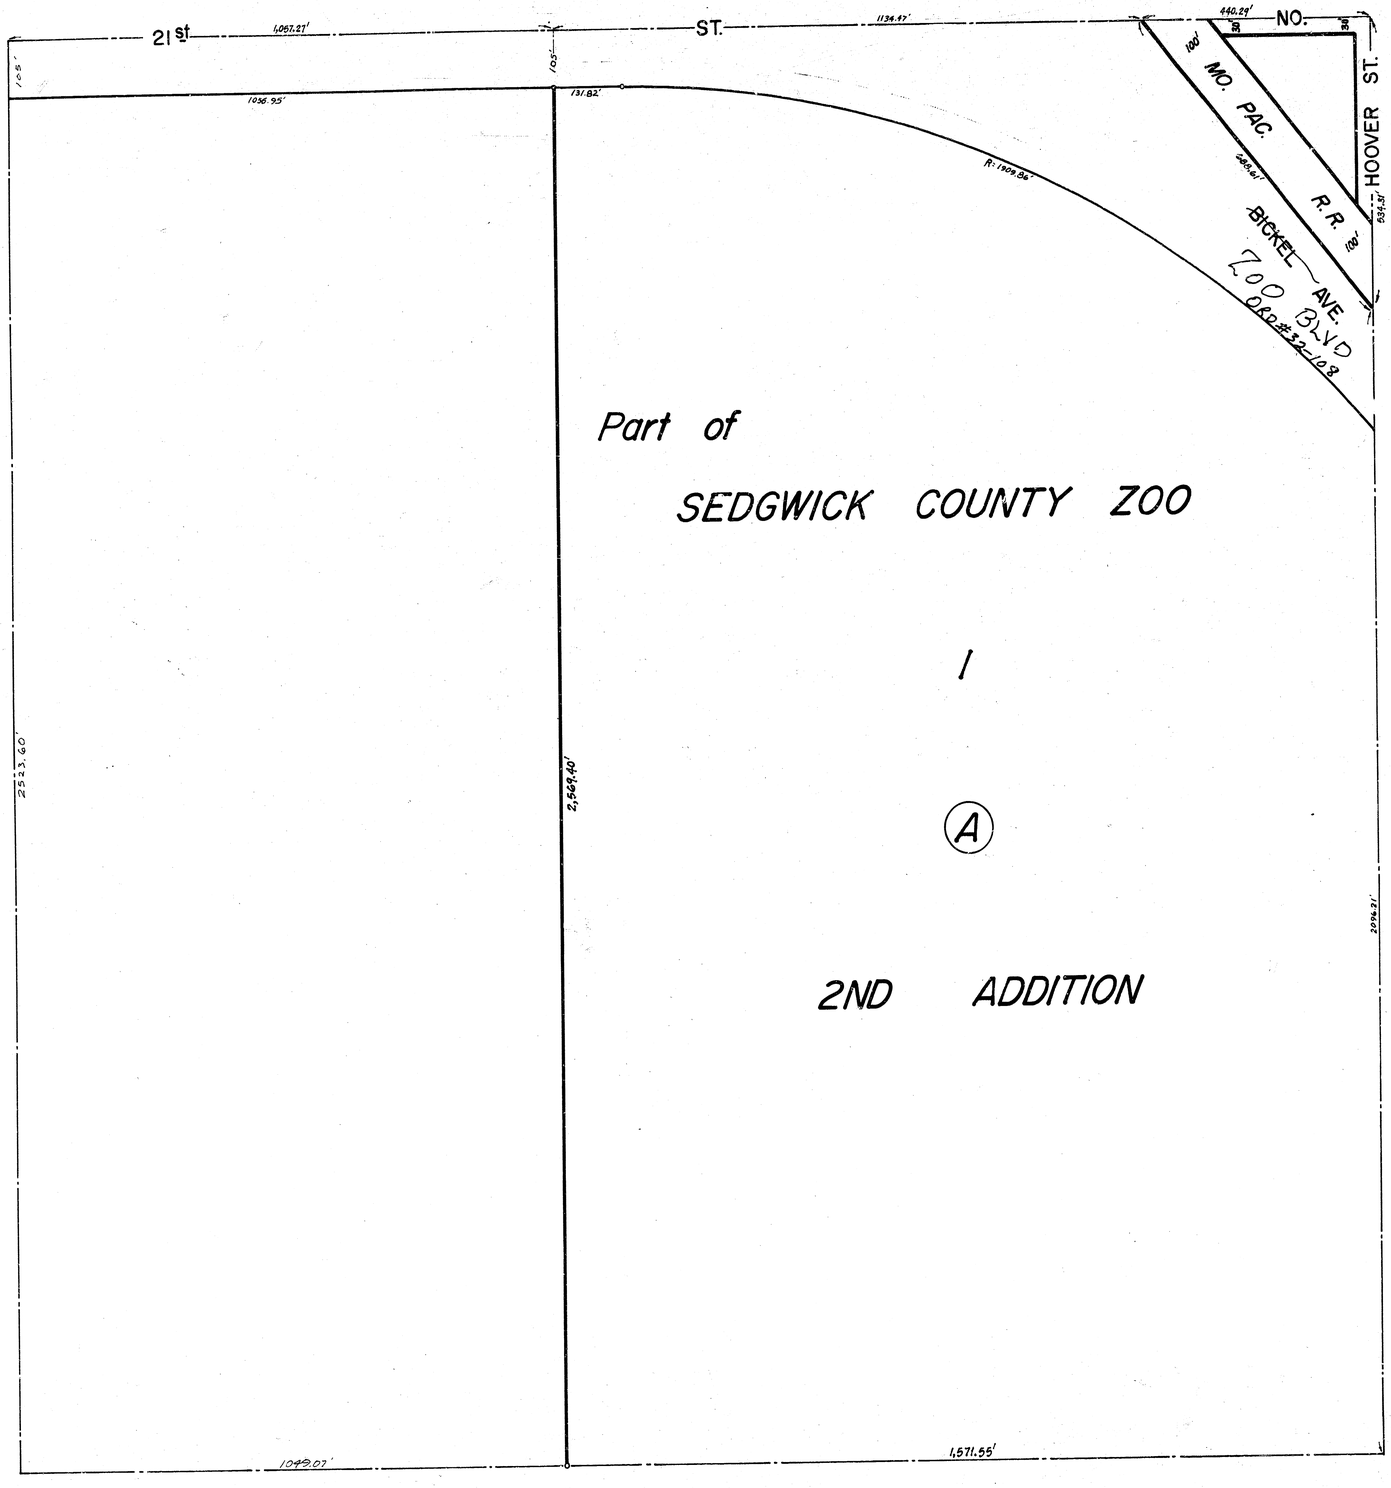
21st
1,067.27'
ST.
1134.47'
440.29'
NO.
100'
MO. PAC.
R.R.
HOOVER ST.
BICKEL AVE.
ZOO BLVD
Bd. #32-108
105'
1056.95'
131.82'
R: 1909.86'
Part of
SEDGWICK COUNTY ZOO
I
A
2ND ADDITION
2513.60'
2,569.40'
2094.21'
1049.07'
1,571.55'