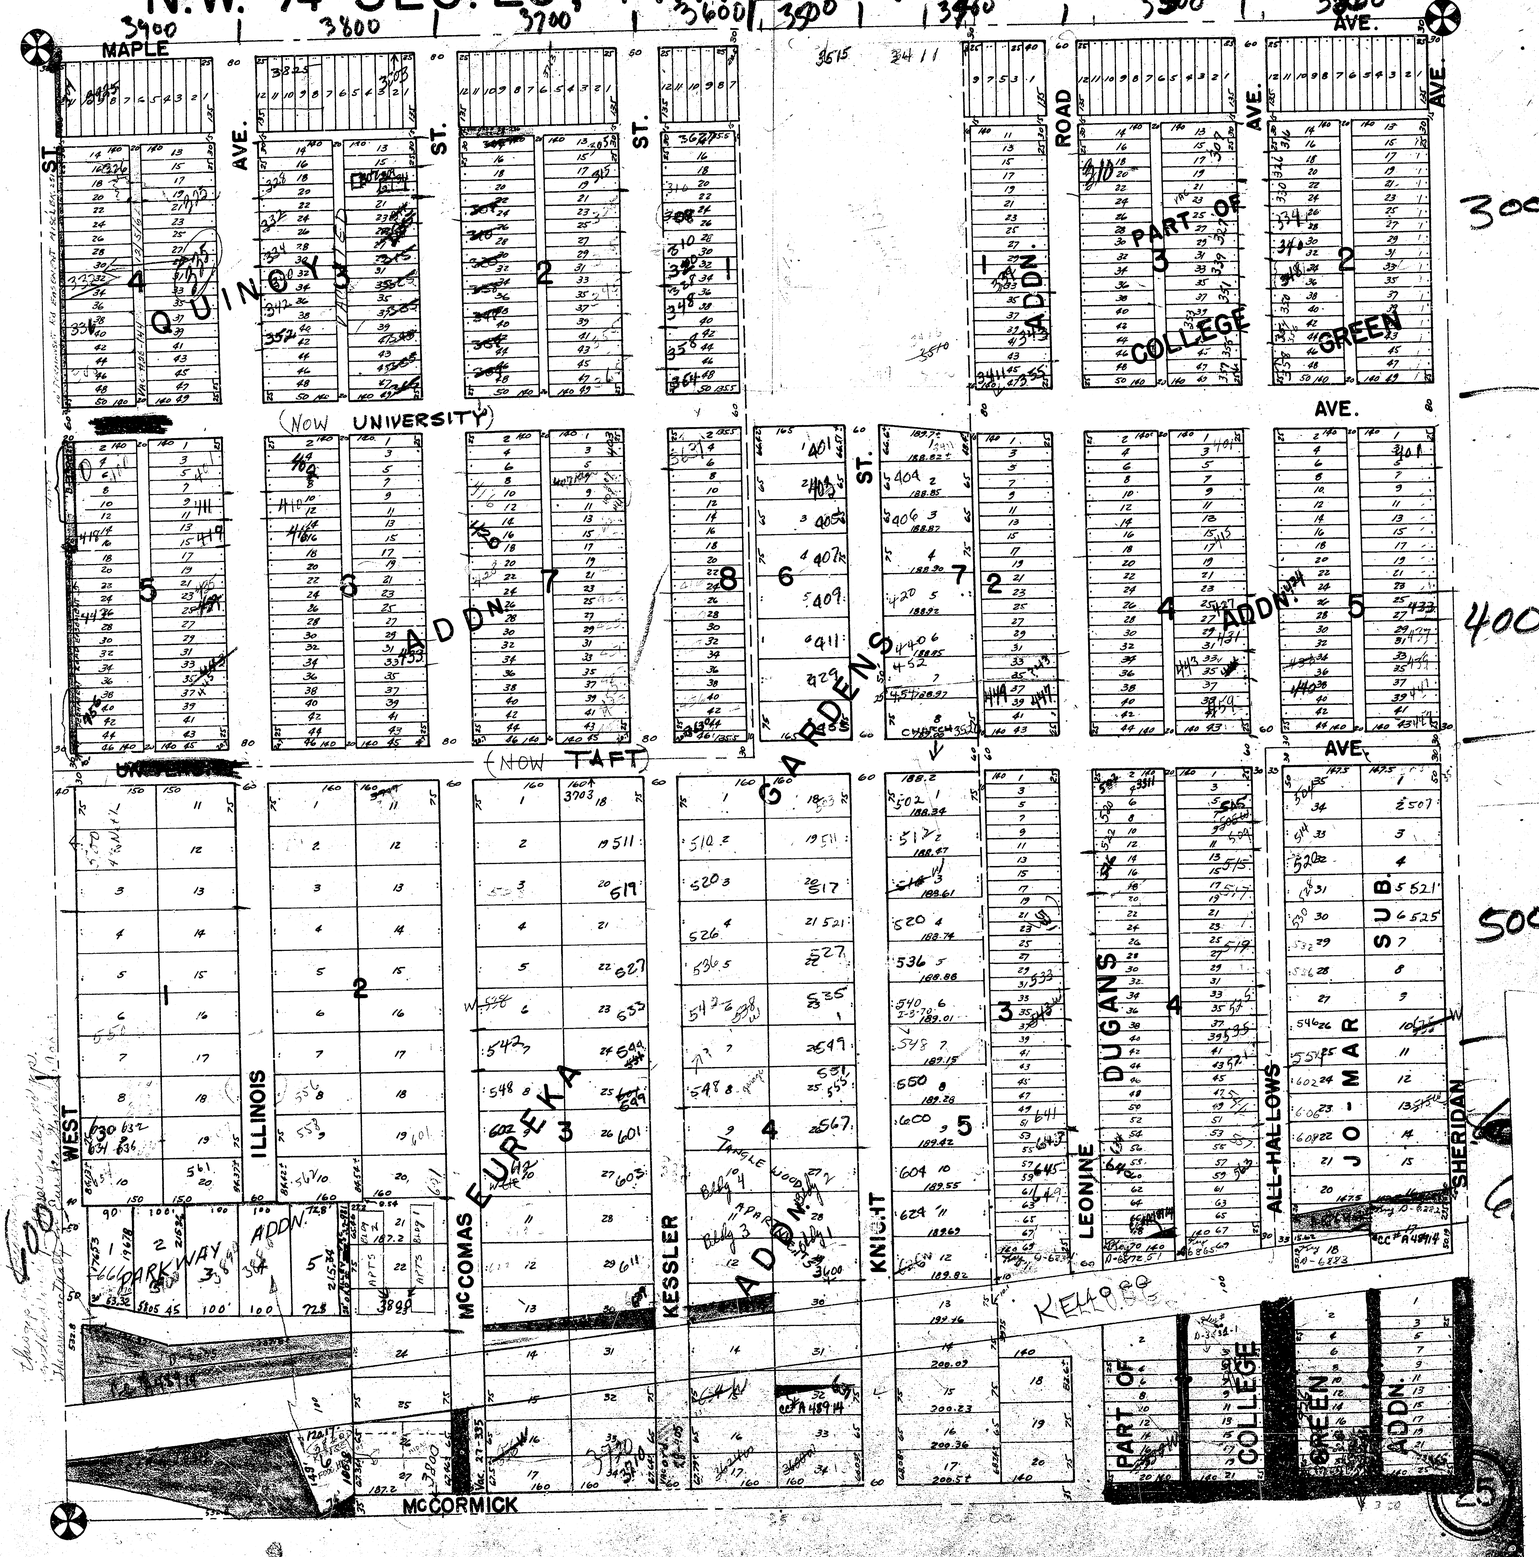N.W. 1/4 SEC. 25, TWP. 27S., R. 1W.