# S.W. ¼ SEC. 36, TWP. 27S., R. 1-W.
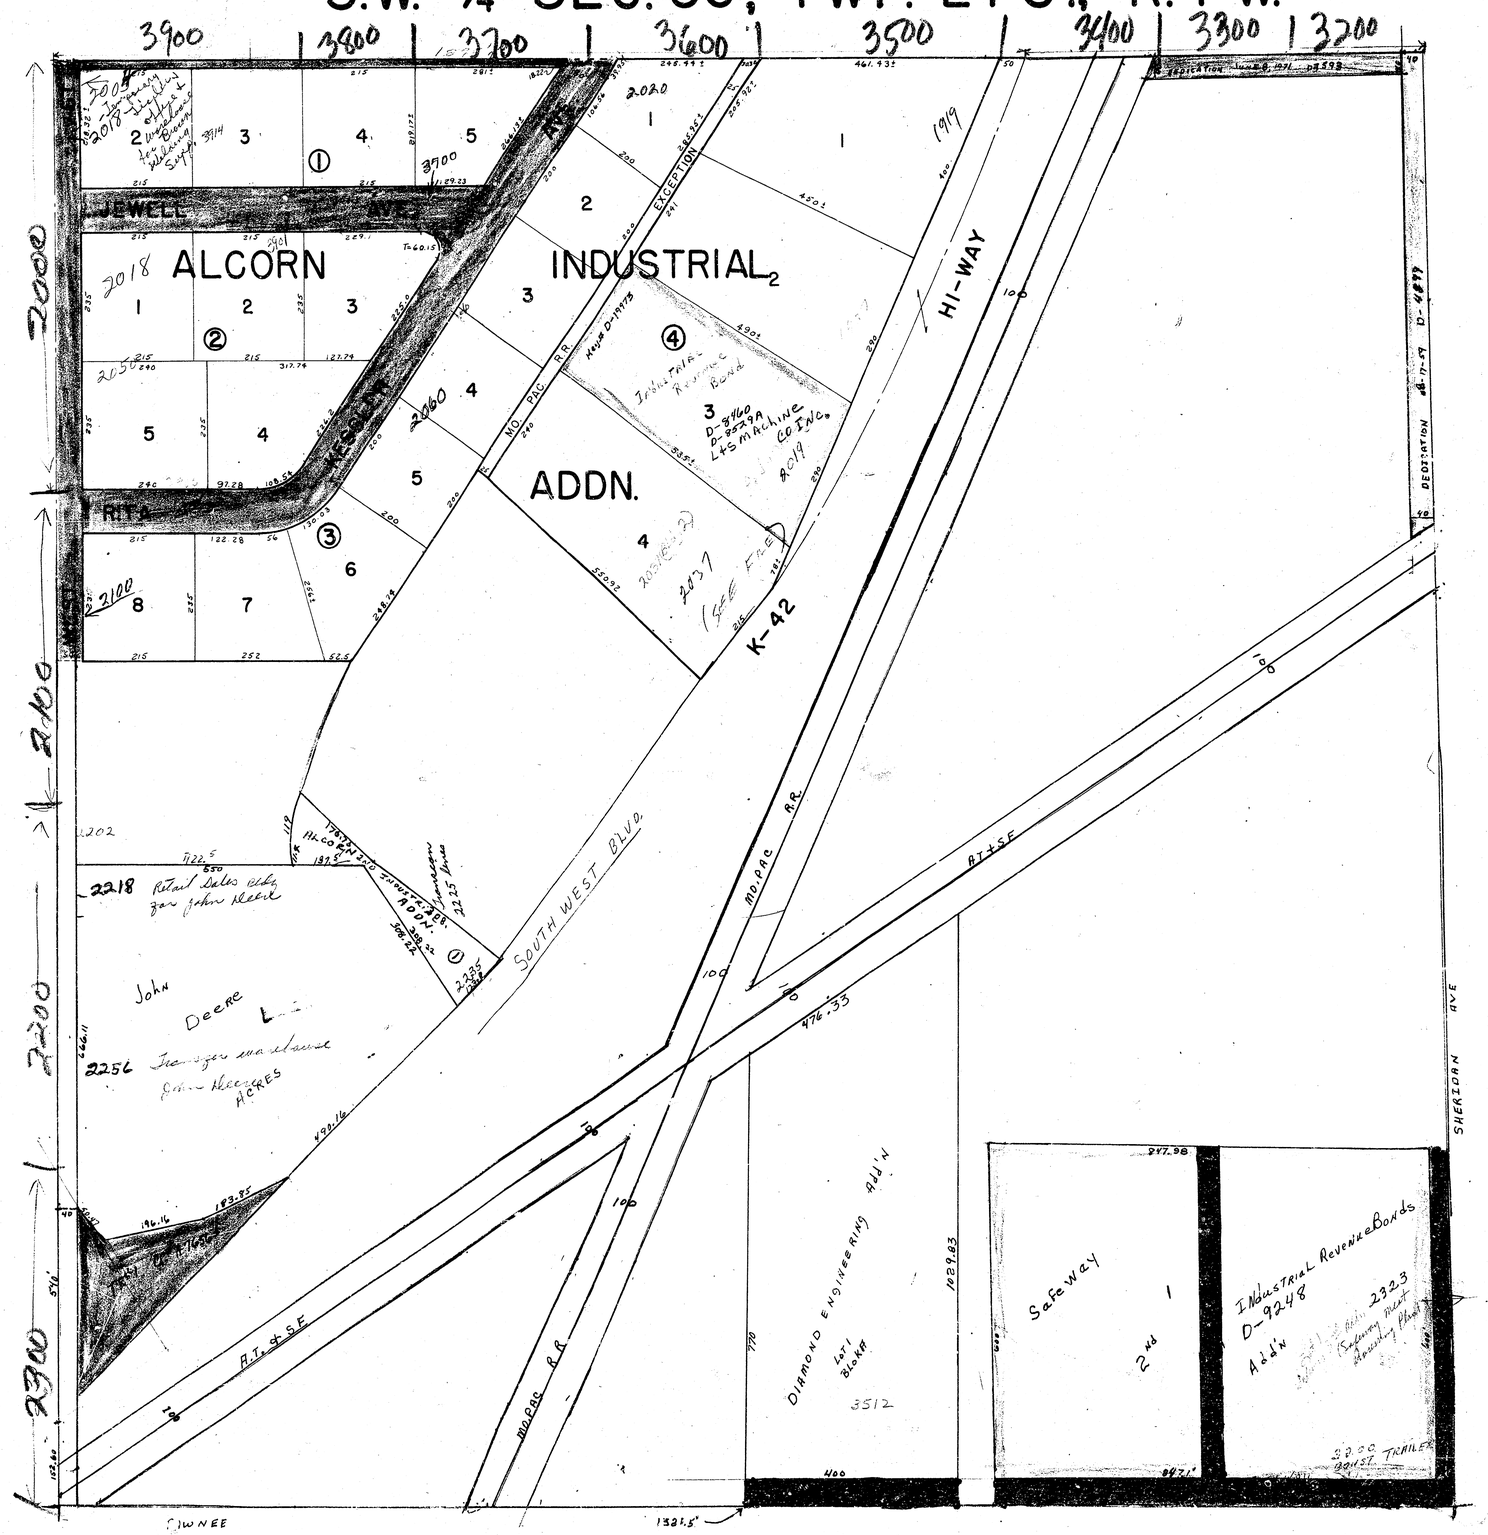
7-65